
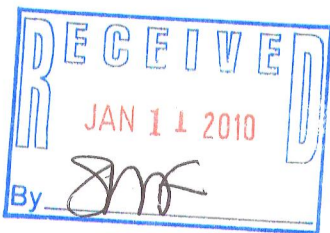


FARRIS, HANSEN & ASSOCIATES, INC.

ENGINEERING — ARCHITECTURE — SURVEYING
7 RIDGWAY COURT — P.O. BOX 437 — ELKHORN, WISCONSIN 53121
PHONE: (262) 723-2098 FAX: (262) 723-5886

— WORK ORDERED BY —
FARLEY NESHEK REALTY CORPORATION
PO BOX 75
ELKHORN, WI 53121

LOT 46 OF FAIR MEADOW SUBDIVISION ADDITION NO. 1

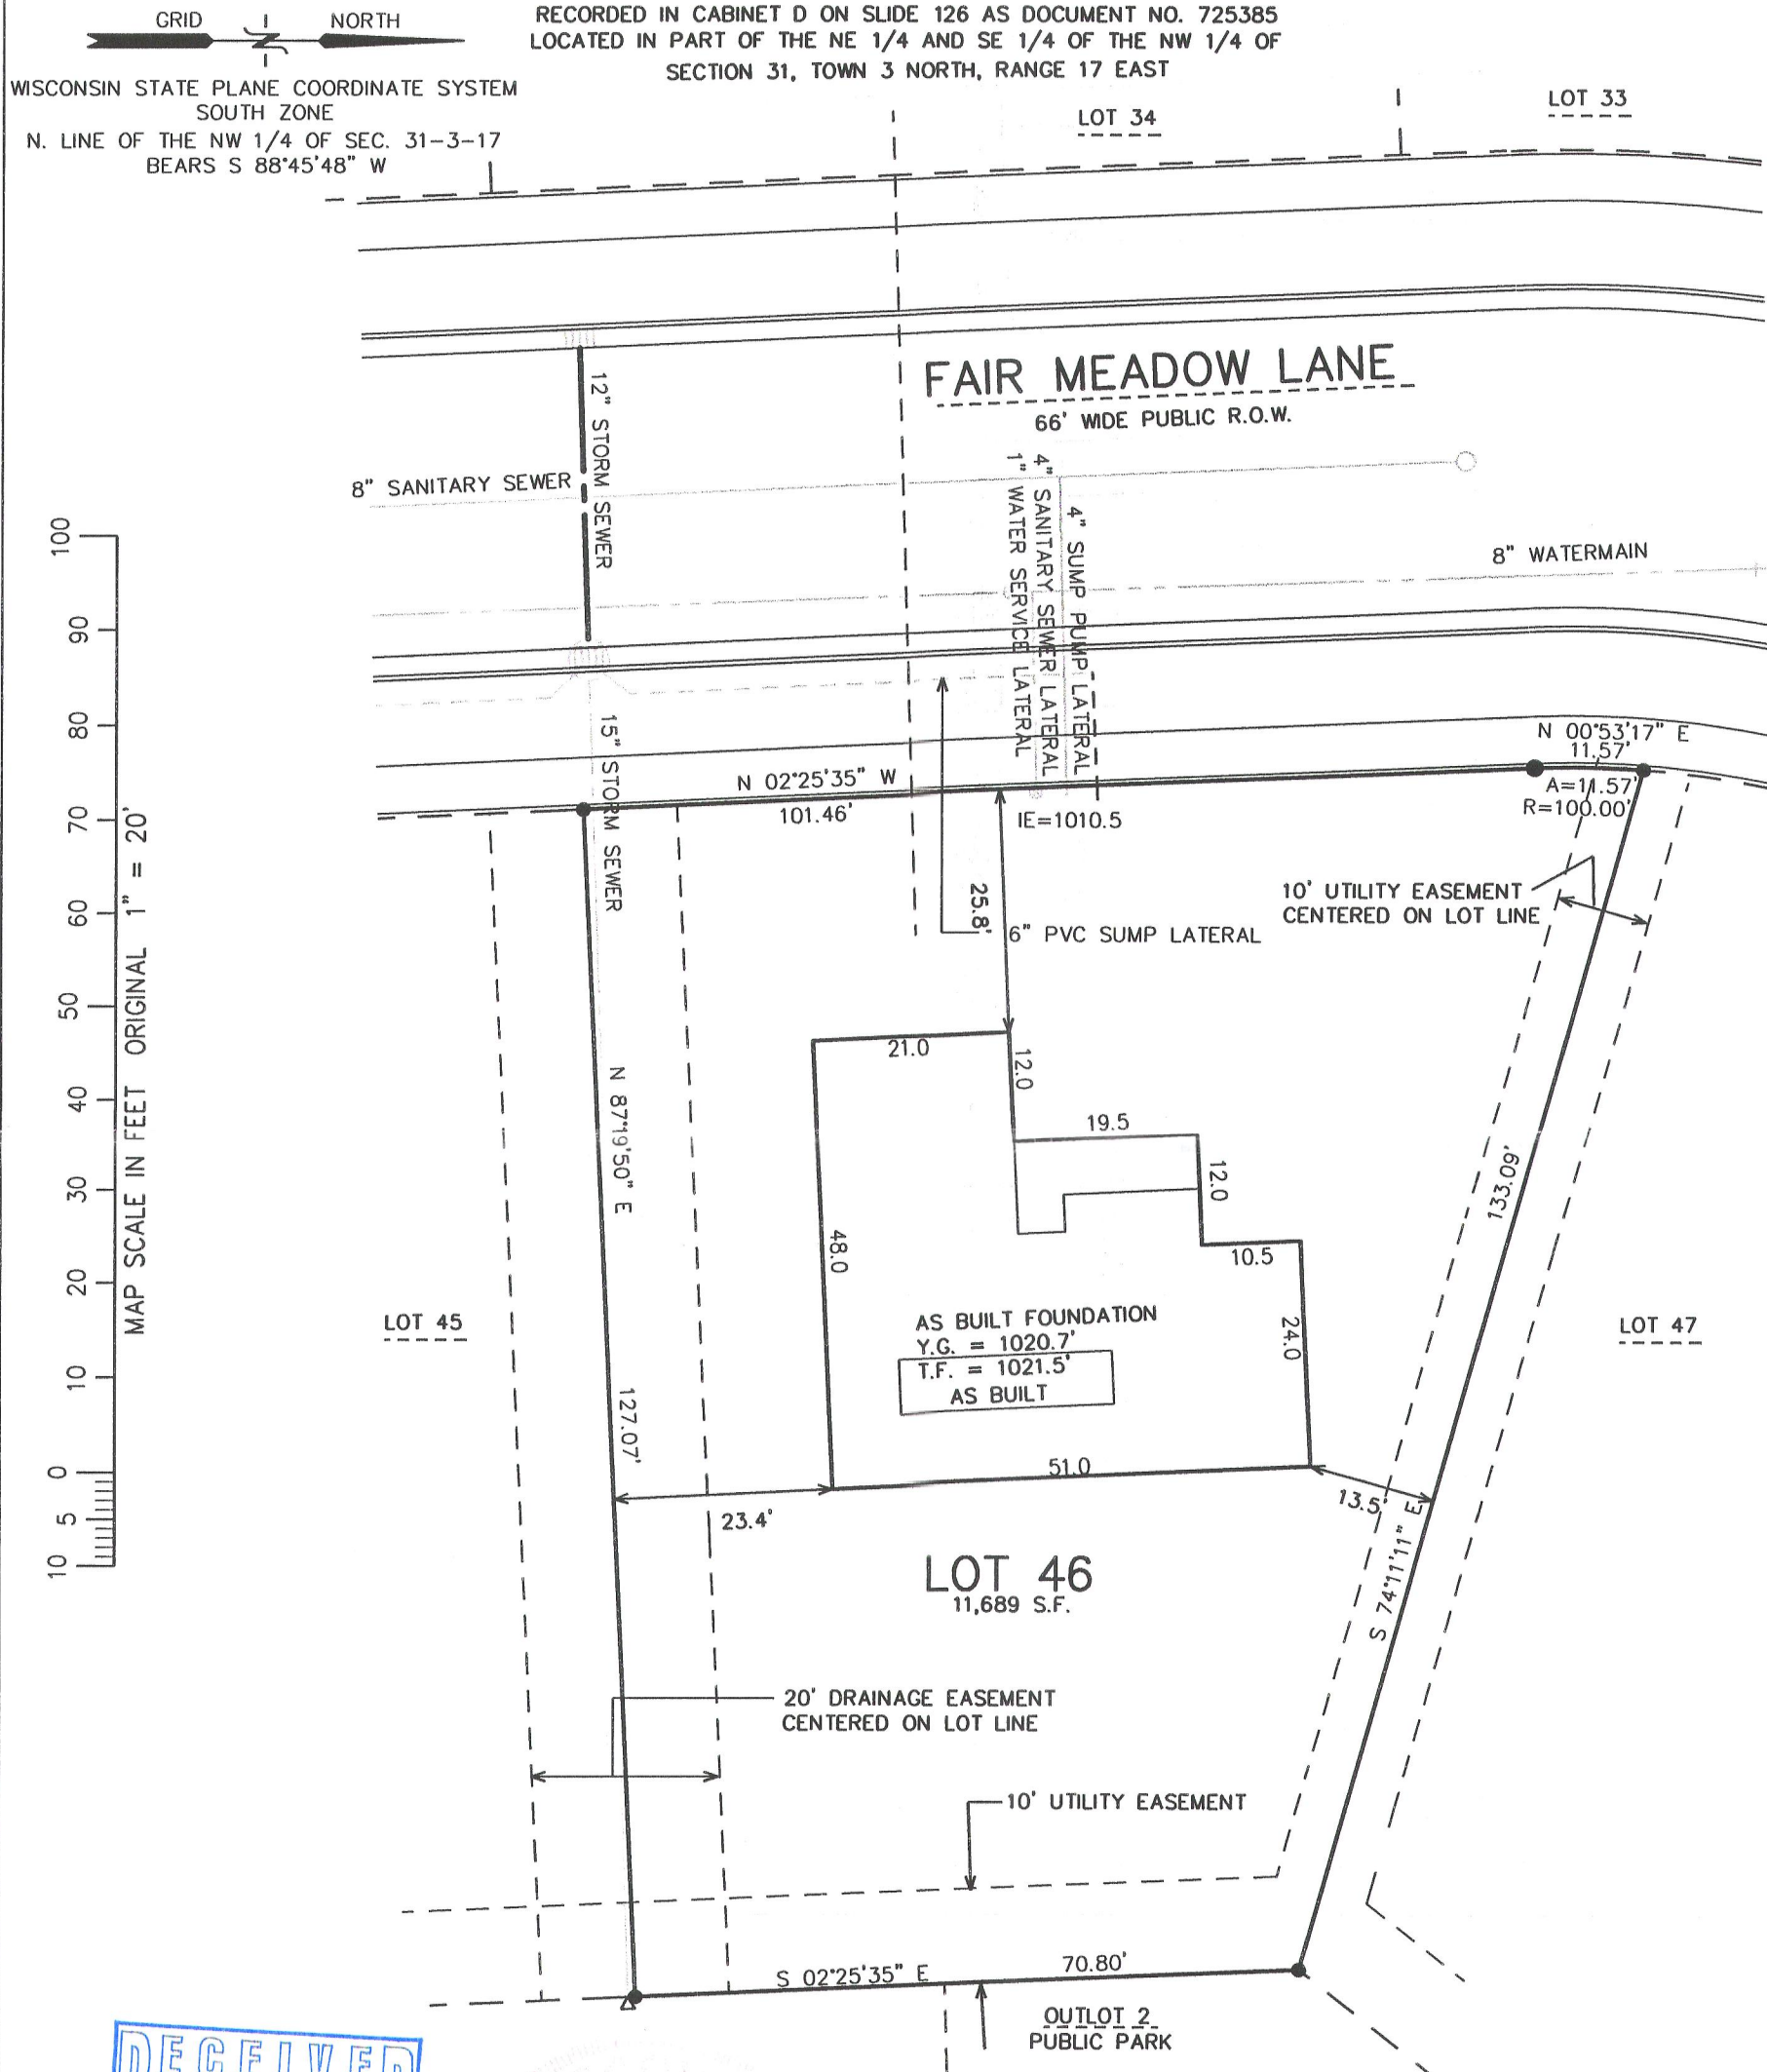

NOTE: COPIES OF THIS MAP TO WHICH THE FOLLOWING CERTIFICATE
WILL APPLY SHOW THE SURVEYOR'S ORIGINAL SEAL AND SIGNATURE
IN RED INK. COPIES BY ANY OTHER MEANS MAY HAVE ALTERATIONS
WHICH DO NOT REPRESENT THE SURVEYOR'S WORK PRODUCT.

I HEREBY CERTIFY THAT THE ABOVE DESCRIBED PROPERTY HAS BEEN
SURVEYED UNDER MY DIRECTION AND THAT THE ABOVE MAP IS A TRUE
REPRESENTATION THEREOF AND SHOWS THE SIZE AND LOCATION OF
THE PROPERTY AND ITS EXTERIOR BOUNDARIES. THIS SURVEY IS
MADE FOR THE USE OF THE PRESENT OWNERS OF THE PROPERTY, AND
ALSO THOSE WHO PURCHASE, MORTGAGE, OR GUARANTEE THE TITLE
THERETO WITHIN ONE YEAR FROM THE DATE HEREOF.

DATED: JULY 1, 2008

REVISED 10-09-2009
TO SHOW PROPOSED RESIDENCE
REVISED 11-20-2009
TO SHOW SIZE & LOCATION OF AS BUILT
FOUNDATION

PROJECT: 6104.46
DATE: 07/01/2008
SHEET 1 OF 1

PETER S. GORDON R.L.S. 2101

- LEGEND
- = FOUND IRON PIPE STAKE, 2" DIA.
 - = FOUND IRON REBAR STAKE, 1 5/16" DIA.
 - = SET SOLID ROUND IRON BAR STAKE
1 5/16" x 30" x 4.60 lbs./ft.
 - = SET IRON REBAR STAKES, 3/4" x 24" x
1.50 lbs./ft.
 - {xxx} = RECORDED AS

NOV 20 2009

YFM1-46

004-2275