
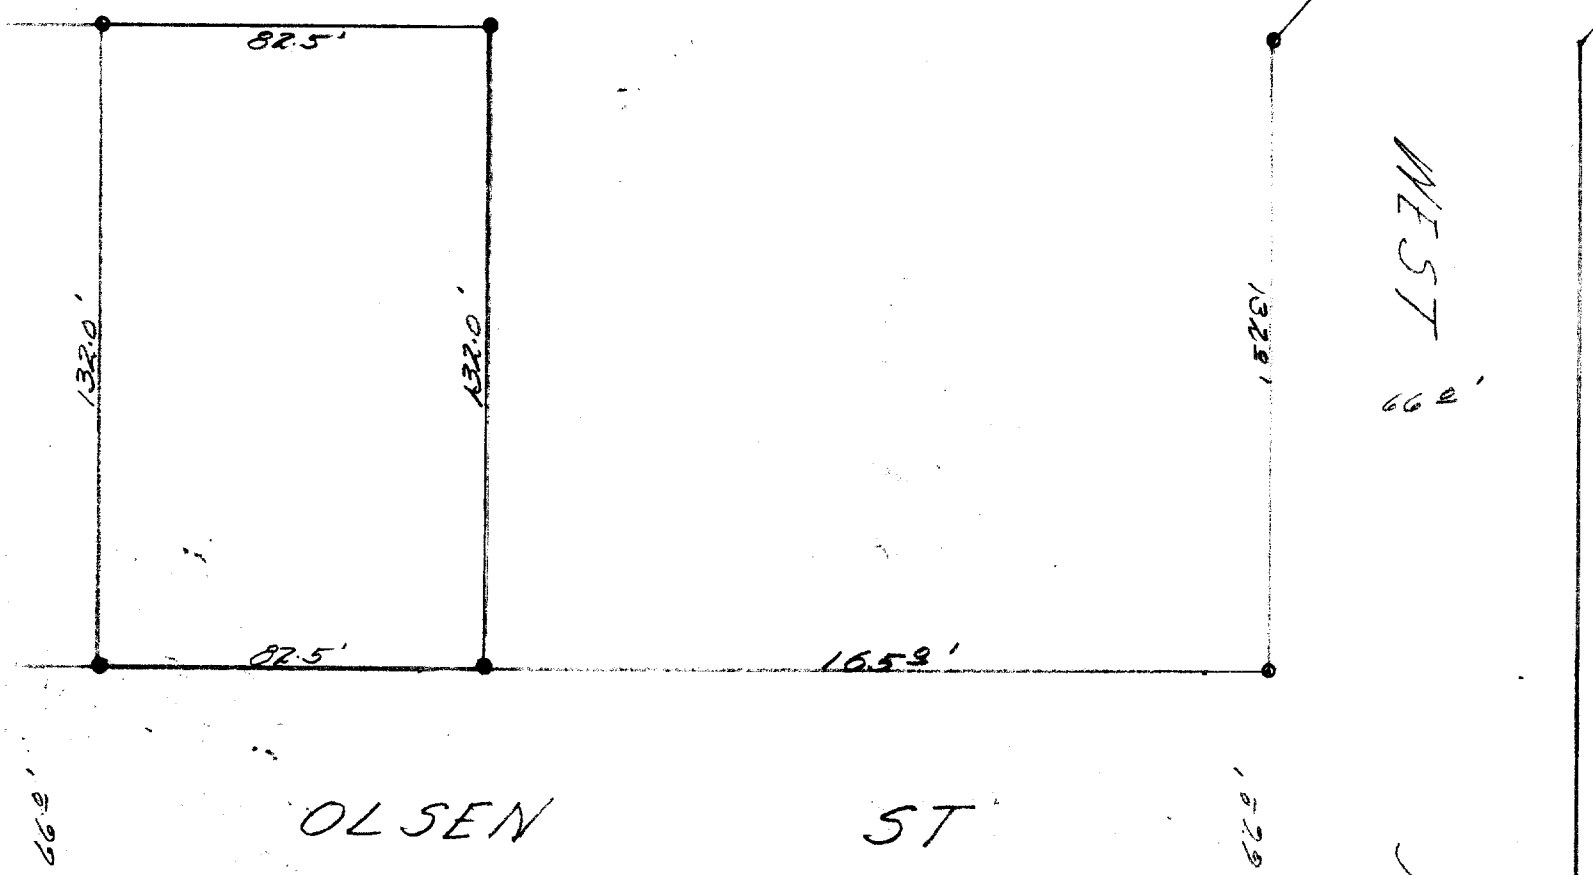


50-4

255

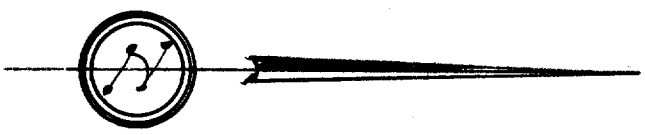

DESCRIPTION:

Beginning in the west line of Olsen Street in the City of Elkhorn, Walworth County, Wisconsin, 10 rods south of the south line of West Jefferson Street in said city, thence West 8 rods, thence South 5 rods, thence East 8 rods to a point in the west line of said Olsen Street, thence North in the west line of said Olsen Street 5 rods to the place of beginning.

CERTIFICATE:

This is to certify that I have on this the 22nd day of June surveyed the above described property according to the official plat on file in the office of the Recorder of Deeds in and for Walworth County, Wisconsin, and find that the measurements and bearings of the boundary lines of said property as taken at the site on this day, substantially agree with those on said official plat and that no encroachments exist.

SIGNED AND SEALED ON THIS THE 12TH DAY OF JULY 1950.

Joseph M. Biagi
Joseph M. Biagi, Professional Engineer
Elkhorn Wisconsin.

4-558

UNW-123

(228)

4-22