

PREPARED FOR
NORMAN PAPCKE
W7691 WISCONSIN PKWY
DELAVER WI. 53115


PLAT OF SURVEY

-OF-

PART OF THE SOUTHEAST 1/4 OF THE NORTHEAST 1/4 OF SECTION 36,
TOWN 3 NORTH, RANGE 16 EAST, WALWORTH COUNTY, WISCONSIN
DESCRIBED AS FOLLOWS TO-WIT BEGINNING AT A POINT IN THE WEST
LINE OF WISCONSIN STREET 351.78 FEET NORTH OF THE SOUTHEAST
CORNER OF BLOCK 4 OF THE ORIGINAL PLAT OF THE CITY OF ELKHORN;
THENCE N 89°47'50" W 135.10 FEET; THENCE N 0°03'17" W 111.31 FEET;
THENCE S 89°46'01" E 134.99 FEET TO A POINT IN SAID WEST LINE OF
WISCONSIN STREET; S 0°00'00" E ALONG SAID WEST LINE 111.23 FEET
TO THE PLACE OF BEGINNING.

LEGEND

- FOUND IRON BAR
- WOOD FENCE
- ▣ ELECTRICAL TRANSFORMER
- ⊙ CABLE PEDESTAL
- ⊙ TELEPHONE PEDESTAL
- (xx) RECORDED AS

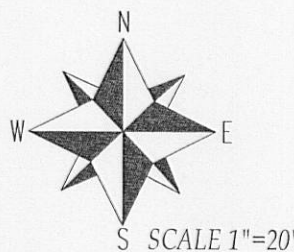

NOTE: BEARINGS ARE REFERENCED TO PREVIOUS SURVEYS OF RECORD


I have surveyed the above-described property and the above map is
a true representation thereof and shows the size and location of the
property, its exterior boundaries, the location and dimensions of all
structures thereon, fences apparent easements and roadways and
visible encroachments, if any.

This survey is made for the exclusive use of the present owners of
the property, and also those who purchase, mortgage, or insure the
title thereto within one (1) year from date hereof; and as to them I
warrant the accuracy of said survey map.

TAX ID# YUNW00013

JOB # 11-113

FIRST AVENUE

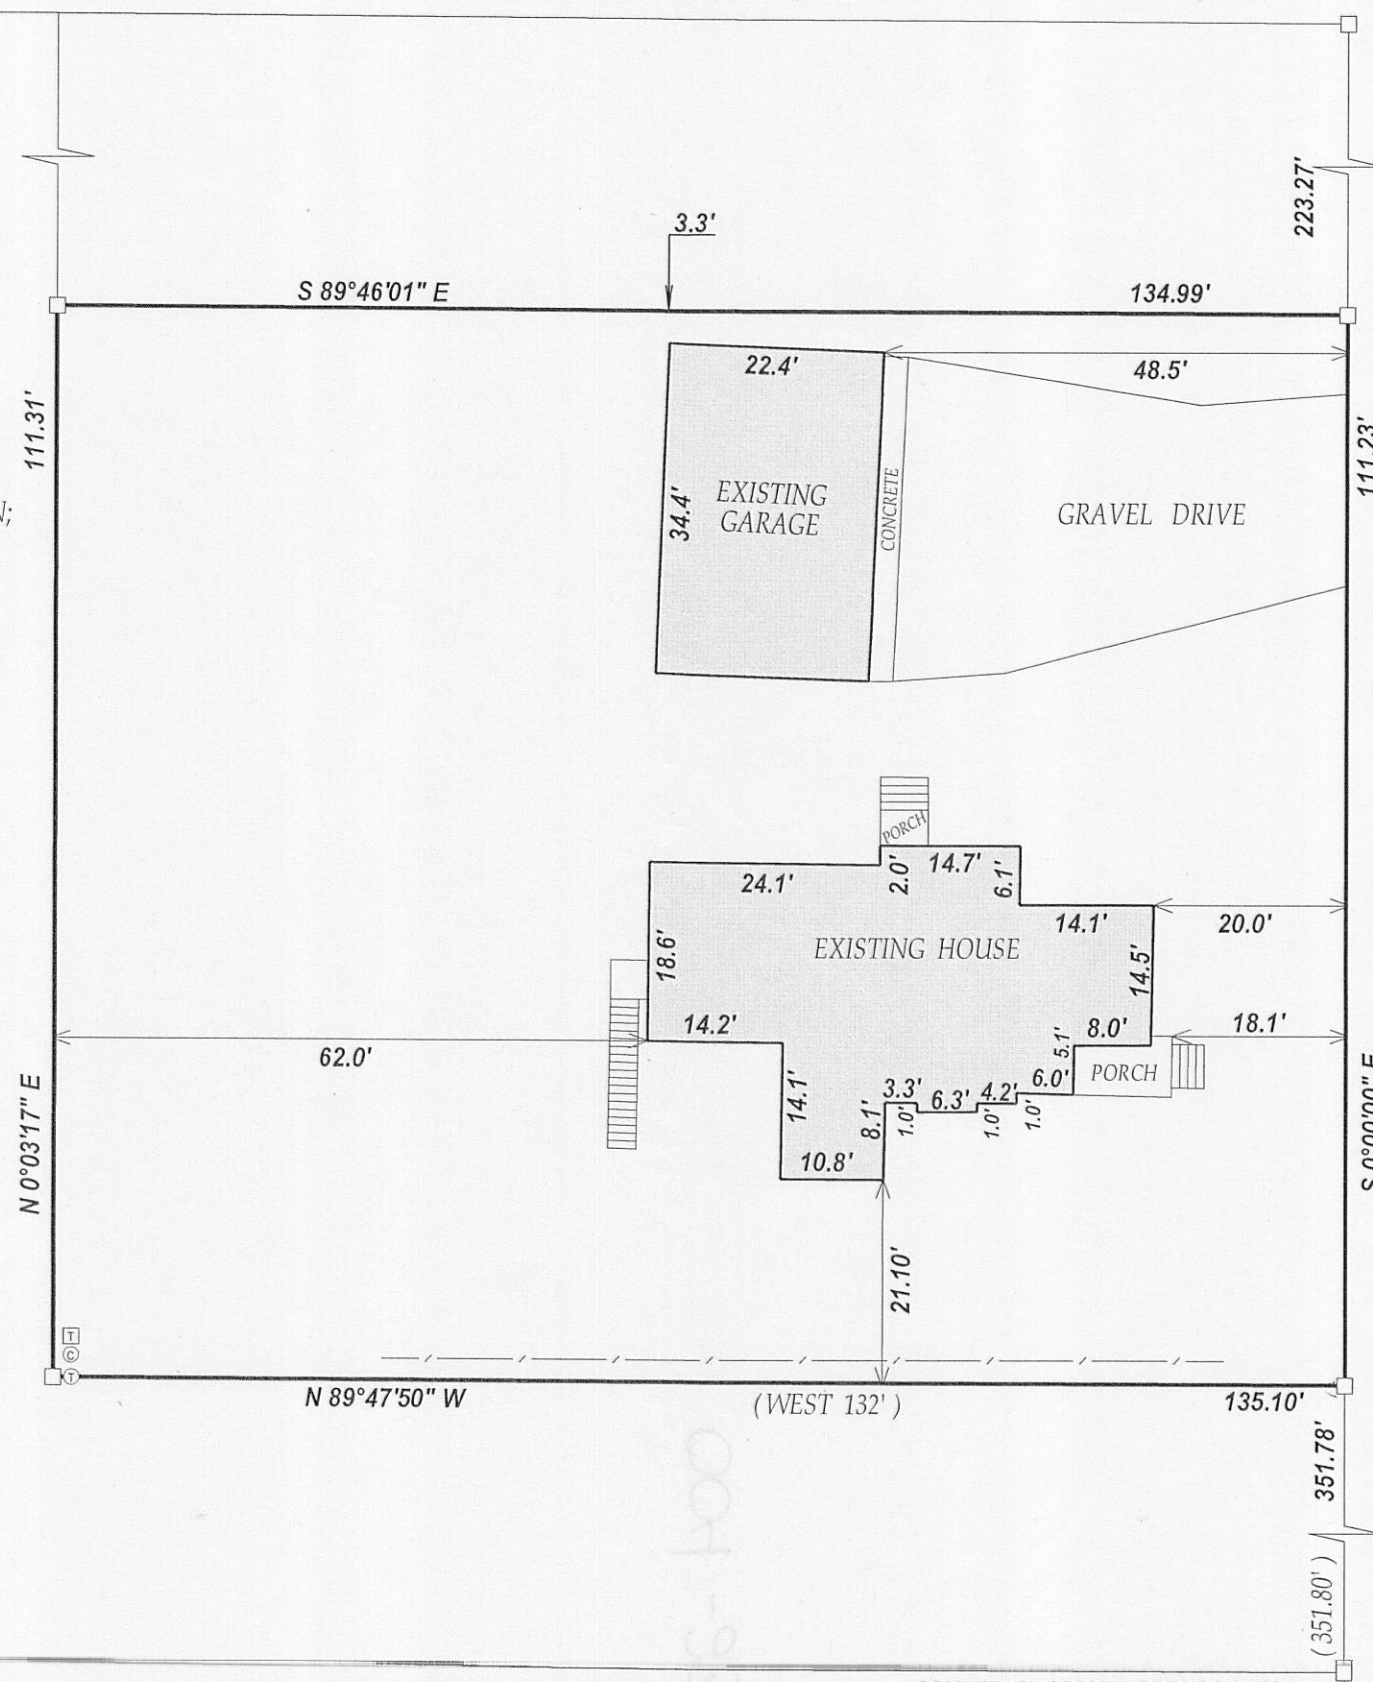

PAGE STREET



SOUTHEAST CORNER OF BLOCK 4 OF THE
ORIGINAL PLAT OF THE CITY OF ELKHORN

KROTT SURVEYING INC.

N3705 WILLOW BEND LANE
LAKE GENEVA WI. 53147
PHONE # (262)248-3697
FAX # (262)249-0639

C.L. WISCONSIN STREET

(66' WIDE)

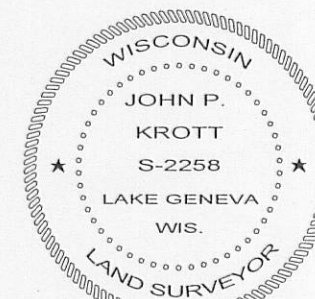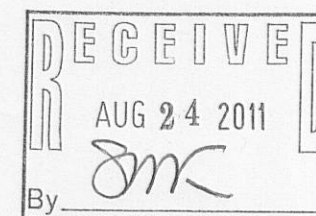

DATED THIS 27th DAY OF JULY 2011.

John P. Krott

JOHN KROTT S - 2258
Wisconsin Registered Land Surveyor
(original if signed in red)

004-2324