


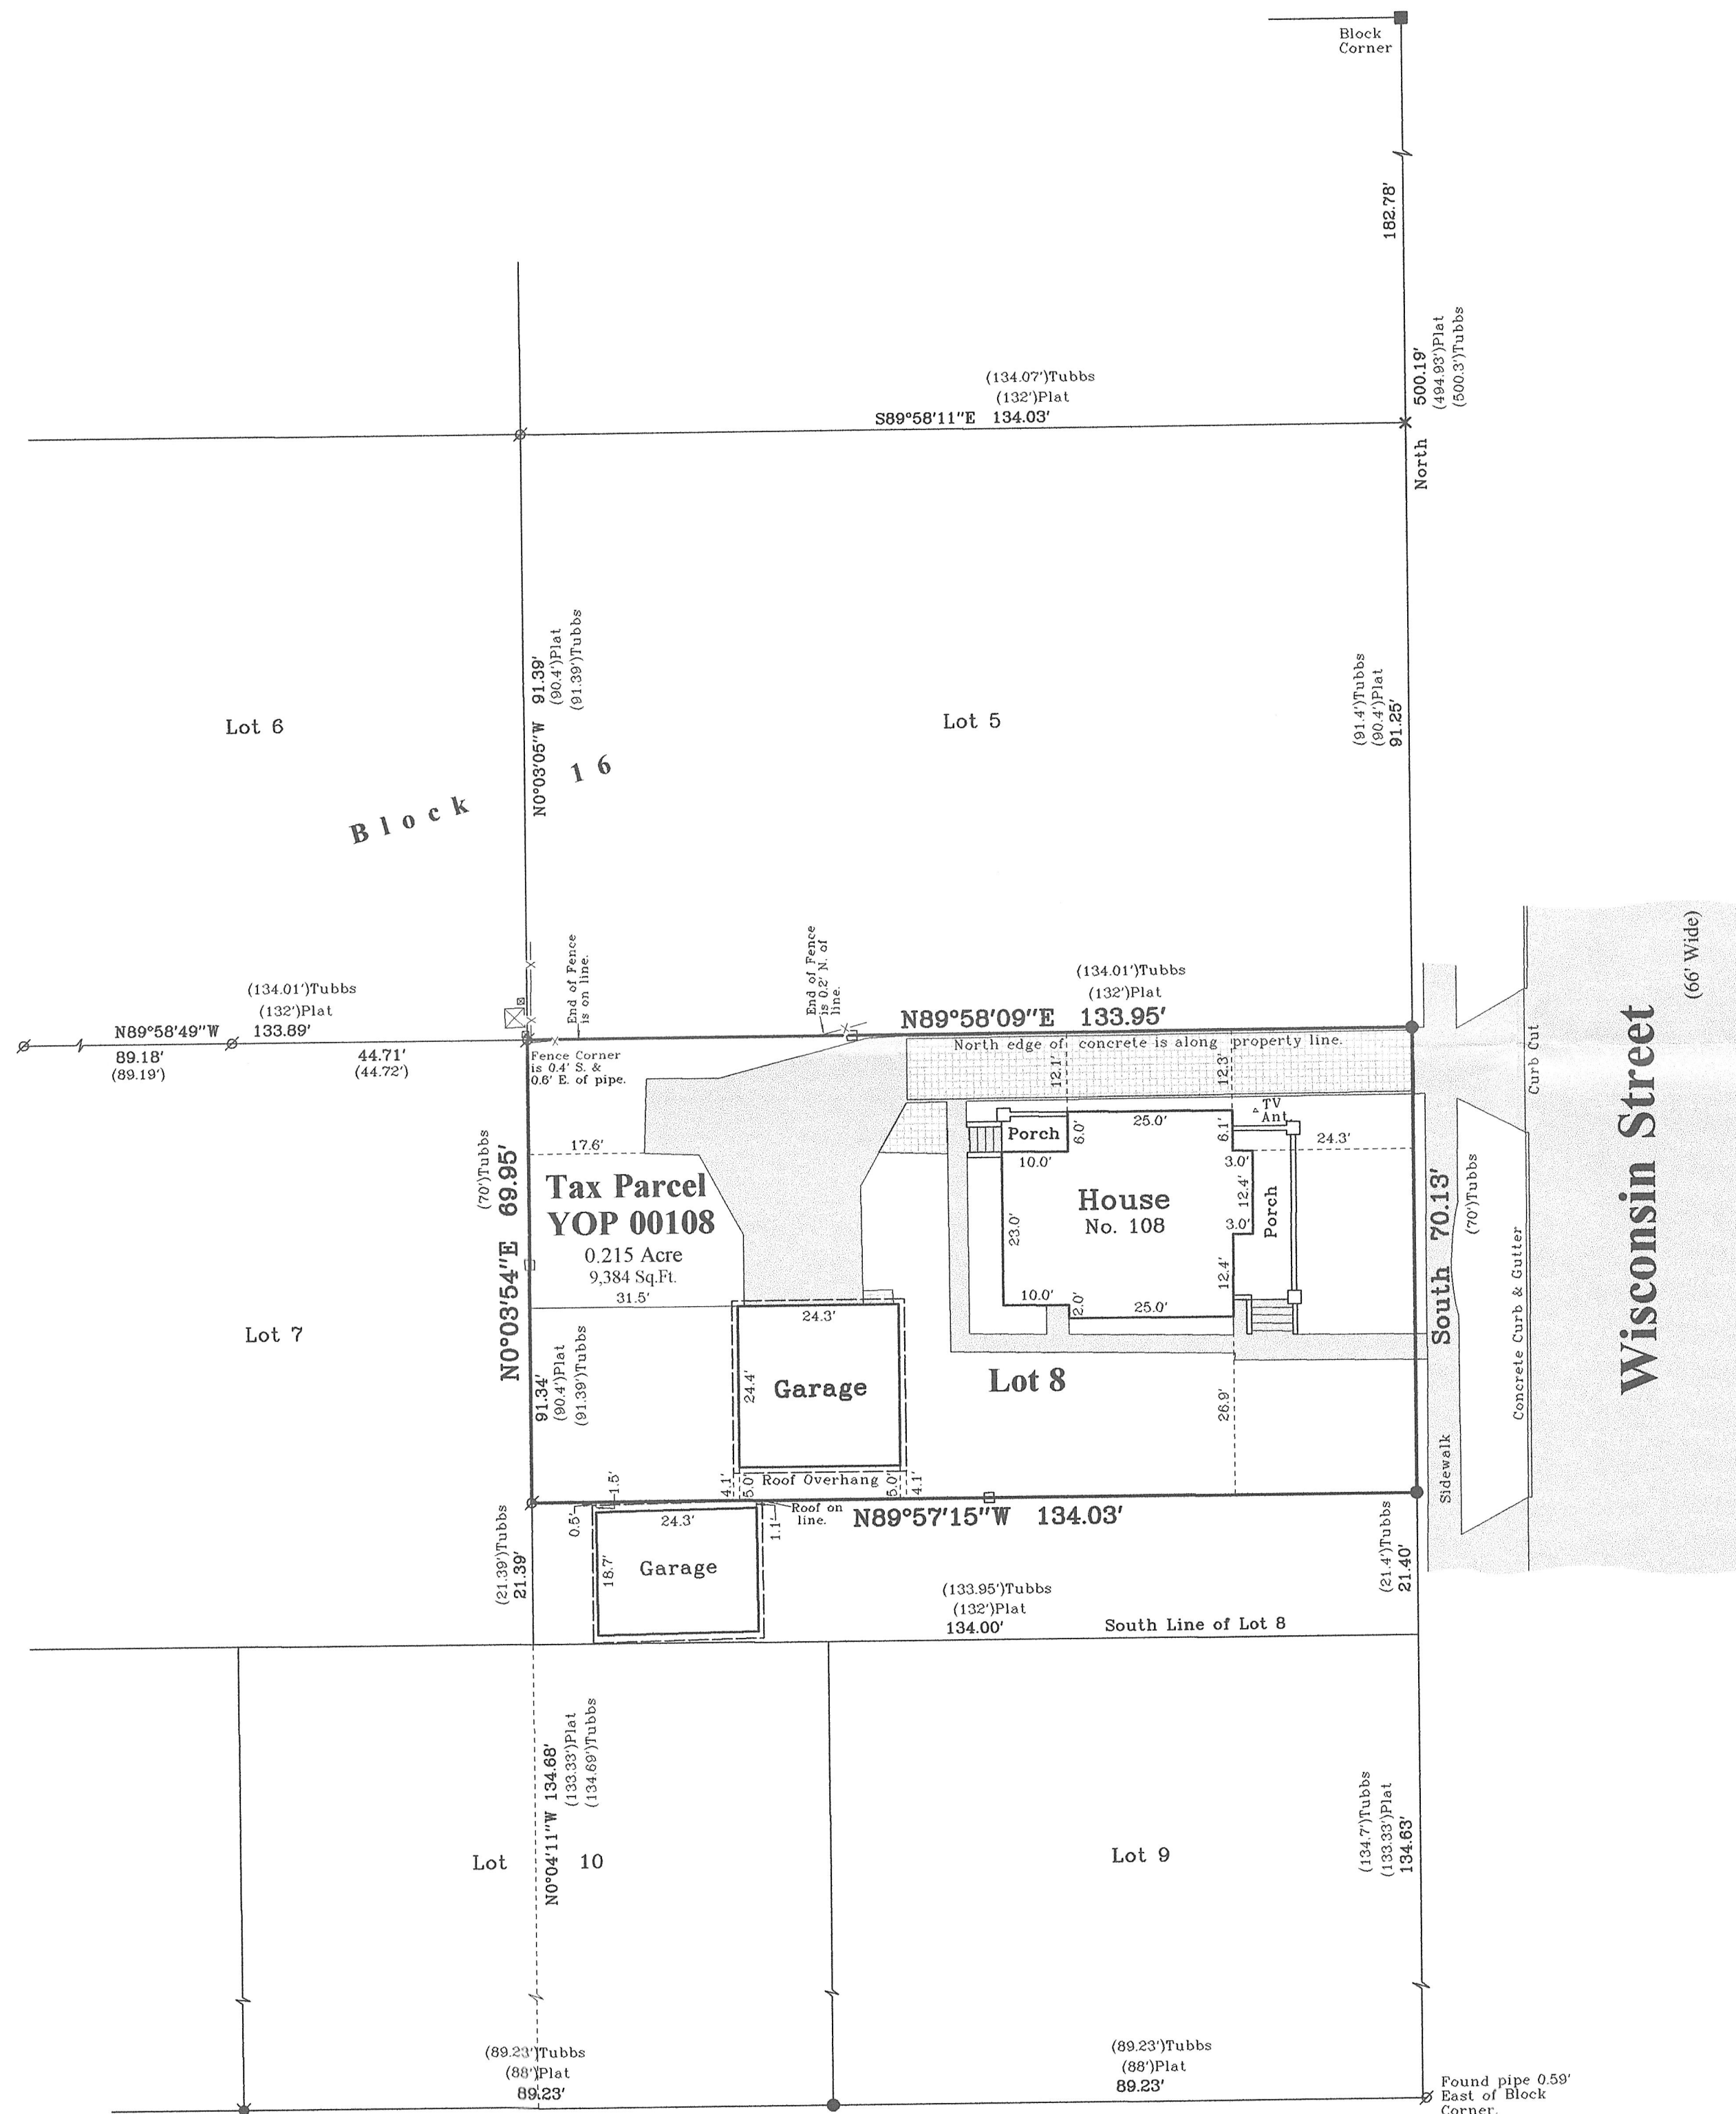


Plat of Survey

of

The North 70' of Lot 8 in Block 16 of the Original Plat of the Village of Elkhorn,


located in the Southeast 1/4 of Section 36, Town 3 North, Range 16 East, City of Elkhorn, Walworth County, Wisconsin.

Surveyed for: **Karen Komar**
108 North Wisconsin Street
Elkhorn, Wisconsin. 53121

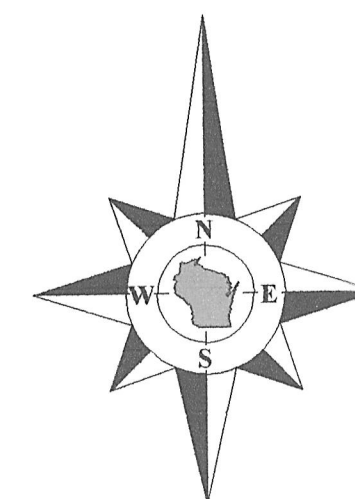

Bearings reference to the West line of Wisconsin Street, assumed as North.

Note:
(82.5')Plat - Indicates dimension as shown on the Original Plat of the City of Elkhorn.
(83.5')Tubbs - Indicates dimension as shown on City Engineer H.H. Tubbs' survey of the City of Elkhorn, dated July 1930.

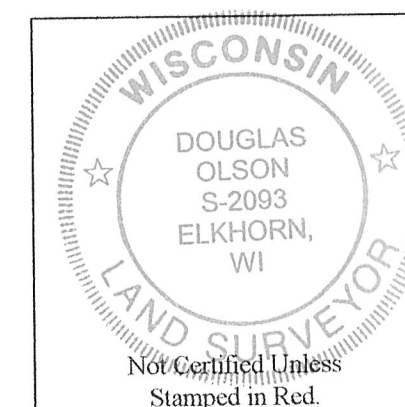

Notes:

- 1) This survey plat is not certified unless signed and sealed in red ink.
- 2) This survey is subject to Wisconsin lien laws. This Plat of Survey is the notice of intent to file lien. Lien waiver required.


Copyright 2011 by Jensen & Olson Land Surveying, LLC.

All rights reserved. No part of this survey plat may be reproduced or transmitted in any form by any means - graphic, electronic, or mechanical, including photocopying, tracing, or information storage and retrieval systems - without permission in writing from Douglas G. Olson, Jensen & Olson Land Surveying, LLC.

I, Douglas G. Olson, Wisconsin Registered Land Surveyor, do hereby certify that this survey was performed by me, or under my direction in full compliance with the owner's/agent's instructions and Chapter A-E 7 of the Wisconsin Administrative Code "Minimum Standards for Property Surveys"; and that this map is an accurate representation thereof to the best of my knowledge and belief.

Douglas G. Olson
Wisconsin Registered Land Surveyor - 2093

Survey Date: June 2, 2011.
Revisions:

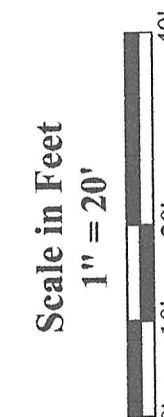

Jensen & Olson Land Surveying, LLC

45 South Wisconsin Street * P.O. Box 322 * Elkhorn, Wisconsin. 53121
Telephone: (262) 723-3434 * Facsimile: (262) 723-8044
Email: jensen.olson@elknet.net



Legend
☒ Found Iron Pipe
☒ Found Square Rod
☒ Found Chained Cross
☒ Found Railroad Spike
☒ Recorded Information
☒ Utility Box or Pedestal
☒ Asphalt Surface
☒ Concrete Surface
☒ Brick Pavers

Sheet 1 of 1 Sheets
Drawing Name: 004-2340-2011042Plat.svs
Job Reference Number
2011.042

2011.042

YOP-108

004-2340