


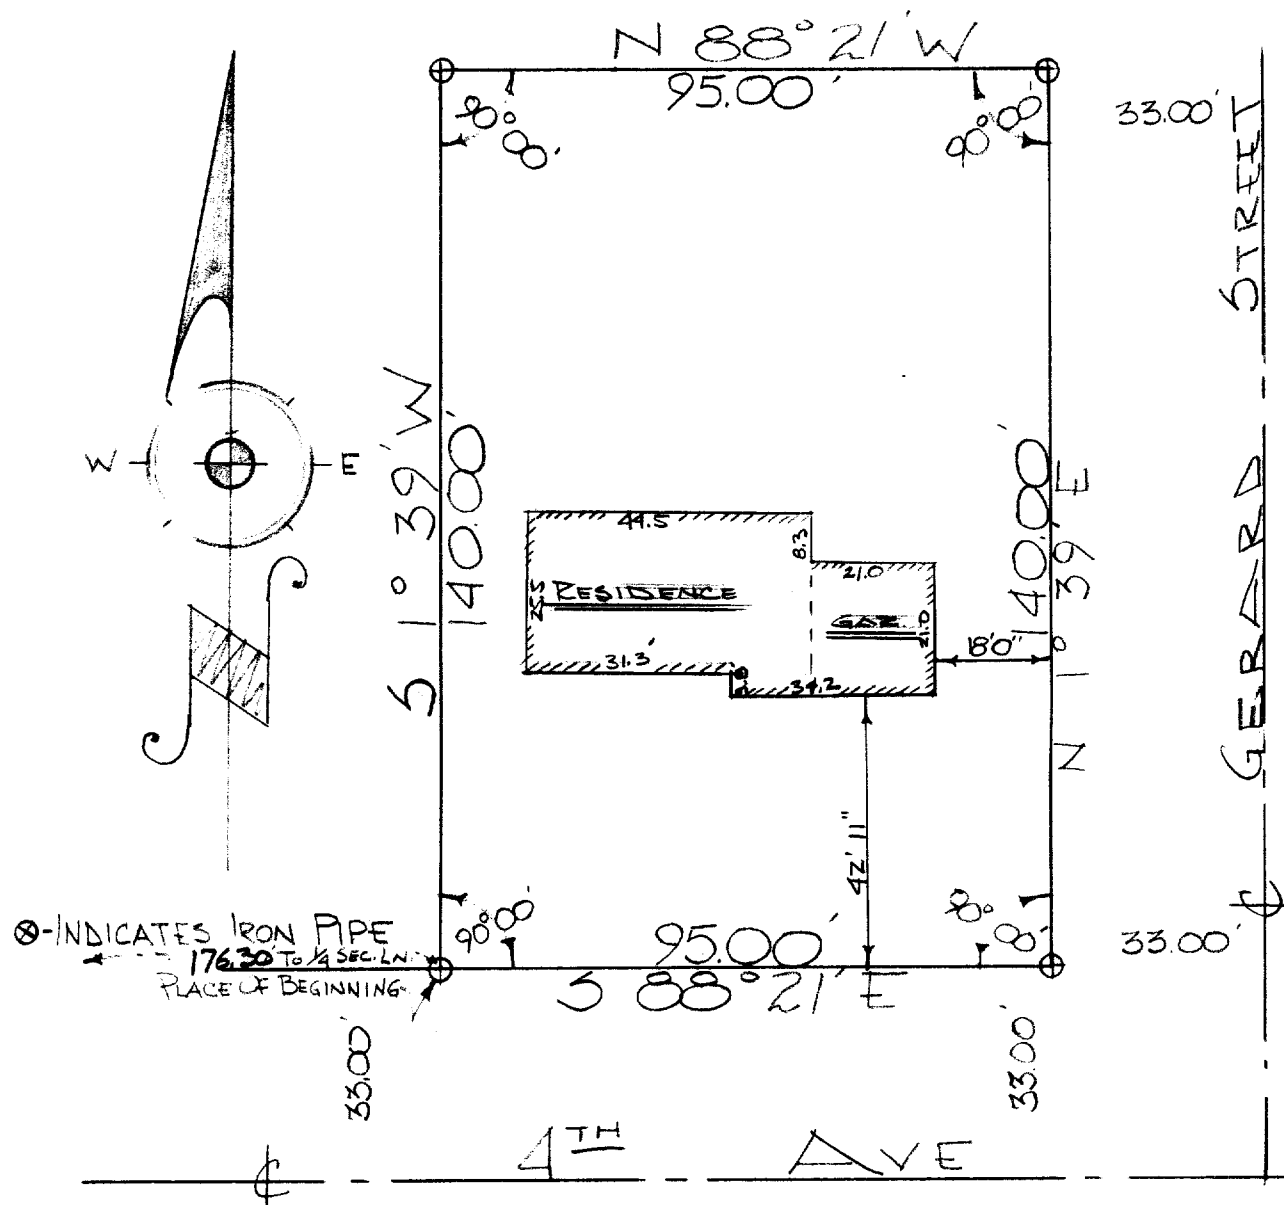


DESCRIPTION: Commencing at the NW corner of the NE $\frac{1}{4}$ of Section 36, T. 3 N., R. 16 E. Walworth County, Wisconsin; thence S $1^{\circ} 39'$ W. along the west line of the NE $\frac{1}{4}$ of Section 36 ~~376.38~~ 176.30 feet to a point, thence S $88^{\circ} 21'$ E. 176.30 feet to the place of beginning of the lands hereinafter described: thence S $88^{\circ} 21'$ E 95.00 feet to an iron stake, thence N. $1^{\circ} 39'$ E. 140.00 feet to an iron stake, thence N $88^{\circ} 21'$ W 95.00 feet to an iron stake, thence S $1^{\circ} 39'$ W. 140.00 feet to the place of beginning.

CERTIFICATE: I, James F. Biagi, surveyor, do hereby certify that I have surveyed the property hereon described on this 4th day of May, 1962.

Recertified

Aug 4, 1967

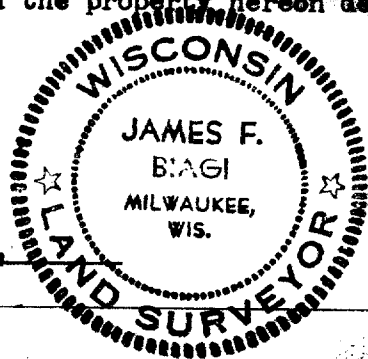

James F. Biagi, RLS 272

I, James F. Biagi, surveyor, do hereby certify that the location of the improvements are as shown. Aug. 4, 1967

U-NW-49

4-235B