
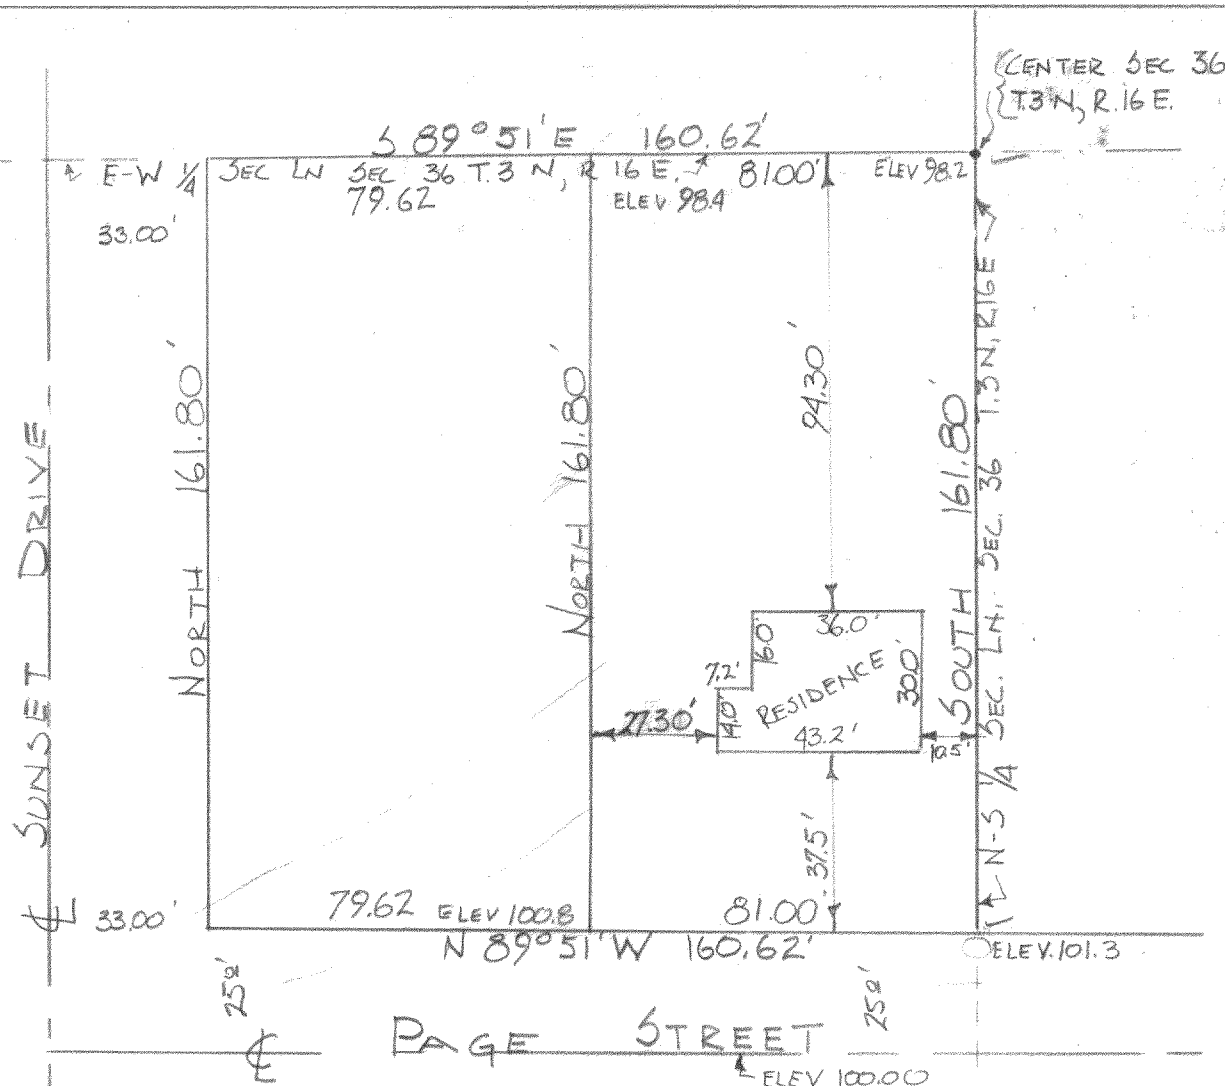



61-51

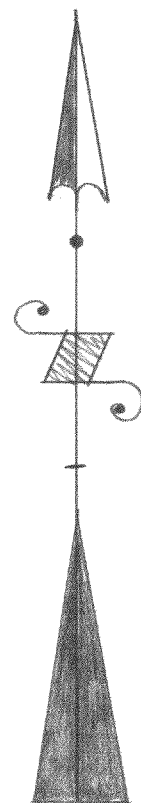

DESCRIPTION: The east 81.00 feet of the following described land: Commencing at that certain point where the North line of West Page St. in the City of Elkhorn intersects the East line of Sunset Drive, thence North along the east line of Sunset Drive 161.80 feet to a point, thence S89° 51'E 160.62 feet to a point, thence South 161.80 feet to a point in the North line of Page Street aforesaid, thence N89° 51'W along the North line of Page Street 160.62 feet to the place of beginning, located in the NE $\frac{1}{4}$ of the SW $\frac{1}{4}$ of Sec. 36, T. 3 N., R. 16 E., in the City of Elkhorn, Walworth County, Wisconsin.

CERTIFICATE: I James F. Biagi, surveyor do hereby certify that I have surveyed the property hereon described and that the location of all the improvements are as shown on the drawing above.

Signed this 7th day of January, 1961.

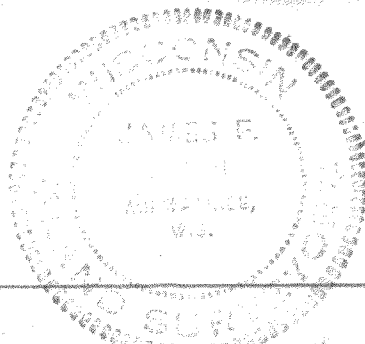

James F. Biagi
James F. Biagi (RLS) 272

U-NW-67
68

SW $\frac{1}{4}$ 36-3-16

4-237