

PLAT OF SURVEY

BEING ALL OF LOT 21 OF HARVEST POINTE SOUTH, LOCATED IN THE SW 1/4 OF THE SW 1/4 OF SEC. 30, T.3N., R.17E., CITY OF ELKHORN, WALWORTH COUNTY, WI.

SURVEYOR

SURVEY FOR



DANIEL E. BEDNAR, RLS 2812
YAGGY COLBY ASSOCIATES
501 MAPLE AVE.
DELAFIELD, WISCONSIN 53018
(262)646-6855

BIELINSKI HOMES, INC
1830 MEADOW LANE, SUITE A
PEWAUKEE, WI 53072

LEGEND

- - 1" IRON PIPE FOUND
- - UTILITY BOX
- ⊗ - CURB STOP
- ⊙ - MANHOLE
- ⊕ - BENCHMARK (AS NOTED)
- (XXX.X) - ADJ. GARAGE GRADE PER MASTER GRADING PLAN

- NOTES:
1. UTILITY EASEMENTS NOT SHOWN--NO TITLE POLICY PROVIDED
 2. PENALTY FOR DISTURBING LOT CORNER MONUMENTS \$250.00 OR UP TO 1 YEAR IMPRISONMENT PER SS. 236.32(2)
 3. THIS SURVEY IS SUBJECT TO ALL RESTRICTIONS AND NOTES SHOWN ON THE FINAL PLAT OF HARVEST POINTE SOUTH RECORDED AT WALWORTH COUNTY REGISTER OF DEEDS OFFICE.

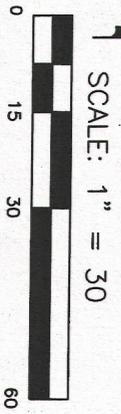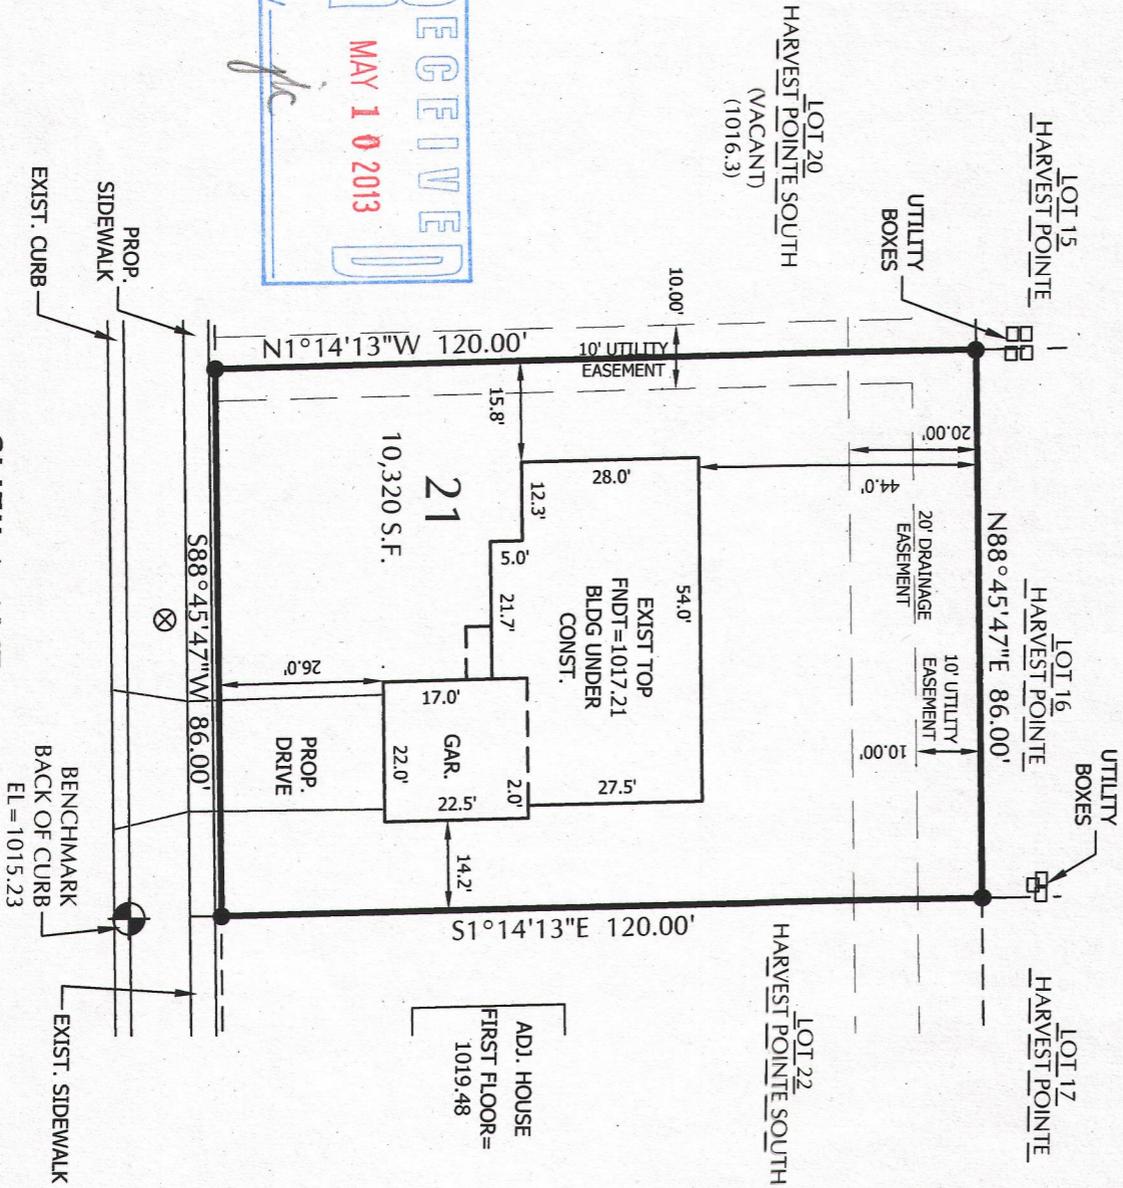

SURVEYOR'S CERTIFICATE:

I HEREBY CERTIFY THAT I HAVE SURVEYED THE ABOVE DESCRIBED PROPERTY AND THAT THE ABOVE MAP IS A TRUE REPRESENTATION THEREOF AND SHOWS THE SIZE AND LOCATION OF THE PROPERTY, ITS EXTERIOR BOUNDARIES, THE LOCATION OF ALL VISIBLE STRUCTURES AND DIMENSIONS OF ALL PRINCIPAL BUILDINGS THEREON, BOUNDARY FENCES, APPARENT EASEMENTS, ROADWAYS, AND VISIBLE ENCROACHMENTS, IF ANY.

THIS SURVEY IS MADE FOR THE USE OF THE PRESENT OWNERS OF THE PROPERTY, AND ALSO THOSE WHO PURCHASE, MORTGAGE, OR GUARANTEE THE TITLE THERETO WITHIN ONE (1) YEAR FROM DATE HEREOF.

YAGGY COLBY ASSOCIATES 501 MAPLE AVE., DELAFIELD, WI 53018 262-646-6855
PATH: P:\B13435\DWG\B13435-C3D.DWG

YHPS 00021

004-2379

