



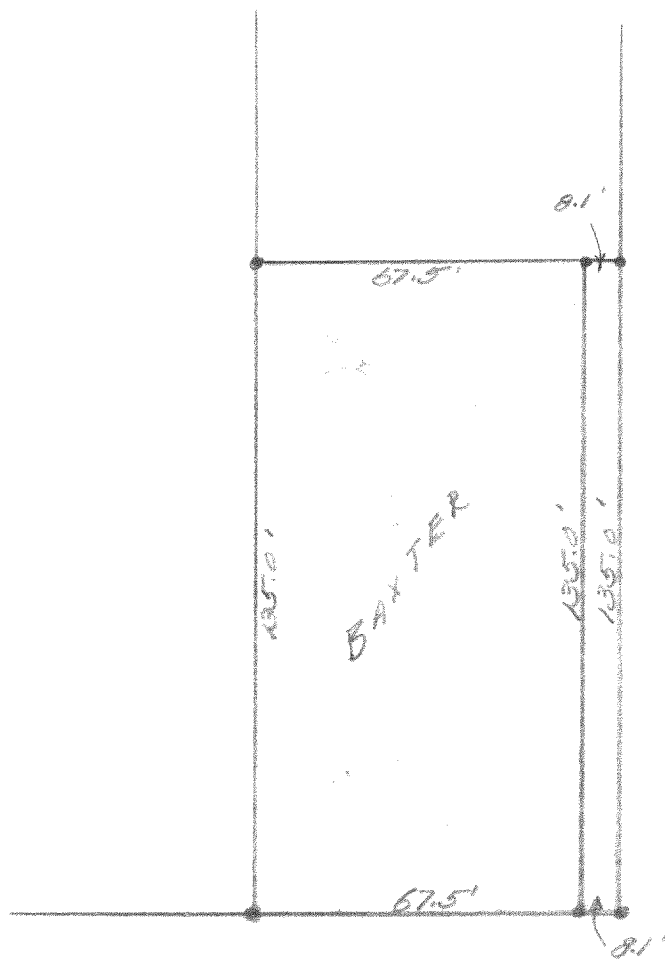

3RD AVE (PROPOSED)

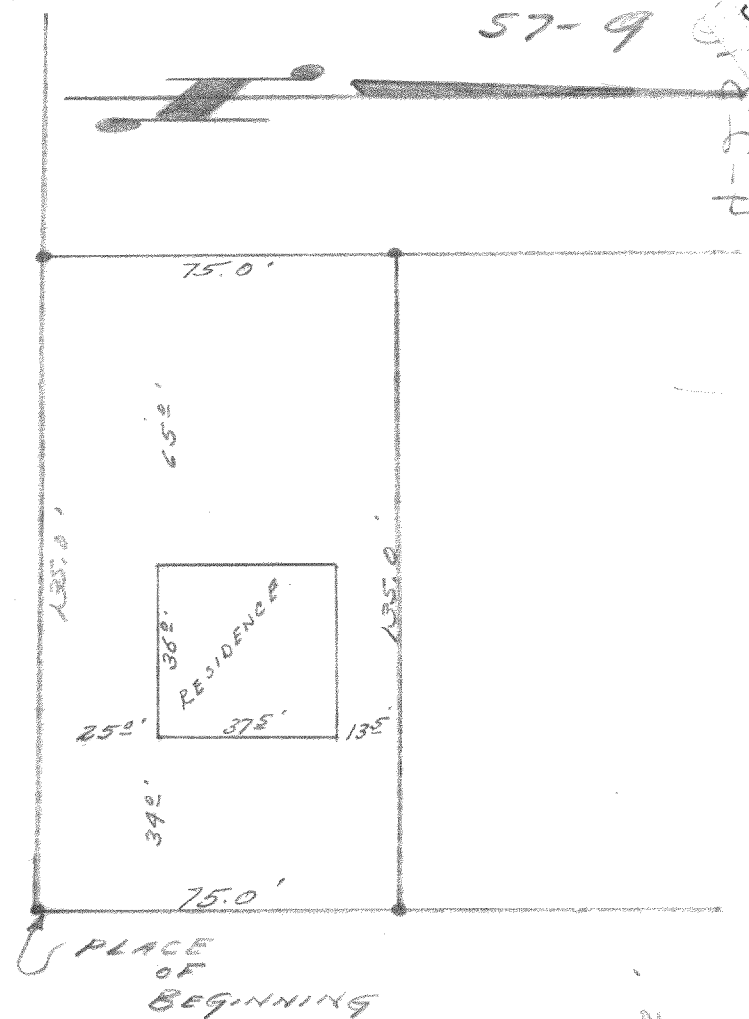

CHURCH ST.

DESCRIPTION:

Commencing at an iron stake in the west line of North Church Street of the City of Elkhorn, Walworth County, Wisconsin, that is 520.14 feet north of the intersection of the north line of Second Avenue and the west line of North Church Street of said city, thence North 75.0 feet to an iron stake, thence West 135.0 feet to an iron stake, thence South 75.0 feet to an iron stake, thence East 135.0 feet to the place of beginning.

CERTIFICATE:

I, hereby certify that I have on this the 29th day of September 1956, surveyed the above described property according to the official records on file in the Recorder of Deeds for Walworth County, Wisconsin, and find that no encroachments exist.

SIGNED AND SEALED ON THIS THE 1ST DAY OF OCTOBER 1956.

Joseph M. Biagi, Professional Engineer.
Elkhorn Wisconsin.

CERTIFICATE: I hereby certify that I have on this the 31st day of August 1957, surveyed the above described property according to the official records on file in the office of the Recorder of Deeds for Walworth County, Wisconsin and find that no encroachments exist, and that the residence constructed on said property as of this day is wholly within the boundaries of said property.

SIGNED AND SEALED ON THIS THE 31ST DAY OF AUGUST 1957.

Joseph M. Biagi, Registered Surveyor
Elkhorn Wisconsin.

UNW-32

ME 1/4 36-3-16

4-237B