


PATHFINDER SURVEYING INC.
(formerly)
J.K. SURVEYING INC.
P.O BOX 322
LAKE GENEVA, WI. 53147
WWW.PATHFINDERSURVEYING.NET
262-248-8303



- OF -

LOT 78 OF HEARTHSTONE OF ELKHORN ADDITION No. 1, A REPLAT OF LOTS 31 AND 32, LOTS 35 THROUGH 42, AND DAVENPORT CIRCLE OF HEARTHSTONE OF ELKHORN AND ADDITIONAL LANDS ALL IN PART OF THE SW 1/4 OF THE NE 1/4 OF SECTION 25, TOWN 3 NORTH, RANGE 16 EAST OF THE FOURTH PRINCIPAL MERIDIAN, CITY OF ELKHORN, WALWORTH COUNTY, WISCONSIN.

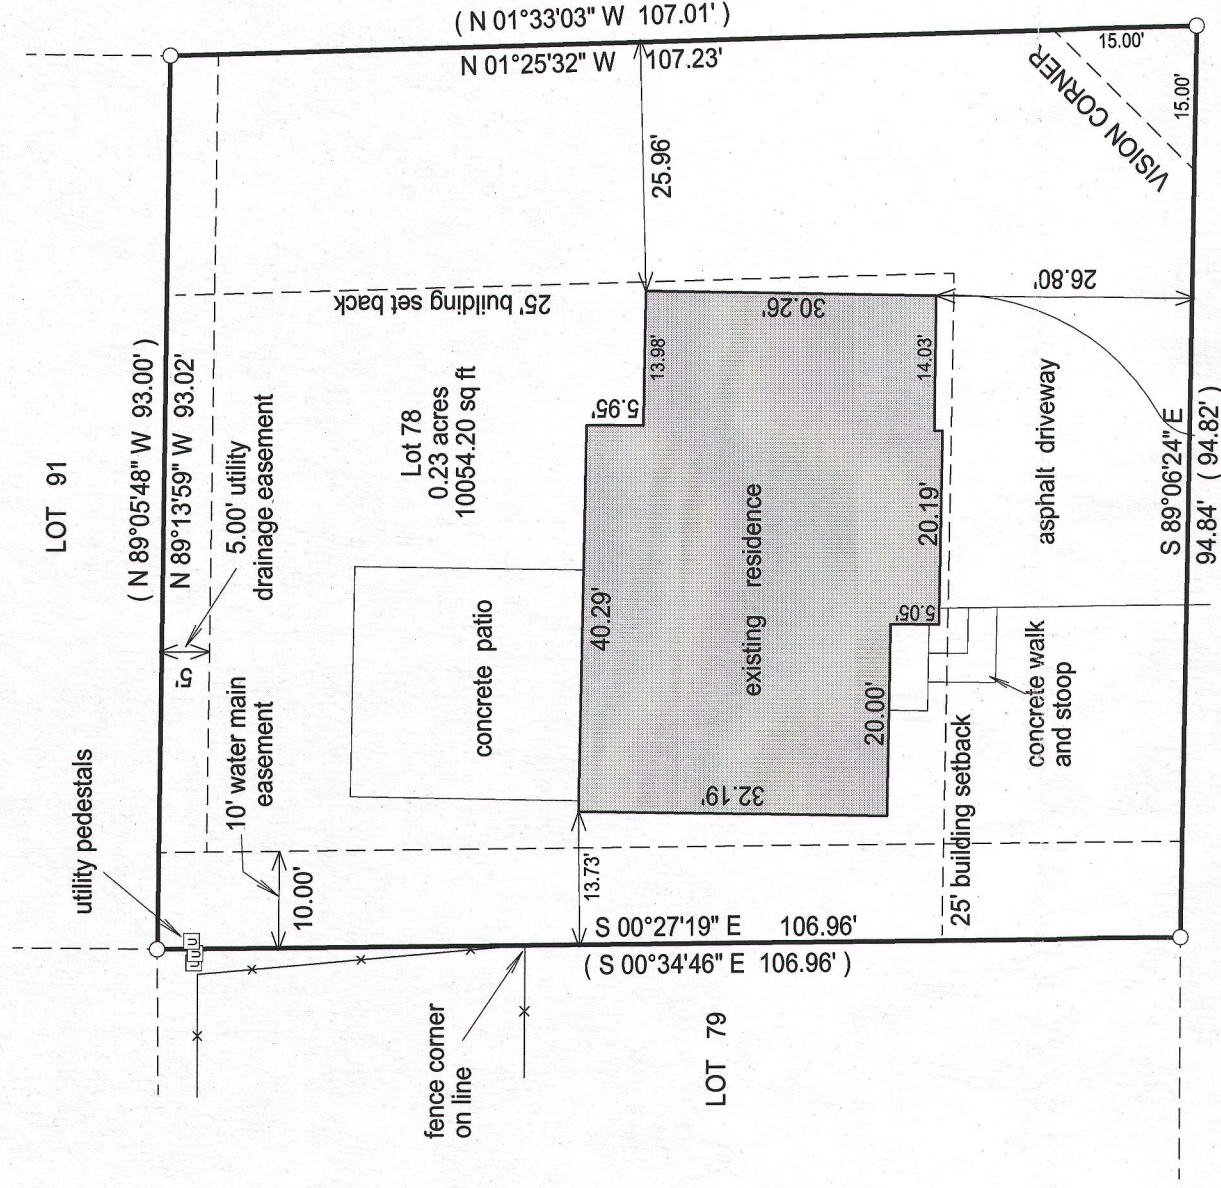

DAVENPORT STREET

 .
(platted as 66' wide)

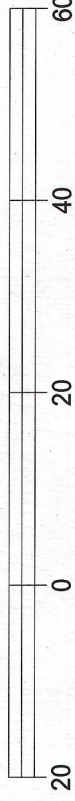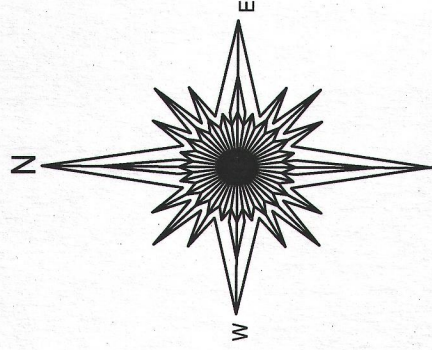


BASIS OF BEARING OF THIS PLAT: THE NORTH LINE OF DAVENPORT STREET WAS ASSUMED TO BEAR S 89°06'24" E AS SHOWN ON THE RECORD SUBDIVISION PLAT.

I hereby certify that I have surveyed the above-described property and the above map is a true representation thereof and shows the size and location of the property, its exterior boundaries, the location and dimensions of all structures thereon, fences, apparent easements and roadways and visible encroachments if any.

This survey is made for the present owners of the property, and those who purchase, mortgage, or guarantee the title thereto, within one year from the date hereof.

DATED THIS 21ST DAY OF MARCH, 2013.

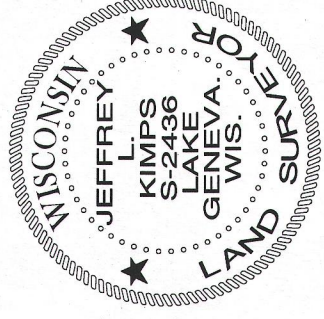

JEFFREY L KIMPS S - 2436
Wisconsin Registered Land Surveyor
(original if signed in red)

JOB # 13-18

TAX ID #

YHE1 00022

YHEI-22

004-2390