


FARRIS, HANSEN & ASSOC. INC.

7 RIDGWAY COURT- P.O. BOX 437
ELKHORN, WISCONSIN 53121
PHONE (262) 723-2098
FAX (262) 723-5886

PLAT OF SURVEY
LOT 2 OF CERTIFIED SURVEY 595
LOCATED IN SECTION 1, TOWN 2 NORTH, RANGE 16 EAST
CITY OF ELKHORN, WALWORTH COUNTY, WISCONSIN

ORDERED BY: RICK GEASLEN
234 WESTWARD DRIVE
ELKHORN, WI. 53121

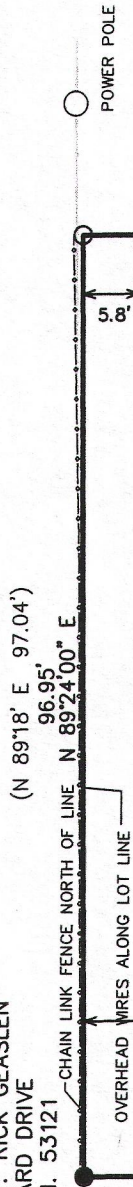

- LEGEND**
- = FOUND IRON PIPE STAKE
 - = FOUND IRON REBAR STAKE
 - (XXX) = RECORDED AS



LOT 2
12,345 S.F.
0.28 AC.

LOT 3

(N 00°21'59" W 127.47')
127.27'
N 00°26'25" W

(S 00°21'59" E 127.57')
127.21'
S 00°29'53" E
LOT 1

ASSIGNED NORTH LINE WESTWARD DRIVE
S 89°22'00" W

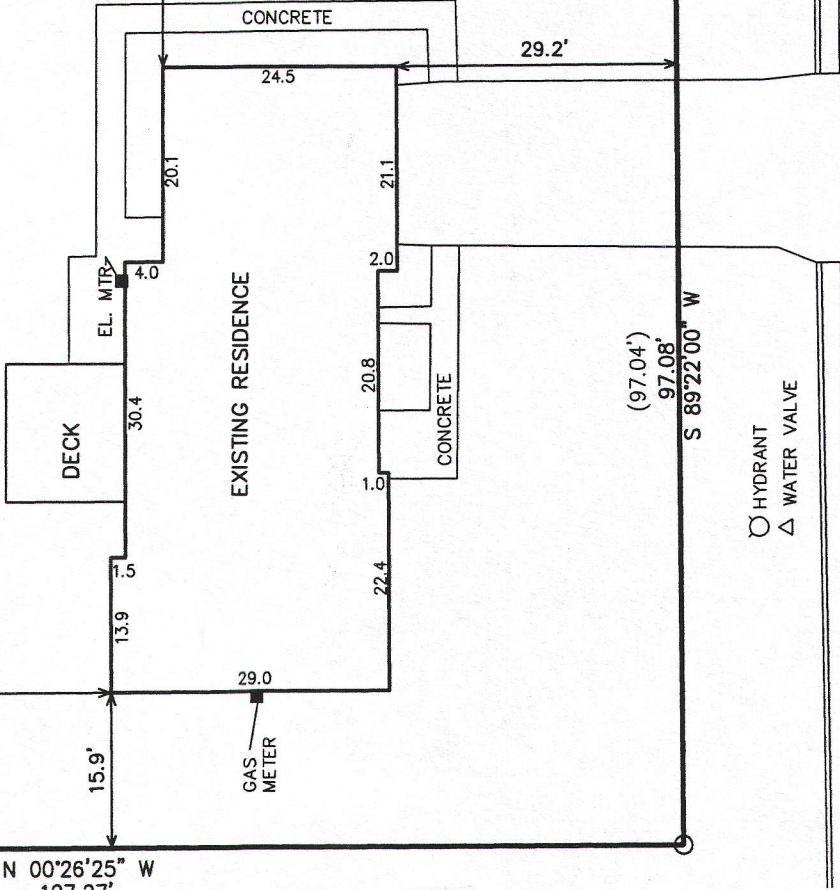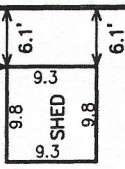

WESTWARD DRIVE (66' WIDE)



NOTE: COPIES OF THIS MAP TO WHICH THE FOLLOWING CERTIFICATE WILL APPLY SHOW SURVEYOR'S ORIGINAL SEAL AND SIGNATURE IN RED INK. COPIES BY ANY OTHER MEANS MAY HAVE ALTERATIONS WHICH DO NOT REPRESENT THE SURVEYOR'S WORK PRODUCT.


I HEREBY CERTIFY THAT THE ABOVE DESCRIBED PROPERTY HAS BEEN SURVEYED UNDER MY DIRECTION AND THAT THE ABOVE MAP IS A TRUE REPRESENTATION THEREOF AND SHOWS THE SIZE AND LOCATION OF THE PROPERTY AND ITS EXTERIOR BOUNDARIES. THIS SURVEY IS MADE FOR THE USE OF THE PRESENT OWNERS OF THE PROPERTY, AND ALSO THOSE WHO PURCHASE, MORTGAGE, OR GUARANTEE THE TITLE THERETO WITHIN ONE YEAR FROM THE DATE HEREOF.

DATED: JULY 8, 2013

Peter S. Gordon

PETER S. GORDON R.L.S. 2101

PROJECT NO. 8834
DATED: 07-08-2013
SHEET 1 OF 1 SHEETS

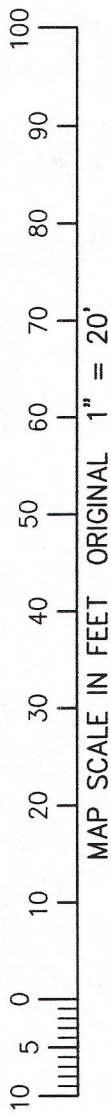

JUL 08 2013

YA, 595-2

004-2393