


60-20

4-23B

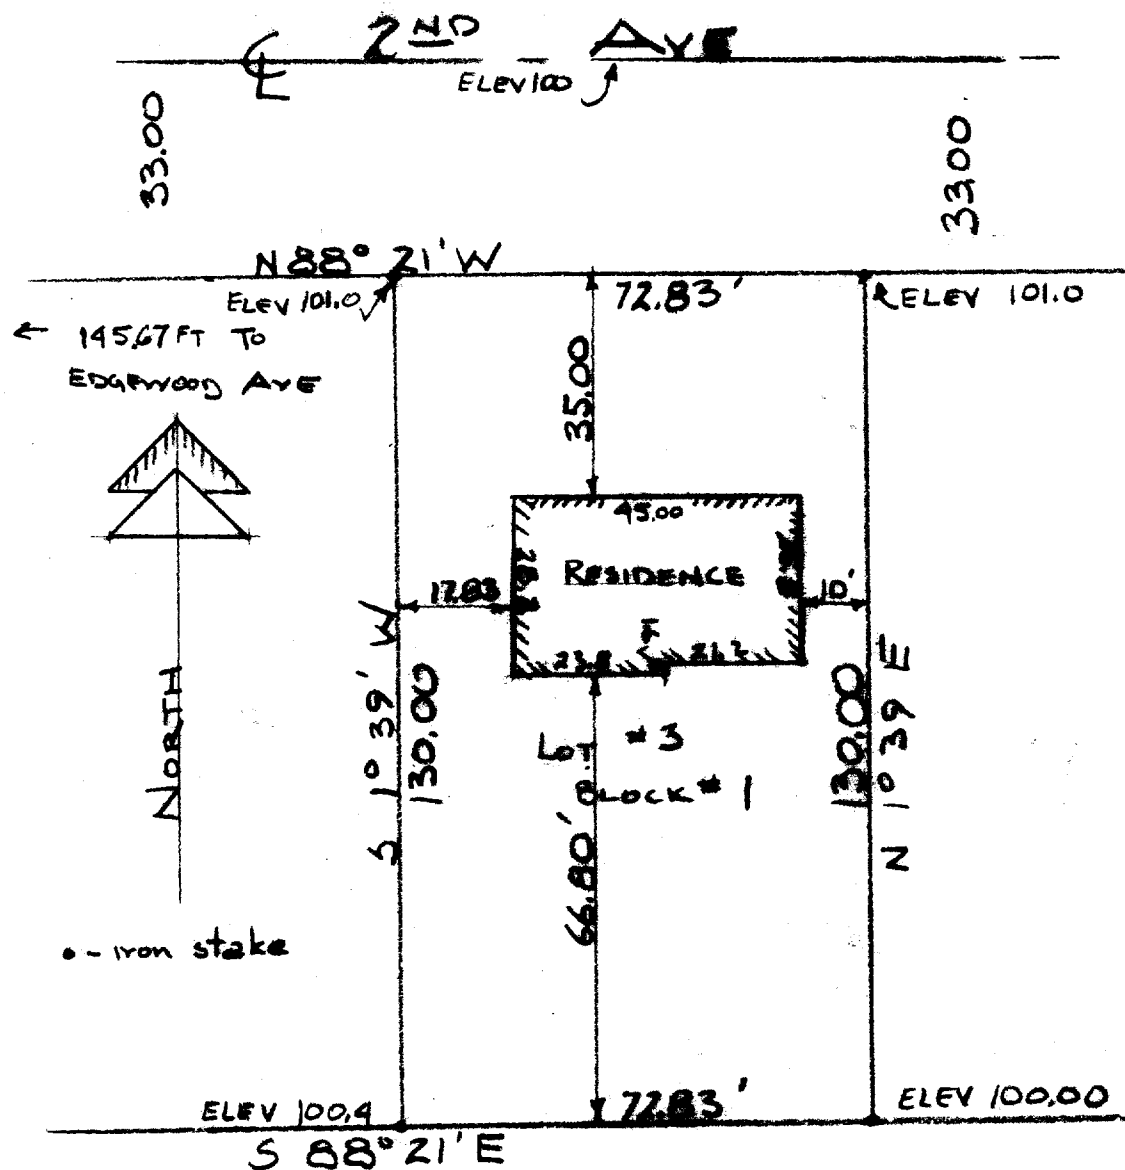


DESCRIPTION: Lot # 3 of Block # 1 of Edgewood Subdivision
in the City of Elkhorn, Walworth County, Wisconsin.

CERTIFICATE: I hereby certify that I have surveyed the
property hereon described and that the location
of all the improvements are as shown hereon.

SIGNED AND SEALED ON OCTOBER 4TH 1960.

James F. Bligh
James F. Bligh (272 RLS)

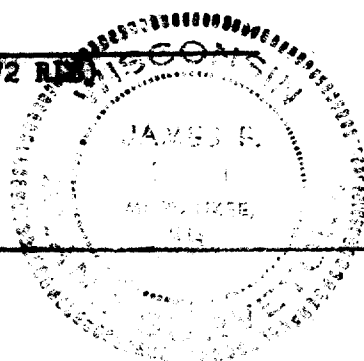

4-23B

YES