


GEORGE T. DUNHAM

SURVEYING & SUBDIVIDING
DELAVER, WISCONSIN

N

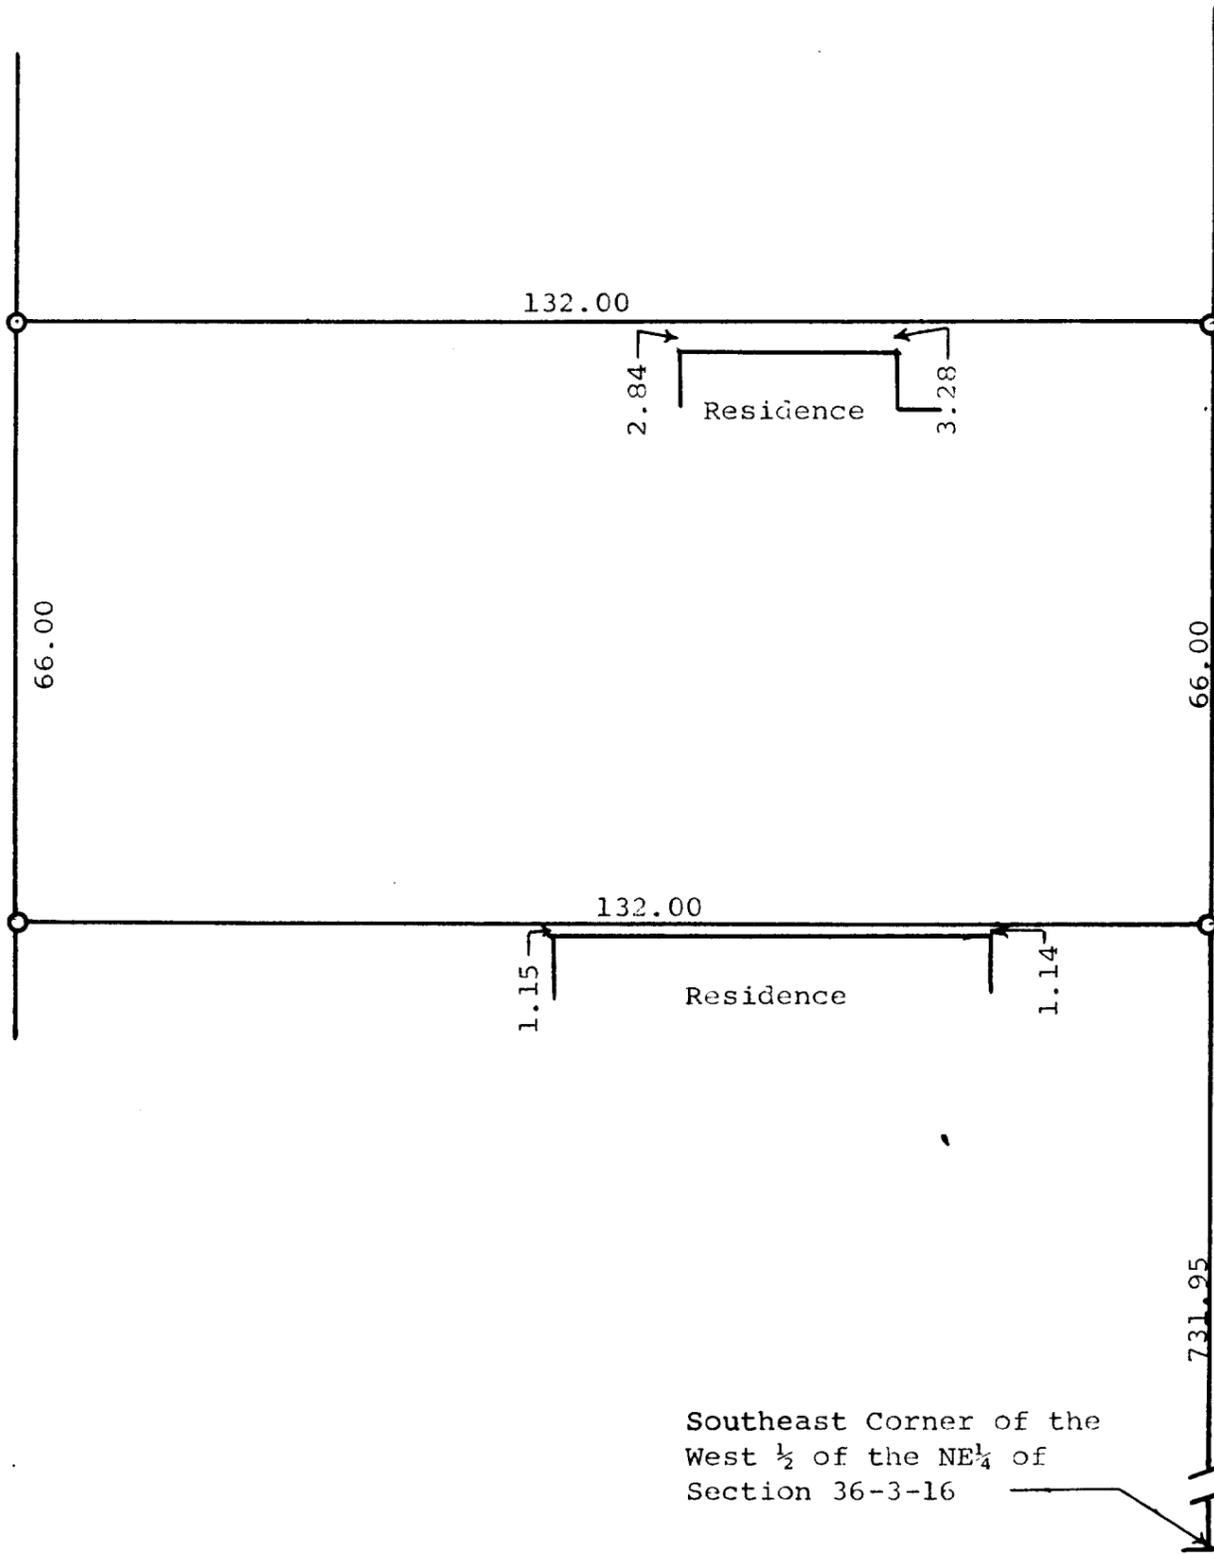

CHURCH
STREET

CHURCH

Scale - 1" = 20'
○ = Iron Pipe or Stake

Southeast Corner of the
West 1/2 of the NE 1/4 of
Section 36-3-16

Plat of survey of a parcel of land located in the West 1/2
of the Northeast 1/4 of Section 36, T 3 N R 16 E, City of
Elkhorn, Walworth County, Wisconsin.
October 26, 1964

George T. Dunham
George T. Dunham, Surveyor

4-29