


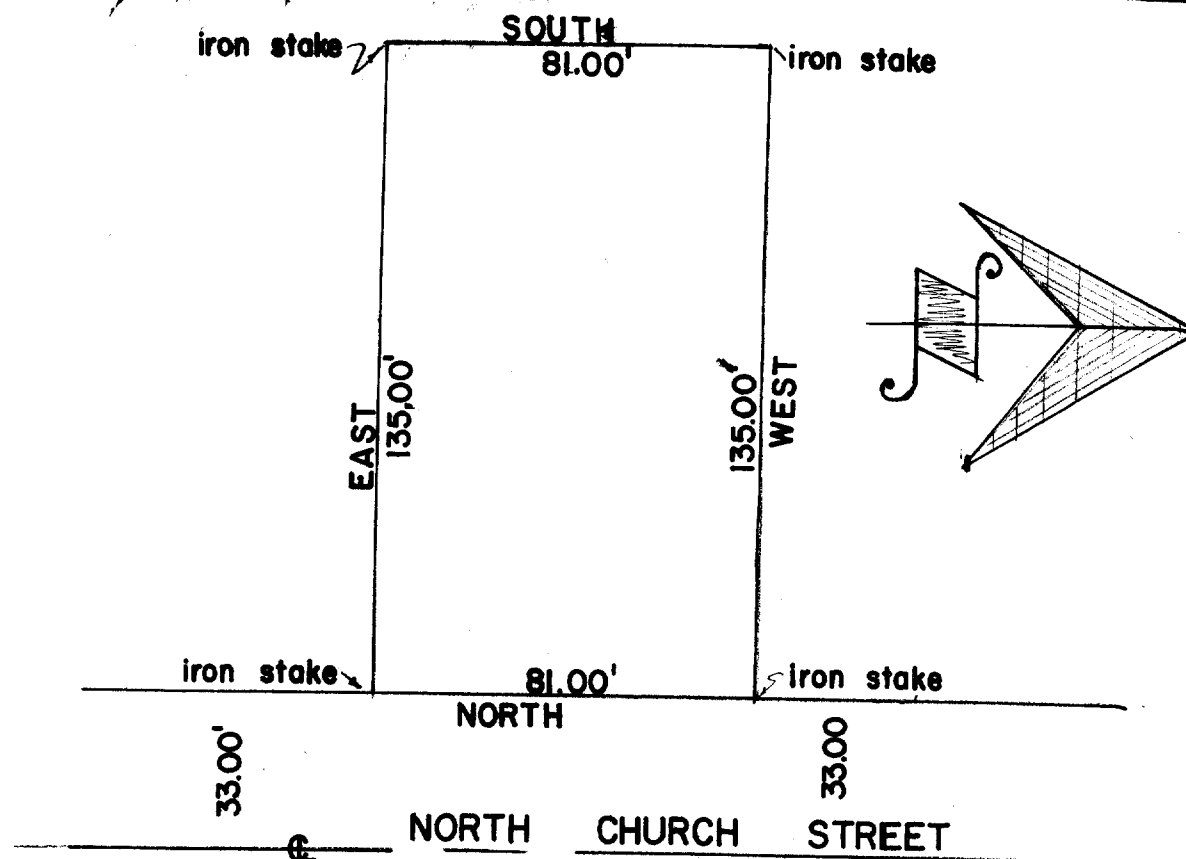

DESCRIPTION: Commencing at an iron stake that is 825.80 feet North of the intersection of the North line of 2nd Ave and the West line of North Church Street in the City of Elkhorn, Wisconsin; thence North in the West line of Church Street 81.00 feet to an iron stake, thence West 135.00 feet to an iron stake, thence South 81.00 feet to an iron stake, thence East 135.00 feet to the place of beginning.

CERTIFICATE: I, James F. Biagi hereby certify that I have surveyed the property hereon described and that the measurements of the external boundaries are in accordance with the drawing shown above.

SIGNED AND SEALED APRIL 25, 1959

*James F. Biagi*