


*99-62

SUNSET DRIVE


161.80' No.

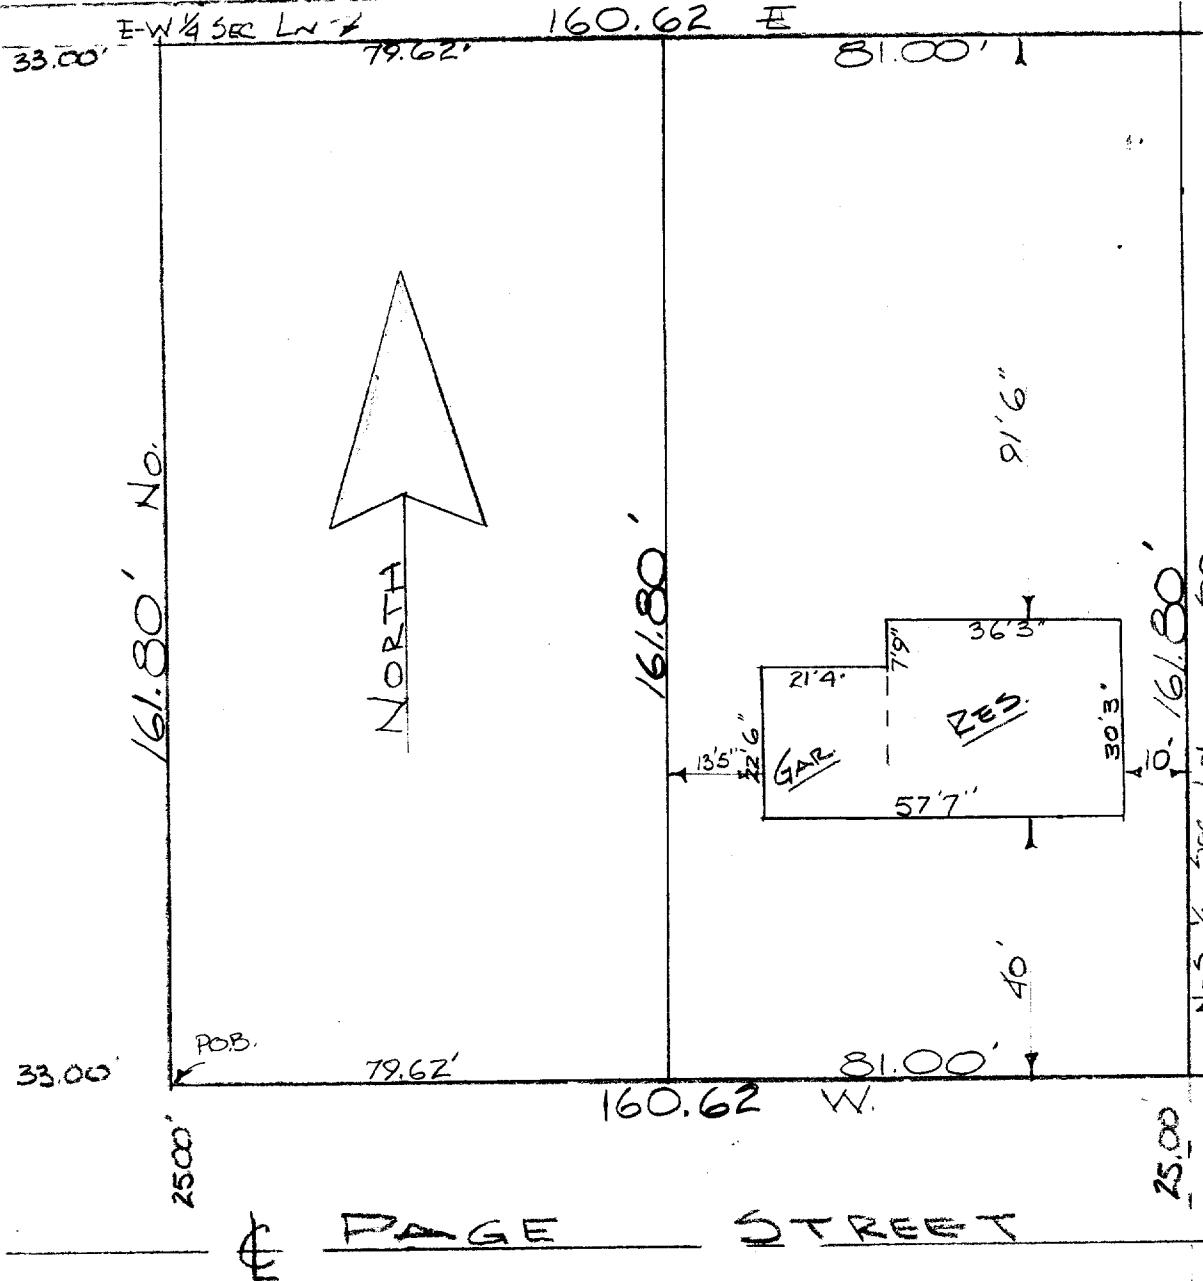

PAGE STREET

DESCRIPTION: The East 81.00 feet of the following described parcel: Commencing at that certain point where the North line of West Page Street in the City of Elkhorn intersects the East line of Sunset Drive; thence North along the East line of Sunset Drive 161.80 feet to a point, thence East 160.62 feet to a point, thence South 161.80 feet to a point in the North line of Page Street aforesaid, thence West along the North line of Page Street 160.62 to the place of beginning; located in the NE $\frac{1}{4}$ of the SW $\frac{1}{4}$ of Sec. 36, T.3N., R.16E. in the City of Elkhorn, Walworth County, Wisconsin.

CERTIFICATE: I, James F. Baigi, surveyor, do hereby certify that I have surveyed the property hereon described and that the location of the improvements are as shown on the drawing above.
January 29, 1962.

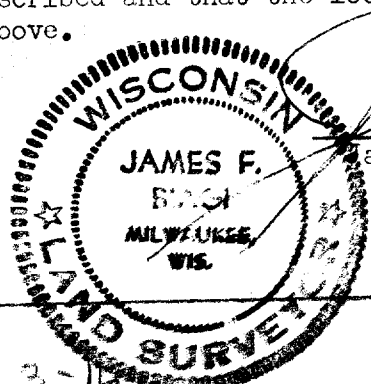

James F. Baigi, RLS 272

U-NW-68

SW $\frac{1}{4}$ 36-3-16

4-241