


4-241B

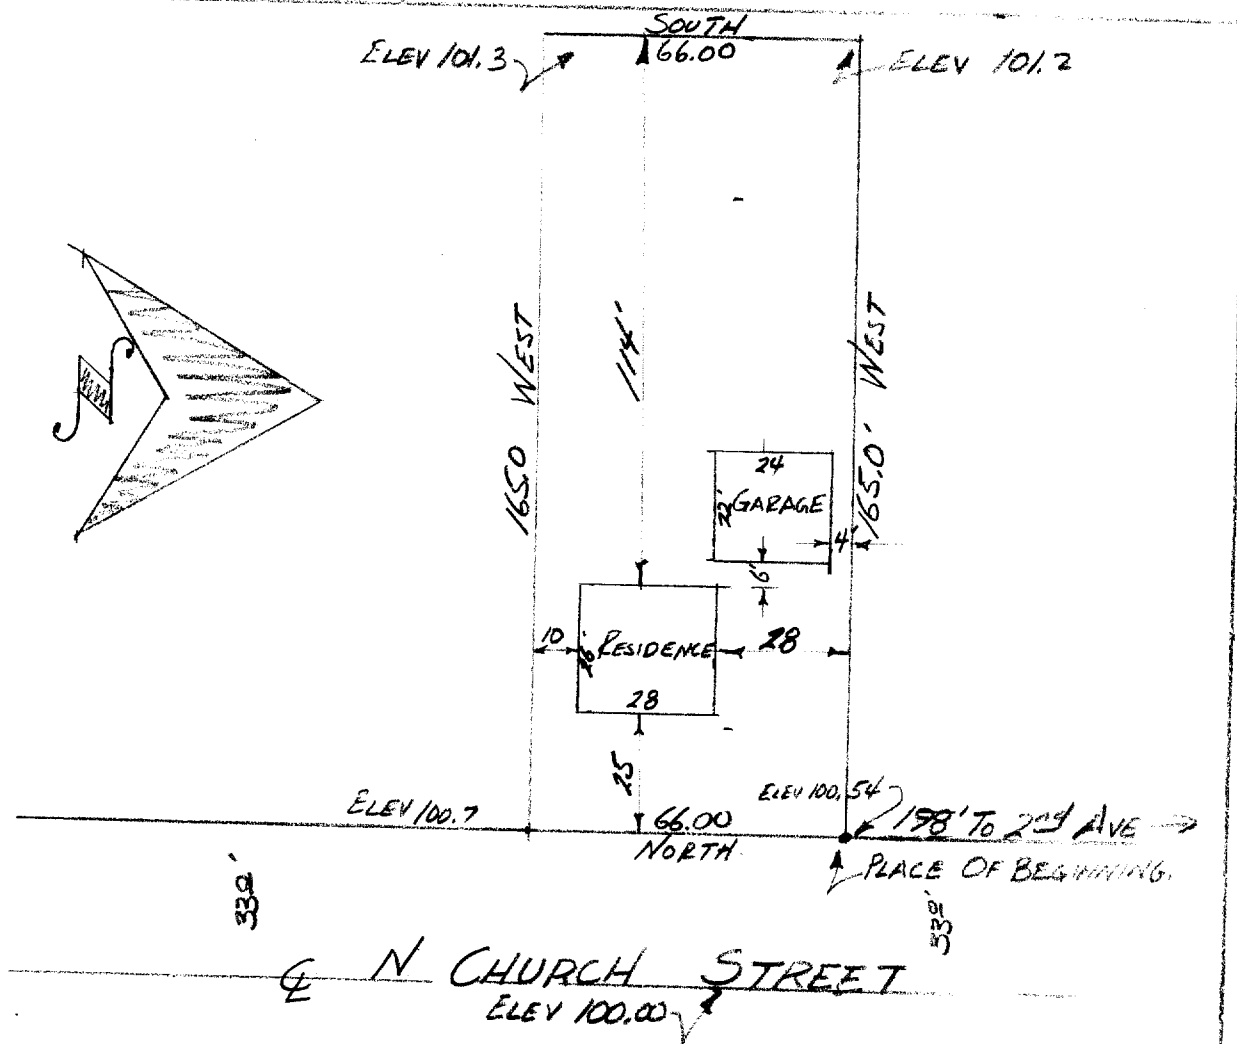

DESCRIPTION: Commencing at a point that is 198.00 feet South of the intersection of the South line of 2nd Ave and the West line of North Church Street in the City of Elkhorn, Walworth County, Wisconsin, thence West 165.00 feet to a point thence, South 66.00 feet to a point, thence East 165.00 feet to a point in the West line of Church Street, thence North along the West line of Church Street 165.00 feet to the place of beginning.

Plat of survey by James F. Biagi, Surveyor 272

*James F. Biagi*

U-NW-24

NE 1/4 36-3-16

4-241B