


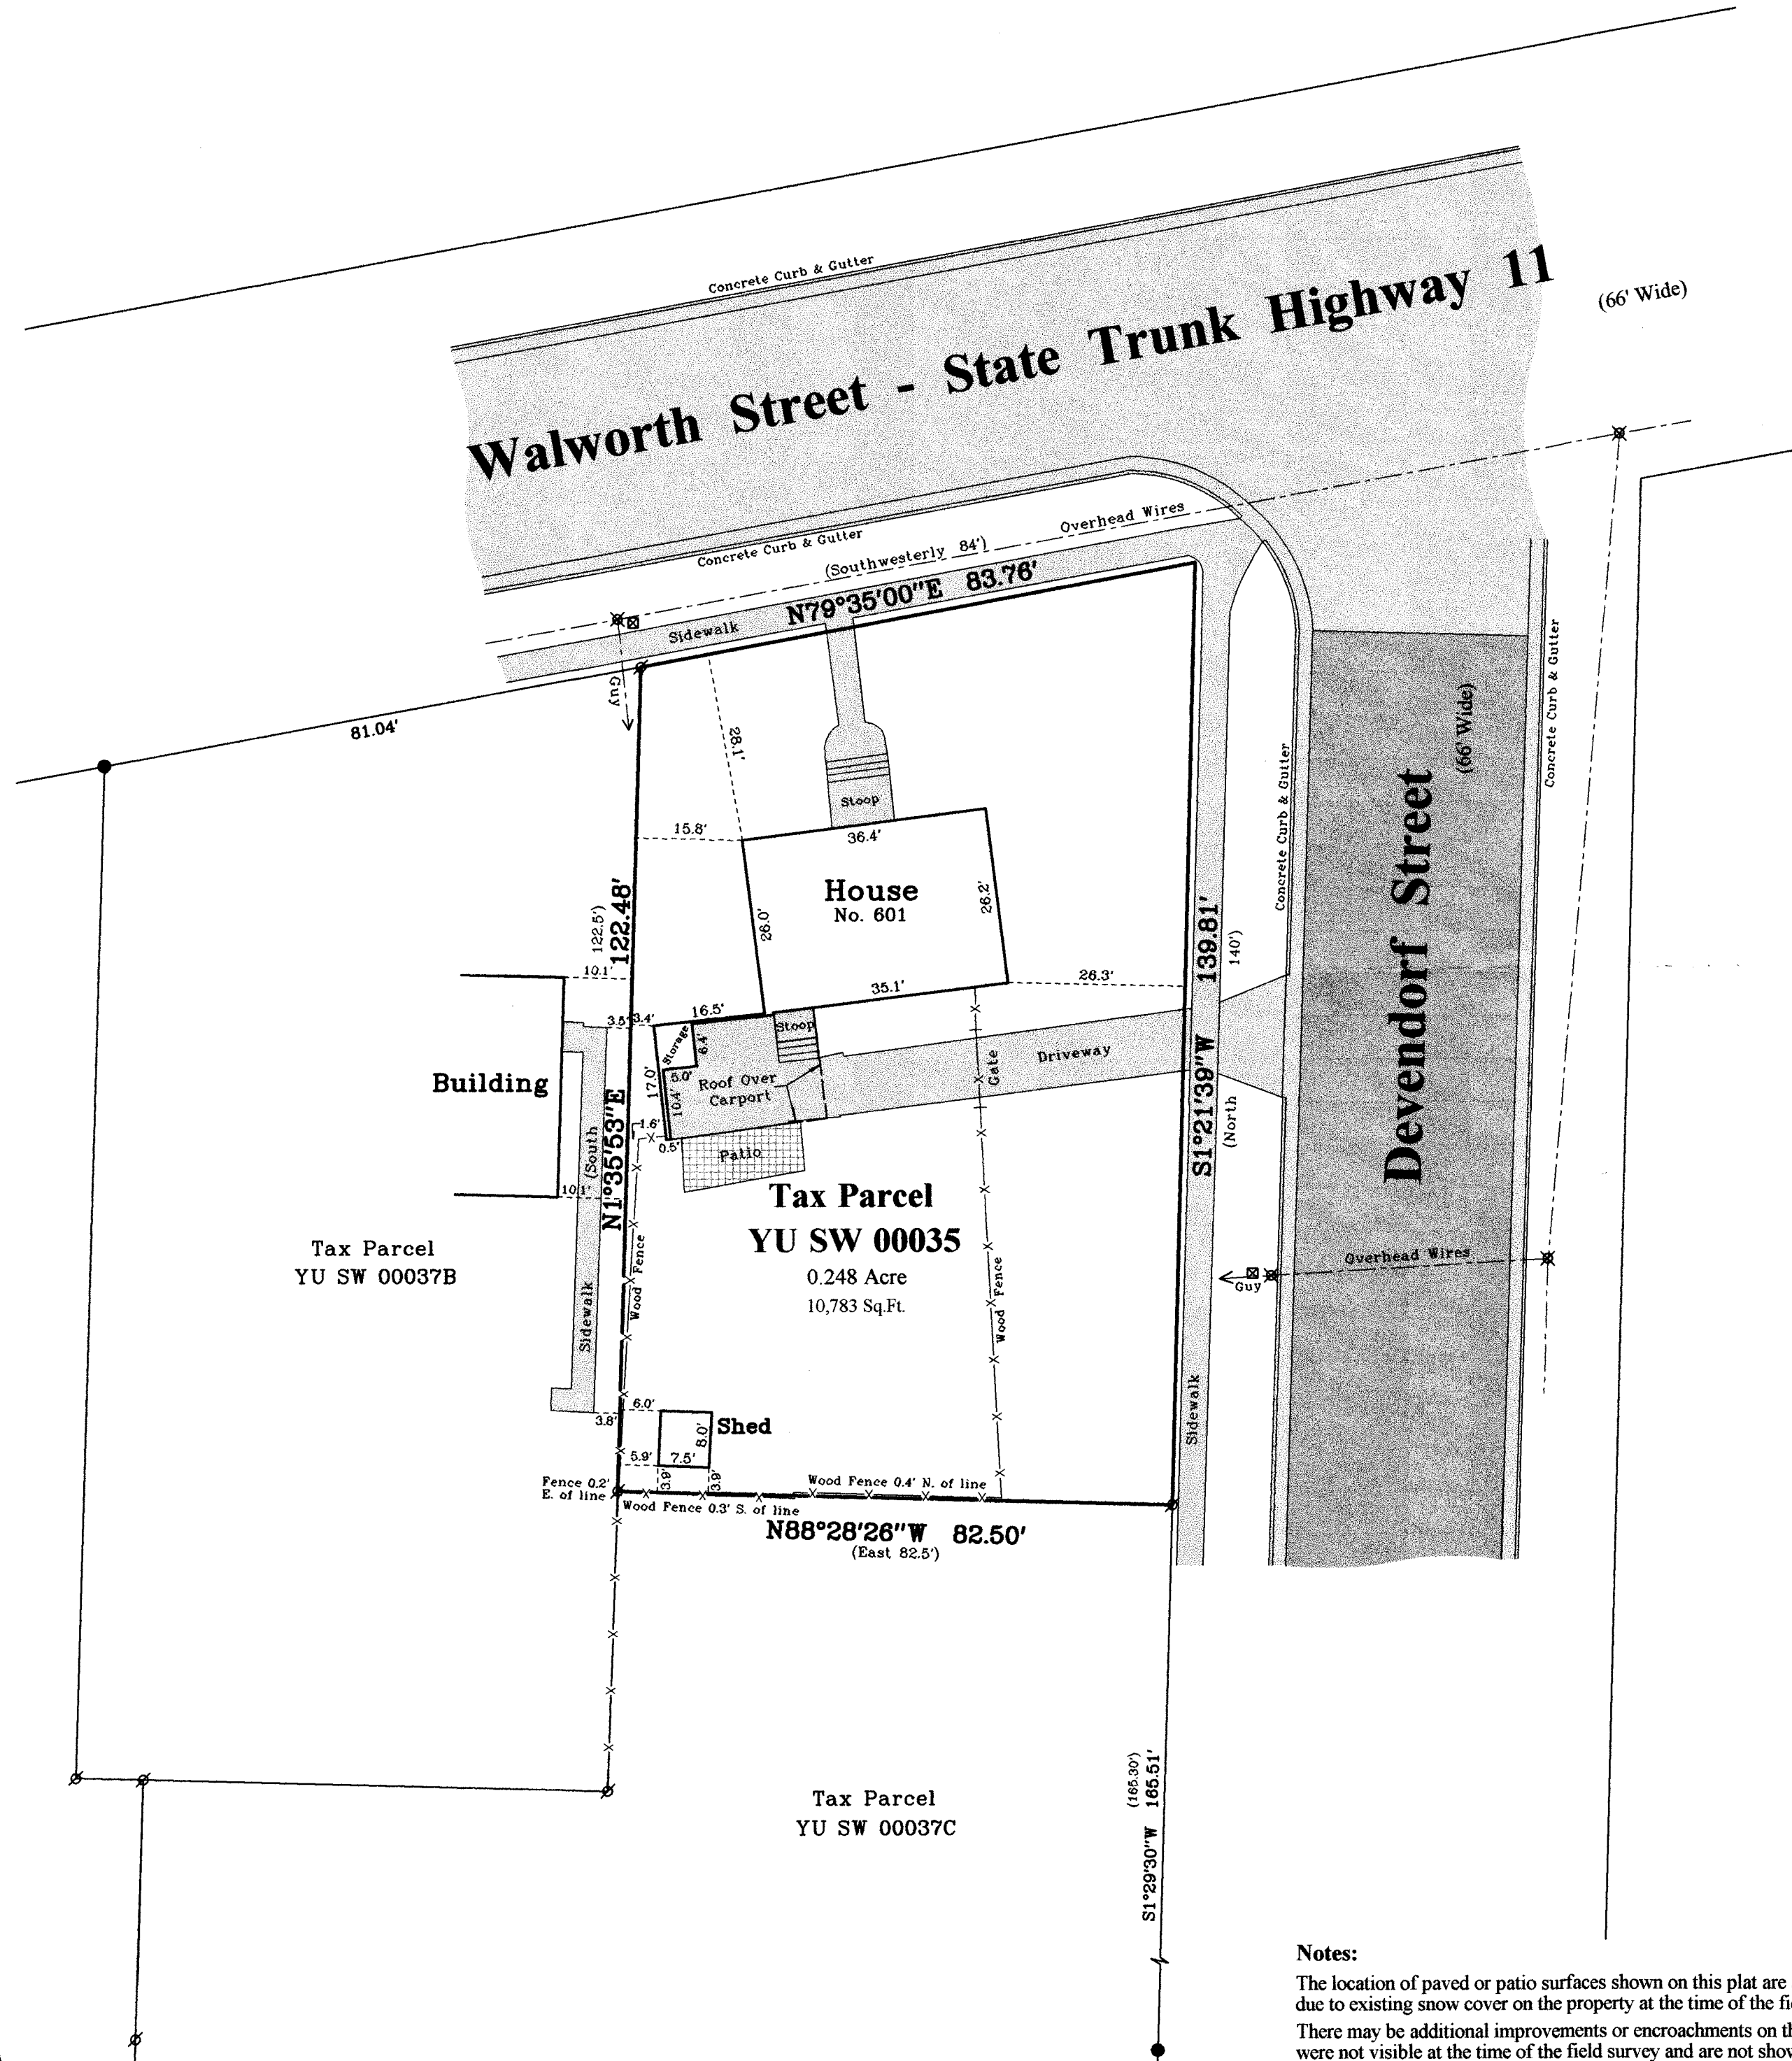


Plat of Survey

of
Tax Parcel YU SW 00035,
located in the Southwest 1/4 of Section 36, Town 3 North, Range
16 East, City of Elkhorn, Walworth County, Wisconsin.



Legal Description
A parcel of land described in a Warranty Deed recorded October 23, 2006 as Document No.
691461 as shown below:

A PARCEL OF LAND LOCATED IN THE SOUTHEAST 1/4 OF THE SOUTHWEST 1/4 OF
SECTION 36, TOWNSHIP 3 NORTH, RANGE 16 EAST, IN THE CITY OF ELKHORN,
COUNTY OF WALWORTH, STATE OF WISCONSIN. BEGIN AT A STAKE SET IN THE
WEST LINE OF DEVENDORF STREET, IN THE SOUTHEAST 1/4 OF THE SOUTHWEST
1/4 OF SECTION 36, IN TOWNSHIP 3 NORTH, RANGE 16 EAST, SAID POINT BEING
114.6 FEET NORTH AND 887.3 FEET WEST OF THE SOUTH 1/4 CORNER OF SAID
SECTION; THENCE NORTH IN THE WEST LINE OF SAID DEVENDORF STREET 140
FEET TO A STAKE SET IN THE SOUTH LINE OF WALWORTH STREET; THENCE
SOUTHWESTERLY IN SAID SOUTH LINE OF WALWORTH STREET 84 FEET TO A
STAKE; THENCE SOUTH, PARALLEL WITH THE WEST LINE OF DEVENDORF
STREET 122.5 FEET; THENCE EAST 82 1/2 FEET TO THE PLACE OF BEGINNING.

Surveyed for: **Keefe Real Estate, Inc.**
751 Geneva Parkway
Lake Geneva, Wisconsin. 53147

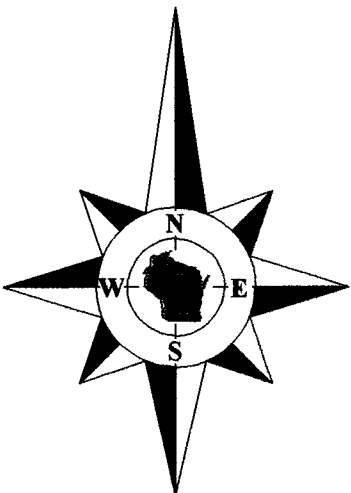

Bearings reference to prior
surveys of record.

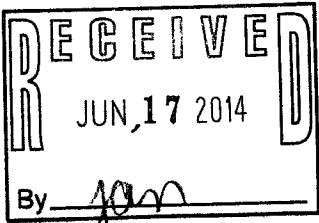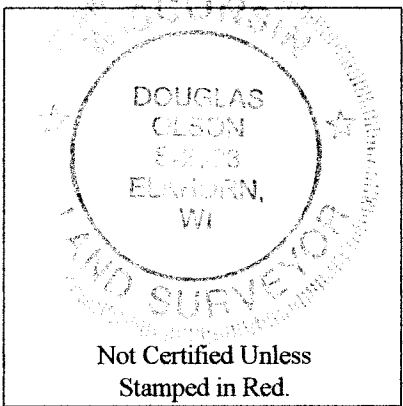

Notes:

- 1) This survey plat is not
certified unless signed
and sealed in red ink.
- 2) This survey is subject to Wisconsin lien laws.
This Plat of Survey is the notice of intent
to file lien. Lien waiver required.


Copyright 2014 by Jensen & Olson Land Surveying, LLC.

All rights reserved. No part of this survey plat may be reproduced or transmitted in
any form by any means - graphic, electronic, or mechanical, including photocopying,
tracing, or information storage and retrieval systems - without permission in writing
from Douglas G. Olson, Jensen & Olson Land Surveying, LLC.

I hereby certify that I have surveyed the above described property and the map
hereon is correct to the best of my professional knowledge and belief and shows the size
and location of the property, its exterior boundaries, the location and dimensions of all
visible structures thereon, boundary fences, apparent easements and roadways and
visible encroachments, if any.
This survey is made for the exclusive use of the present owners of the property,
and also those who purchase, mortgage or guarantee title thereto, within one year from
the date hereof.

Douglas G. Olson
Wisconsin Registered Land Surveyor - 2093

Survey Date: January 2, 2014.
Revisions:

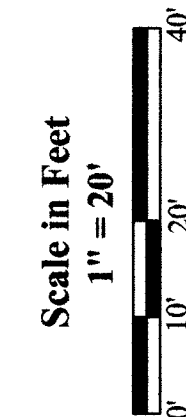

Jensen & Olson Land Surveying, LLC
45 South Wisconsin Street * P.O. Box 322 * Elkhorn, Wisconsin. 53121
Telephone: (262) 723-3434 * Facsimile: (262) 723-8044
Email: jensen.olson@elknet.net

Legend
Found Iron Pipe
Found Iron Rod
Found Information
Utility Pedestal
Asphalt Surface
Concrete Surface
Patio Blocks

Sheet 1 of 1 Sheets
Drawing Name: G:\142-2013\142Plat.sjg
Job Reference Number
2013.142

2013.142

YU SW -35 004-2423