

PREPARED FOR:  
LAKE GENEVA AREA REALTY  
101 BROAD ST  
LAKE GENEVA, WI.



# PLAT OF SURVEY

- OF -

PATHFINDER SURVEYING INC.  
(formerly)  
J.K. SURVEYING INC.  
P.O BOX 322  
LAKE GENEVA, WI. 53147  
WWW.PATHFINDERSURVEYING.NET  
262-248-8303

LOT 54 OF JACKSON CREEK EAST SUBDIVISION, LOCATED IN  
THE SW AND SE 1/4'S OF THE SW 1/4 OF SECTION 7, TOWN  
2 NORTH, RANGE 17 EAST, CITY OF ELKHORN, WALWORTH  
COUNTY, WISCONSIN.

## SOUTH CREEK DRIVE (platted as 66' wide)

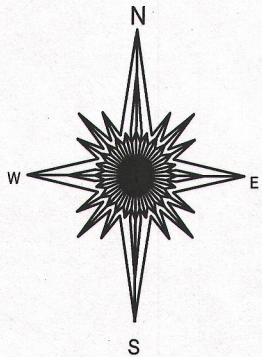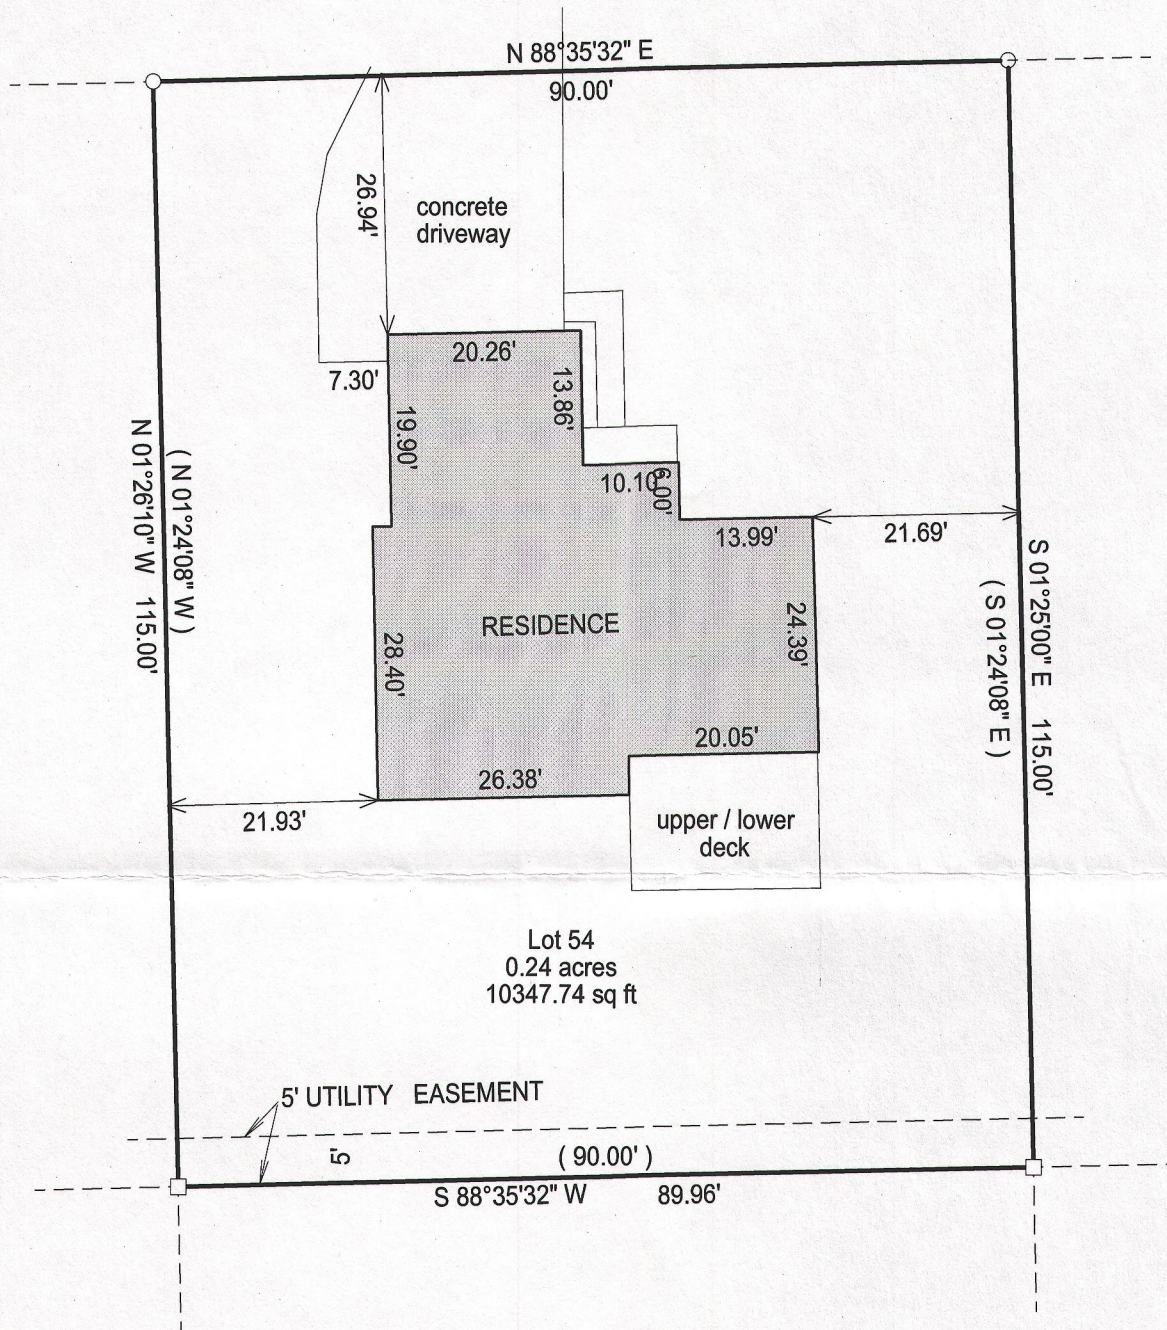

- ( ) = recorded as  
□ = found iron bar  
○ = found iron pipe  
● = set iron pipe  
■ = set iron bar

SCALE 1" = 20'

JOB # 14-226



TAX ID # YJCE00054

20 0 20 40 60  
BASIS OF BEARING OF THIS PLAT: THE SOUTH LINE  
OF SOUTH CREEK DRIVE WAS ASSUMED TO BEAR  
N88°35'32" E AS SHOWN ON THE RECORD PLAT.

I hereby certify that I have surveyed the above- described property and the  
above map is a true representation thereof and shows the size and  
location of the property, its exterior boundaries, the location and  
dimensions of all structures thereon, fences, apparrant easements and  
roadways and visible encroachments if any.

This survey is made for the present owners of the property, and those who  
purchase, mortgage, or guarantee the title thereto, within one year from  
the date hereof.

DATED THIS 25TH DAY OF SEPTEMBER, 2014.

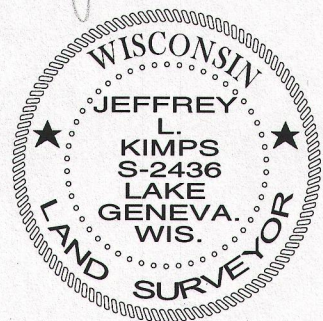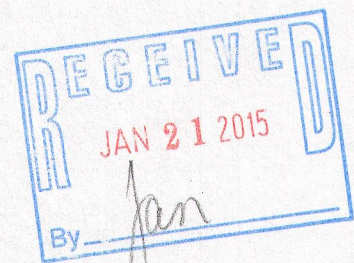

JEFFREY L. KIMPS S - 2436  
Wisconsin Registered Land Surveyor  
(original if signed in red)

YJCE - 54 004 - 2445