

PREPARED FOR
JANE St. JOHN
COLDWELL BANKER HONIG-BELL
226 BROAD ST.
LAKE GENEVA, WI. 53147


PLAT OF SURVEY

- OF -

PATHFINDER SURVEYING INC.
(formerly)
J.K. SURVEYING INC.
P.O. BOX 322
LAKE GENEVA, WI. 53147
WWW.PATHFINDERSURVEYING.NET
262-248-8303

LOTS 5, 6, 7, 8, 9 AND THE EAST 11 FEET OF LOT 10, LOT 11, AND LOTS 14 THROUGH 24, BLOCK 2, TOGETHER WITH THE EAST 25 FEET OF VACATED PRAIRIE AVE, LYING ADJACENT TO LOTS 11, 14, 15, 18, 19, 22 AND 23 AND THE WEST 25 FEET OF VACATED LOGAN AVENUE LY ADJACENT TO LOTS 16, 17, 20, 21 AND 24 ALL IN BLOCK 2 OF ELKHORN GARDENS, A SUBDIVISION LOCATED IN THE NW 1/4 OF SECTION 1, TOWN 1 NORTH, RANGE 16 EAST, CITY OF ELKHORN, COUNTY OF WALWORTH AND STATE OF WISCONSIN.

GENEVA STREET


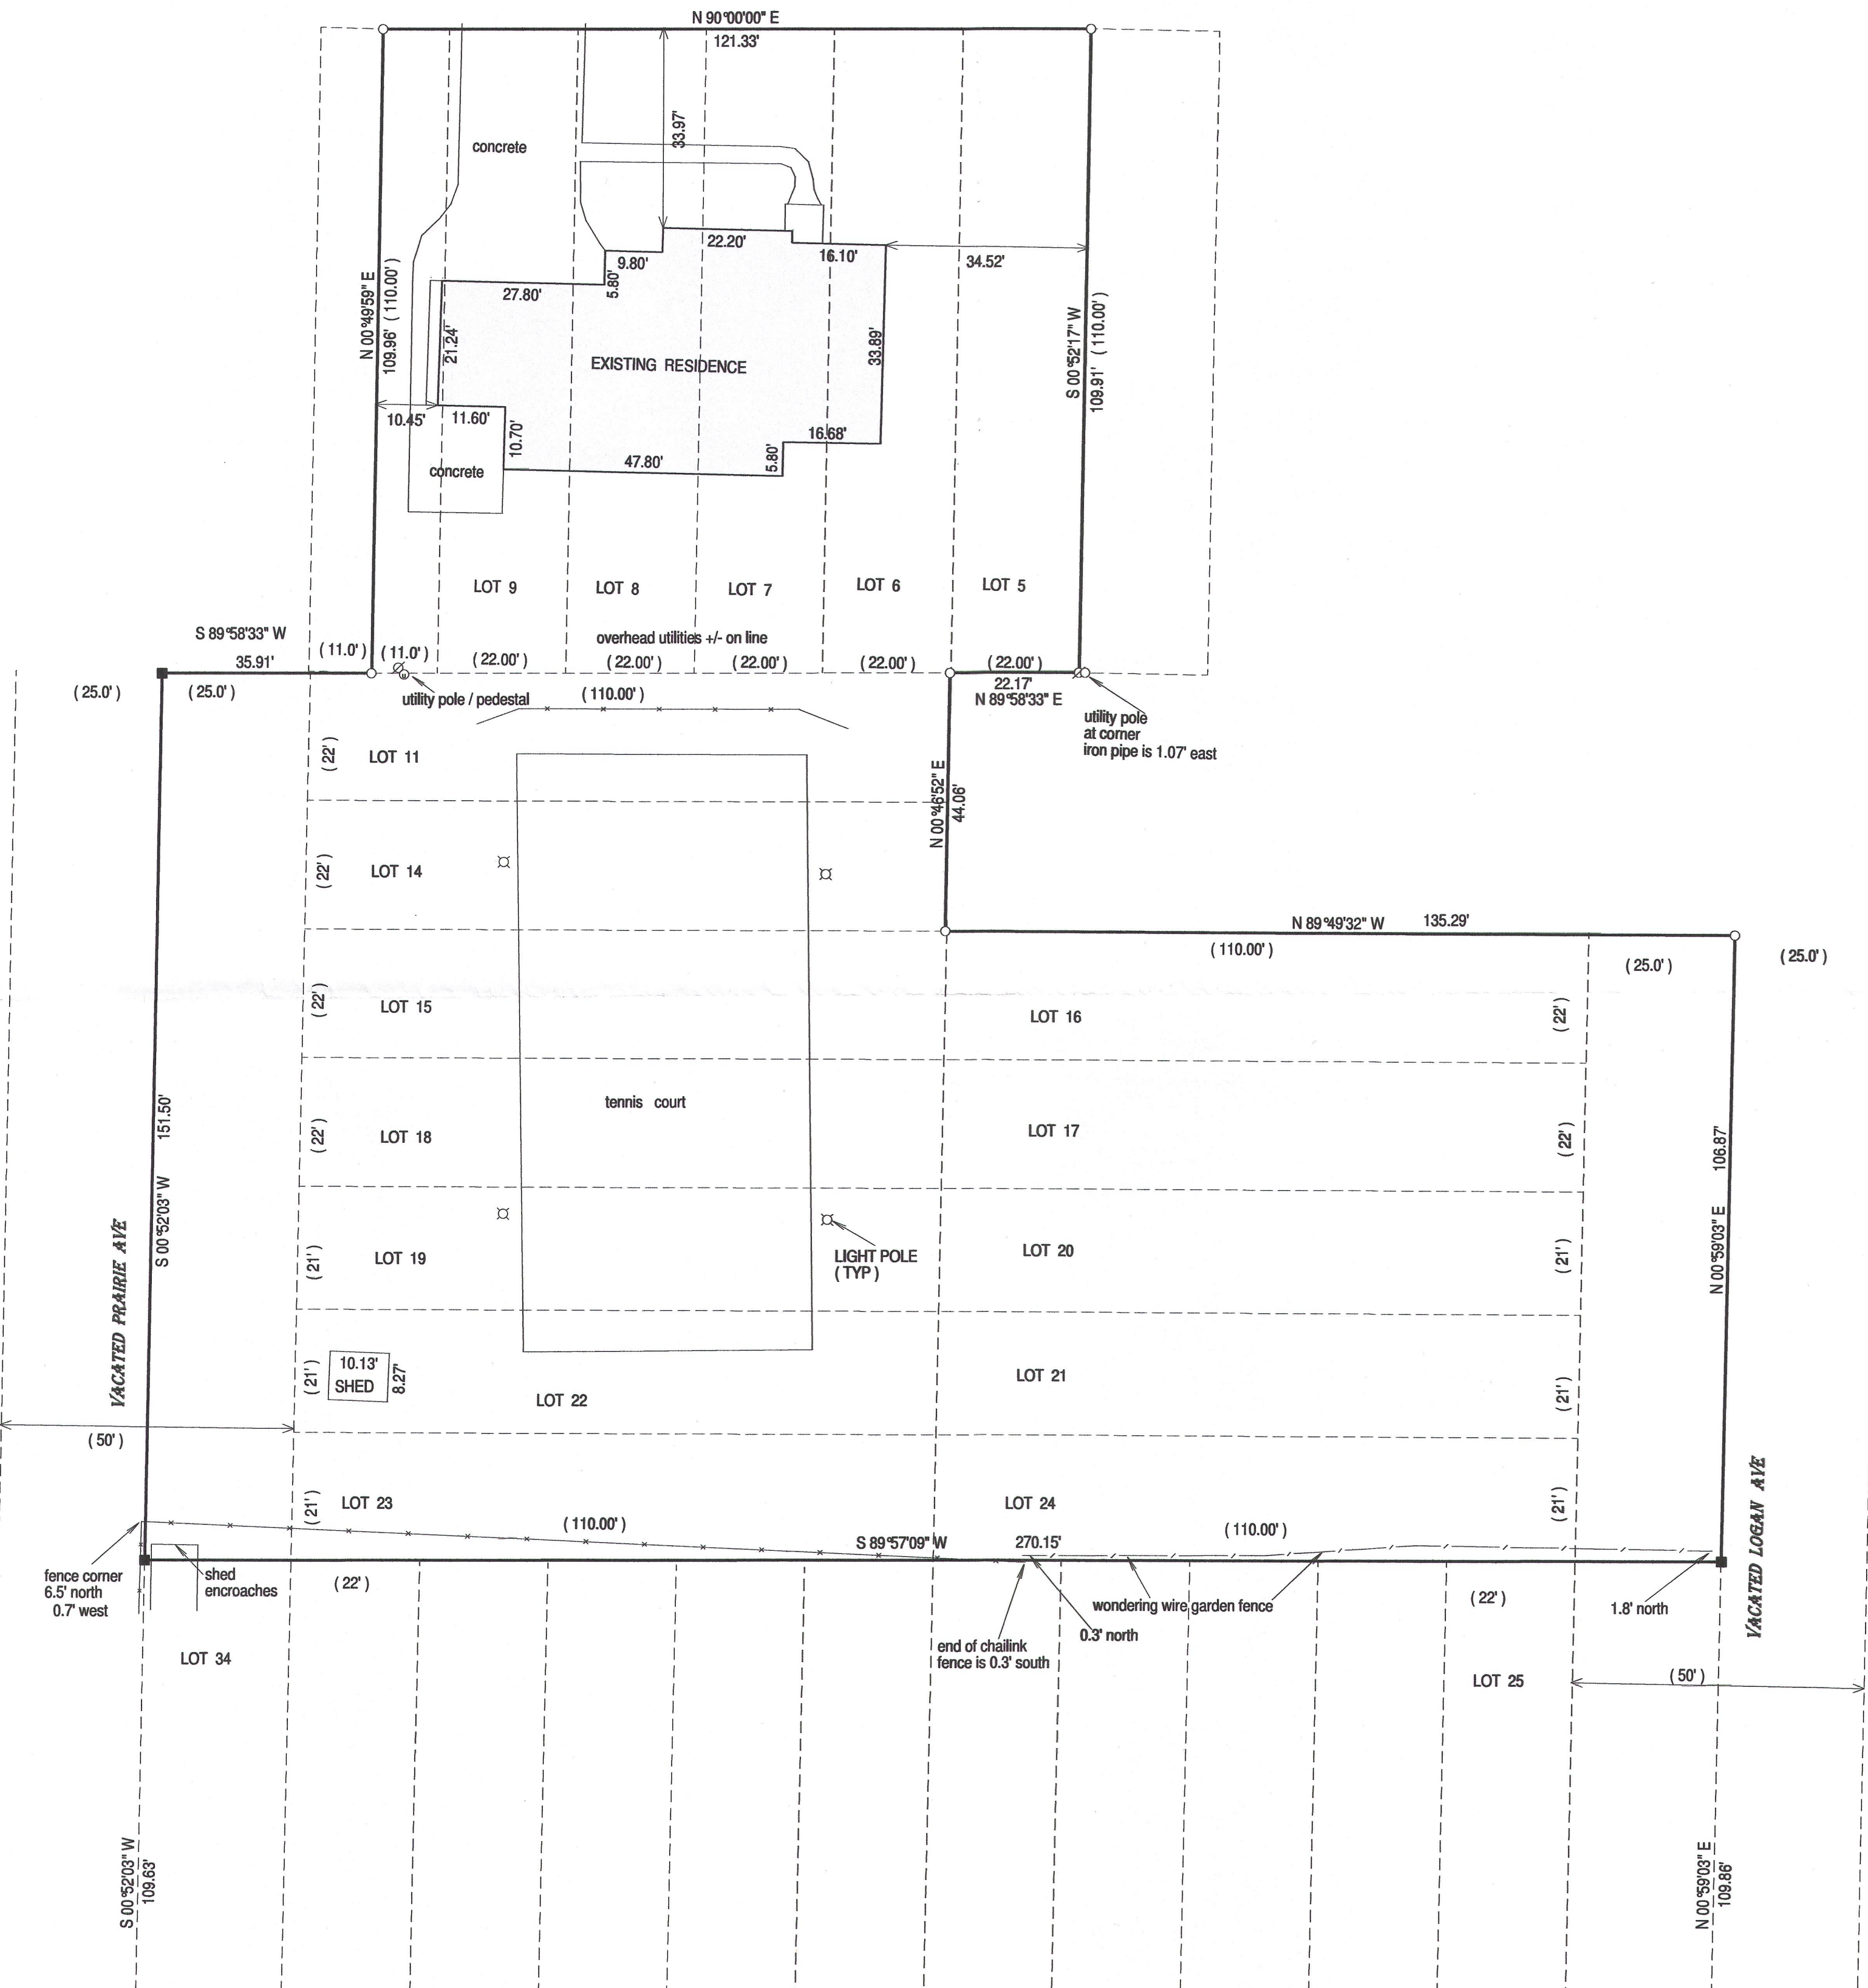


- () = recorded as
- = found iron bar
- = found iron pipe
- = set iron pipe
- = set iron bar

SCALE 1" = 20'

JOB # 15-113

TAX ID #
YEN00007, 00009, 00013, 00014, 00011

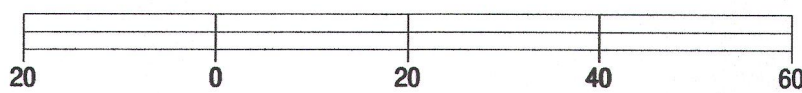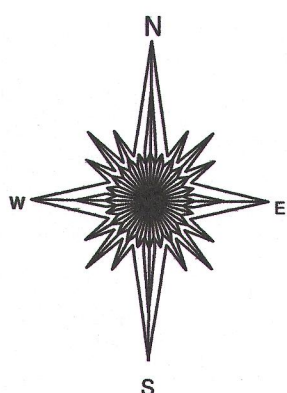


BASIS OF BEARING OF THIS PLAT: THE SOUTH LINE OF GENEVA ST. WAS ASSUMED TO BEAR EAST.

I hereby certify that I have surveyed the above-described property and the above map is a true representation thereof and shows the size and location of the property, its exterior boundaries, the location and dimensions of all structures thereon, fences, apparent easements and roadways and visible encroachments if any.

This survey is made for the present owners of the property, and those who purchase, mortgage, or guarantee the title thereto, within one year from the date hereof.

DATED THIS 24TH DAY OF APRIL, 2015.

revised 5/1/2015 added additional lots

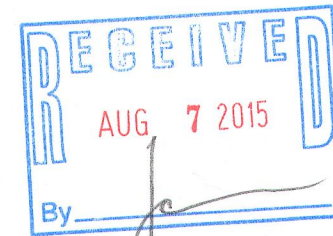

JEFFREY L. KIMPS S-2436
Wisconsin Registered Land Surveyor
(original if signed in red)

YEN-7 YEN-11 YEN-14
YEN-9 YEN-13 004-2468