
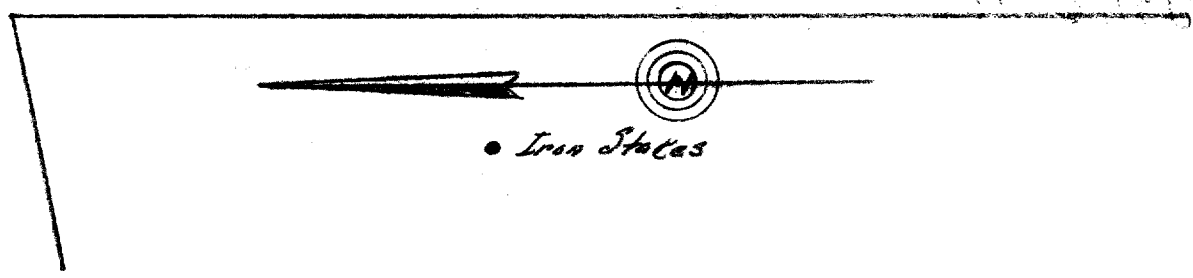


46-21

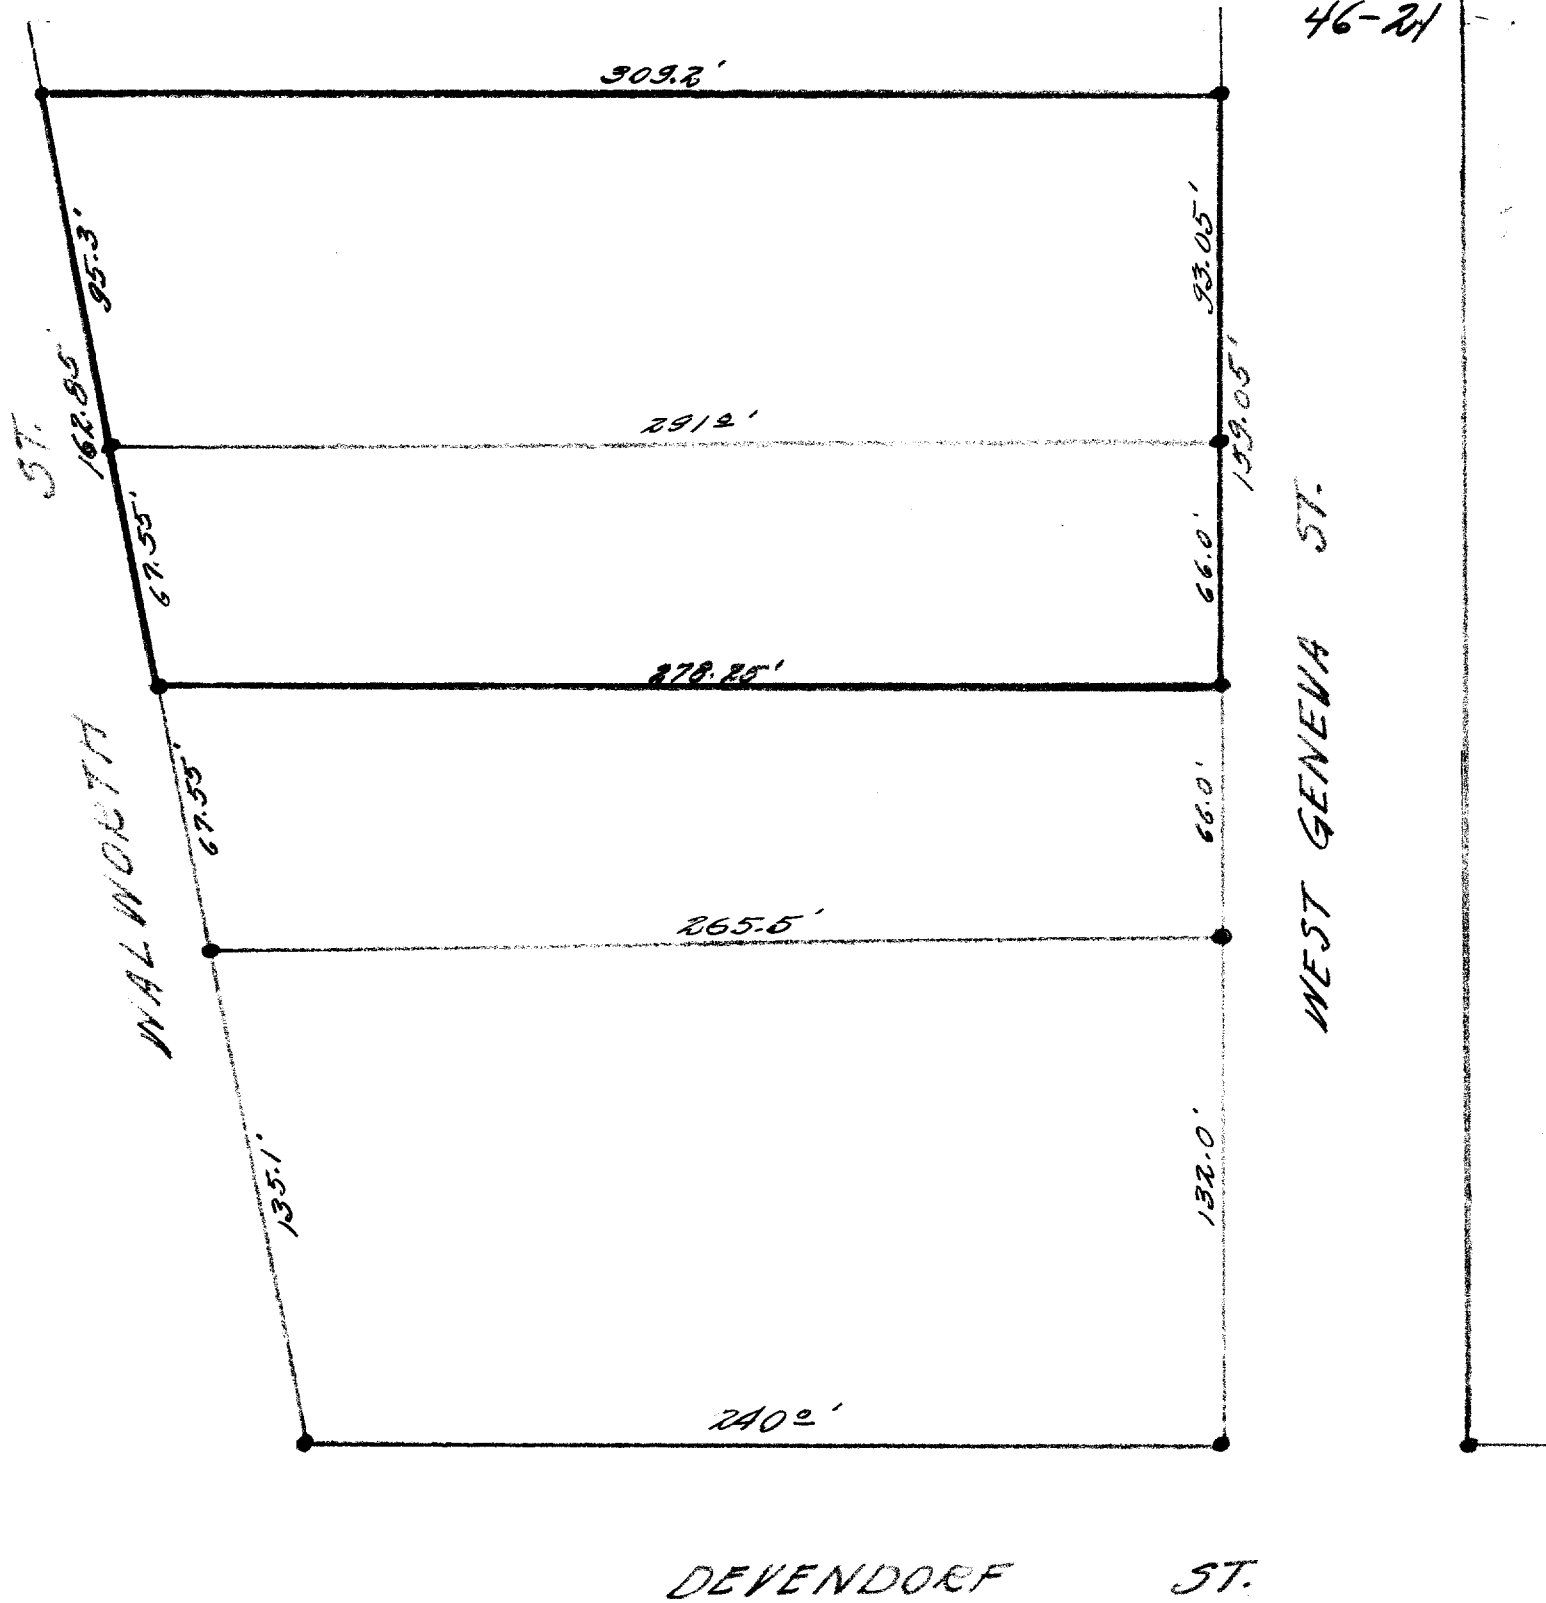

DESCRIPTION: Commencing at an iron stake in the southeasterly line of West Walworth Street, in the City of Elkhorn, Walworth County, Wisconsin, 202.65 feet, N. 79°-35' E., of the intersection of the southerly line of said Walworth Street, and the East line of Devendorf Street, thence N. 79°-35' E., along the southeasterly line of said West Walworth Street, 162.85 feet to an iron stake, thence south parallel with the east line of Devendorf Street, 309.2 feet to an iron stake in the north line of West Geneva Street, thence west along the north line of said West Geneva Street 159.05 feet, to an iron stake, thence north parallel with the east line of Devendorf Street, 278.25 feet to the place of beginning.

CERTIFICATE: I, hereby certify that I have on this the 4th day of March, 1946, surveyed the above described property according to the official records on file in the office of the Recorder of Deeds in and for Walworth County, Wisconsin, and find that the measurements and bearings of the boundary lines of said property as taken on this day substantially agree with those in the above description and that no encroachments exist.
SIGNED AND SEALED THIS 1ST DAY OF MARCH 1946.

Joseph M. Biagi
Joseph M. Biagi
Professional Engineer.
Elkhorn, Wisconsin.

(now U-NW 221
then U-NW-229) (1946)
in SW 1/4 - 36-3-16

4-246B -