



NOTE: ALL MEASUREMENTS ARE TO THE NEAREST 100TH FT

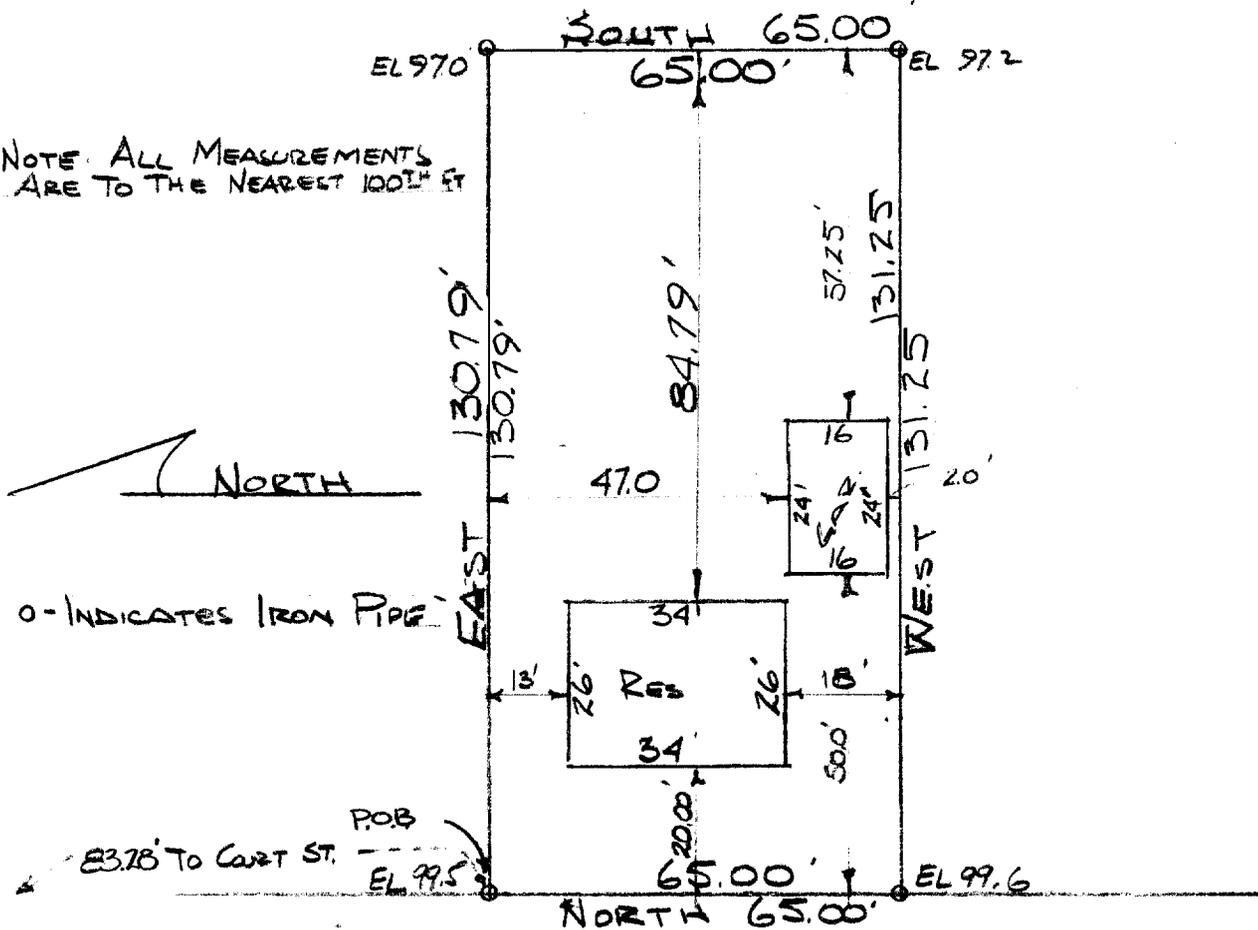

ADAMS STREET  
Ref. EL. 100 42.00' WIDE

DESCRIPTION: A parcel of land in the Southeast quarter of Section 36, Town 3 north, Range 16 east, City of Elkhorn, Walworth County, Wisconsin, described as follows; Commencing at the intersection of the east line of Adams Street and the south line of West Court Street of said city, which is 83.28 feet west of the northeast corner of Block 19 of the Original Plat of the said City of Elkhorn, thence South 83.28 ft. alg. the east line of said Adams Street to the place of beginning; thence East parallel to the south line of West Court Street, 130.79 feet to an iron pipe which is the northwest corner of the land owned by Van Dyke, thence South along said land 65.00 feet, thence West 131.25 feet to the east line of the aforesaid Adams Street, thence North along the east line of said Adams Street 65.00 feet to the place of beginning.

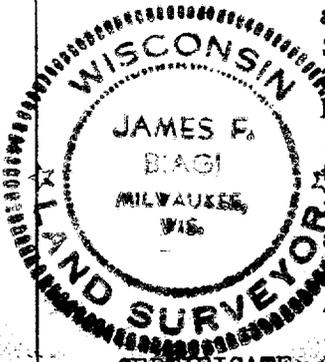

CERTIFICATE: I, James F. Biagi, Surveyor do hereby certify that I have surveyed the property hereon described, and that the location of the improvements are as shown on the drawing above.

September 19th 1962.

James F. Biagi  
James F. Biagi (RS 272)  
Elkhorn, Wisconsin.