


Plat of Survey
LOT 820, EASTOWN MANOR
CONDOMINIUM, located in part of the
Southwest 1/4 of Section 5, Town 2
North, Range 17 East, in the City of
Elkhorn, Walworth County, Wisconsin.


Surveyed for: Dan Andrews
Survey address: 820 S. Eastown
Manor

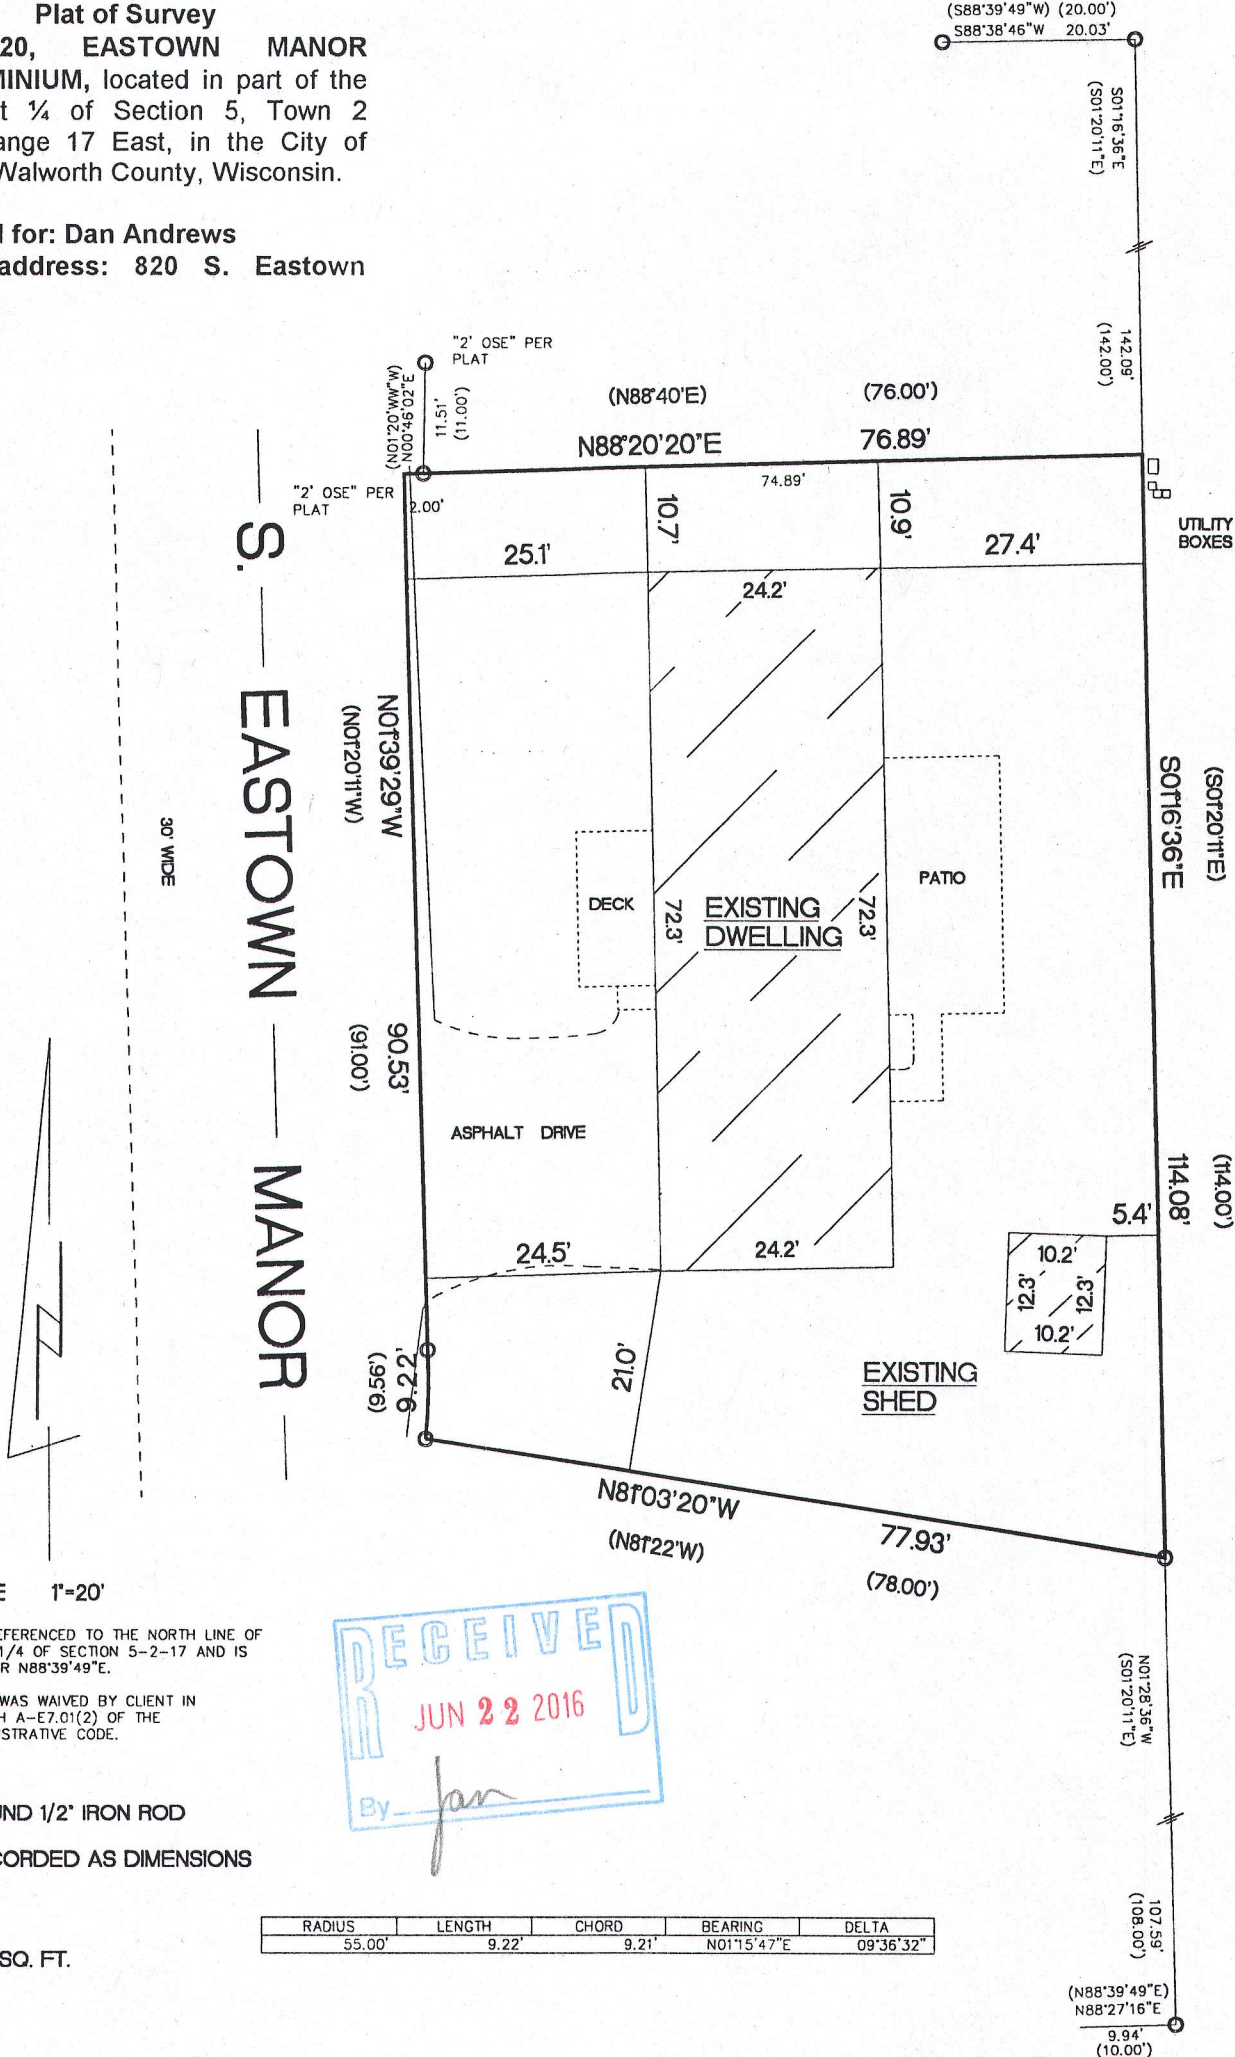

"I hereby certify that I have surveyed the above described property and that the above map is a true representation thereof and shows the size and location of the property, its exterior boundaries, the location of all visible structures and dimensions of all principal buildings thereon, boundary fences, apparent easements, roadways and encroachments if any"

"This survey is made for the use of the present owners of the property, and also those who purchase, mortgage or guarantee the title thereto within one year from date hereof."

KETTLE MORaine SURVEYING INC.
S75 W36245 Wilton Road
Eagle Wisconsin 53119
P.O. Box 357
(262) 594-3484
kettlemorainesurvey.com
Terrance E. Pisarek P.L.S.

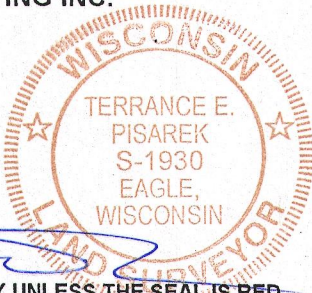

THIS IS NOT AN ORIGINAL SURVEY UNLESS THE SEAL IS RED.

6/20/16	TEP	TEP	16055
DATE	FIELD WORK BY	DRAWN BY	JOB NUMBER

YdT-820 004-2513