



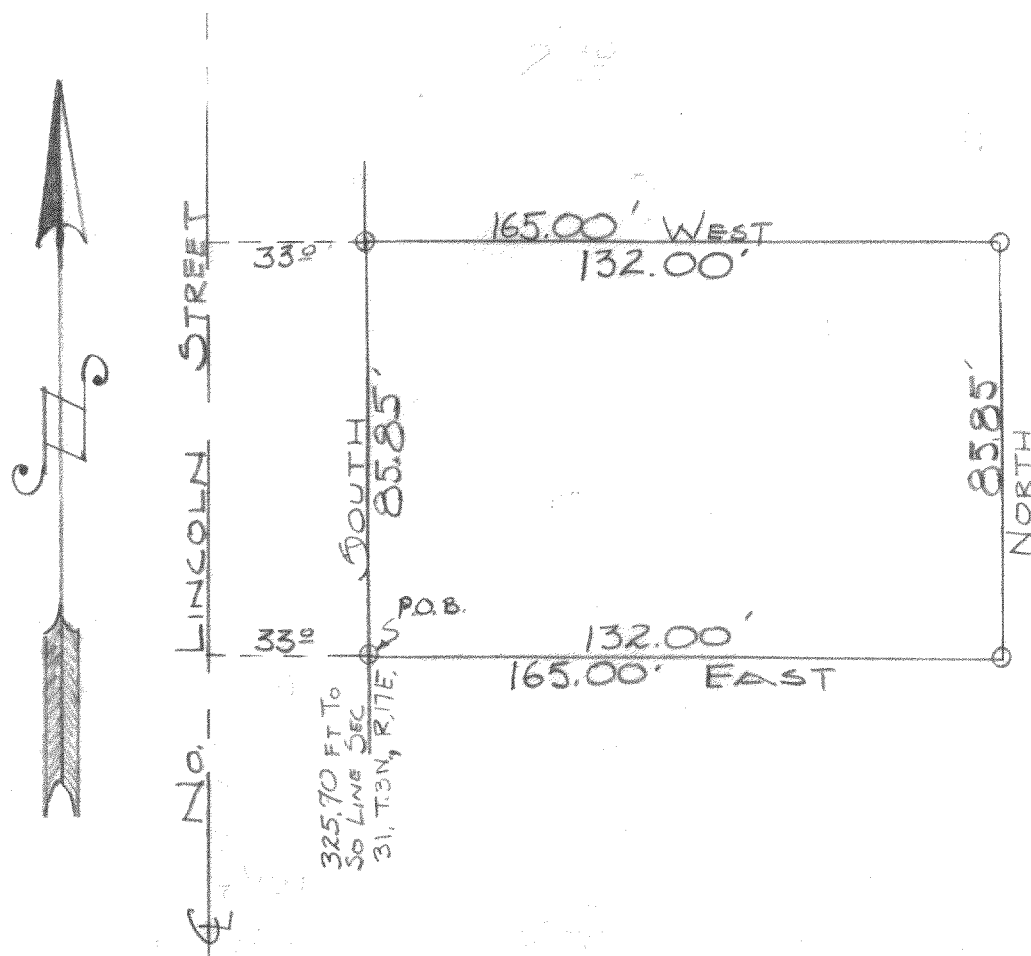

DESCRIPTION: Commencing at an iron stake in the east line of Lincoln Street, that is 325.70 feet north of the intersection of said east line and the south line of the N. W. $\frac{1}{4}$ of Section 31, Town 3 North, Range 17 East in the City of Elkhorn, Walworth County, Wisconsin; thence east 132.00 feet to an iron stake, thence north 85.85 feet to an iron stake, thence West 132.00 feet to an iron stake, thence South 85.85 feet to the P.O.B.

CERTIFICATE I, James F. Biagi surveyor, do hereby certify that I have surveyed the property hereon described and that the drawing is a correct representation of said survey.

SIGNED AND SEALED THIS 6TH DAY OF APRIL, 1960.

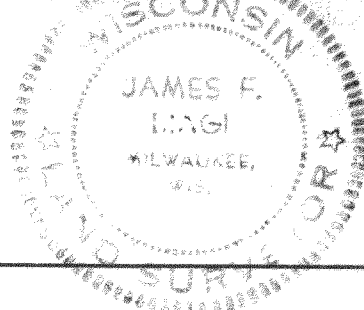

James F. Biagi
James F. Biagi RLS 272