


BUILDING 27 DETAIL

BEING A PART OF THE CONDOMINIUM PLAT OF HARVEST POINTE LOCATED IN
THE NW 1/4 OF THE SW 1/4 OF SECTION 30, TOWNSHIP 3 NORTH, RANGE 17 EAST,
CITY OF ELKHORN, WALWORTH COUNTY, WISCONSIN.


SURVEYOR:
KEITH A. KINDRED, RLS S-2082
SEH-YAGGY
501 MAPLE AVE
DELAFIELD, WI 53018
(414) 949-8919

SURVEY FOR:
BIELINSKI HOMES, INC
1830 MEADOW LANE, SUITE A
PEWAUKEE, WI 53072

- LEGEND**
- - 1" IRON PIPE FOUND
 - ⊙ - NAIL SET
 - - UTILITY BOX
 - ⊗ - CURB STOP
 - Ⓢ - MANHOLE

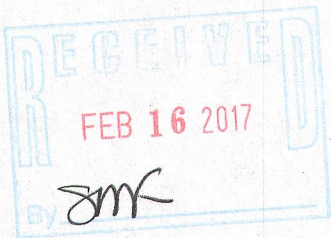

NOTES:
1. UTILITY EASEMENTS SHOWN
PER CONDO PLAT--NO TITLE
POLICY PROVIDED
2. THIS DETAIL IS SUBJECT TO
ALL RESTRICTIONS AND NOTES
SHOWN ON THE EIGHTH
ADDENDUM TO THE
CONDOMINIUM PLAT OF
HARVEST POINTE
CONDOMINIUMS RECORDED AT
WALWORTH COUNTY REGISTER
OF DEEDS OFFICE.

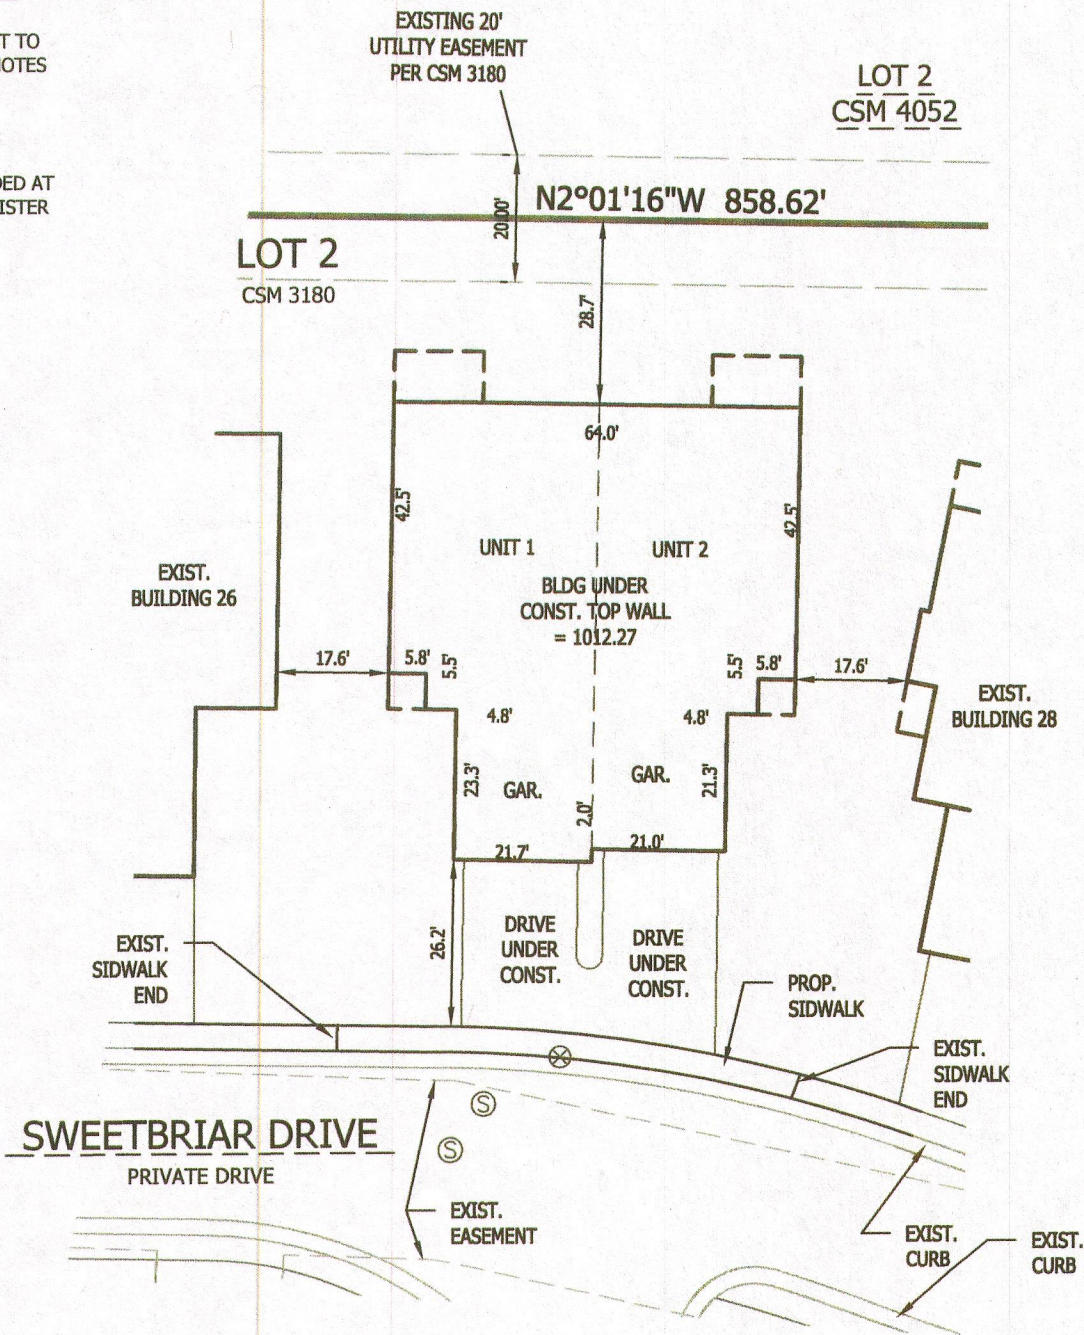

SCALE IN FEET
0 15 30