


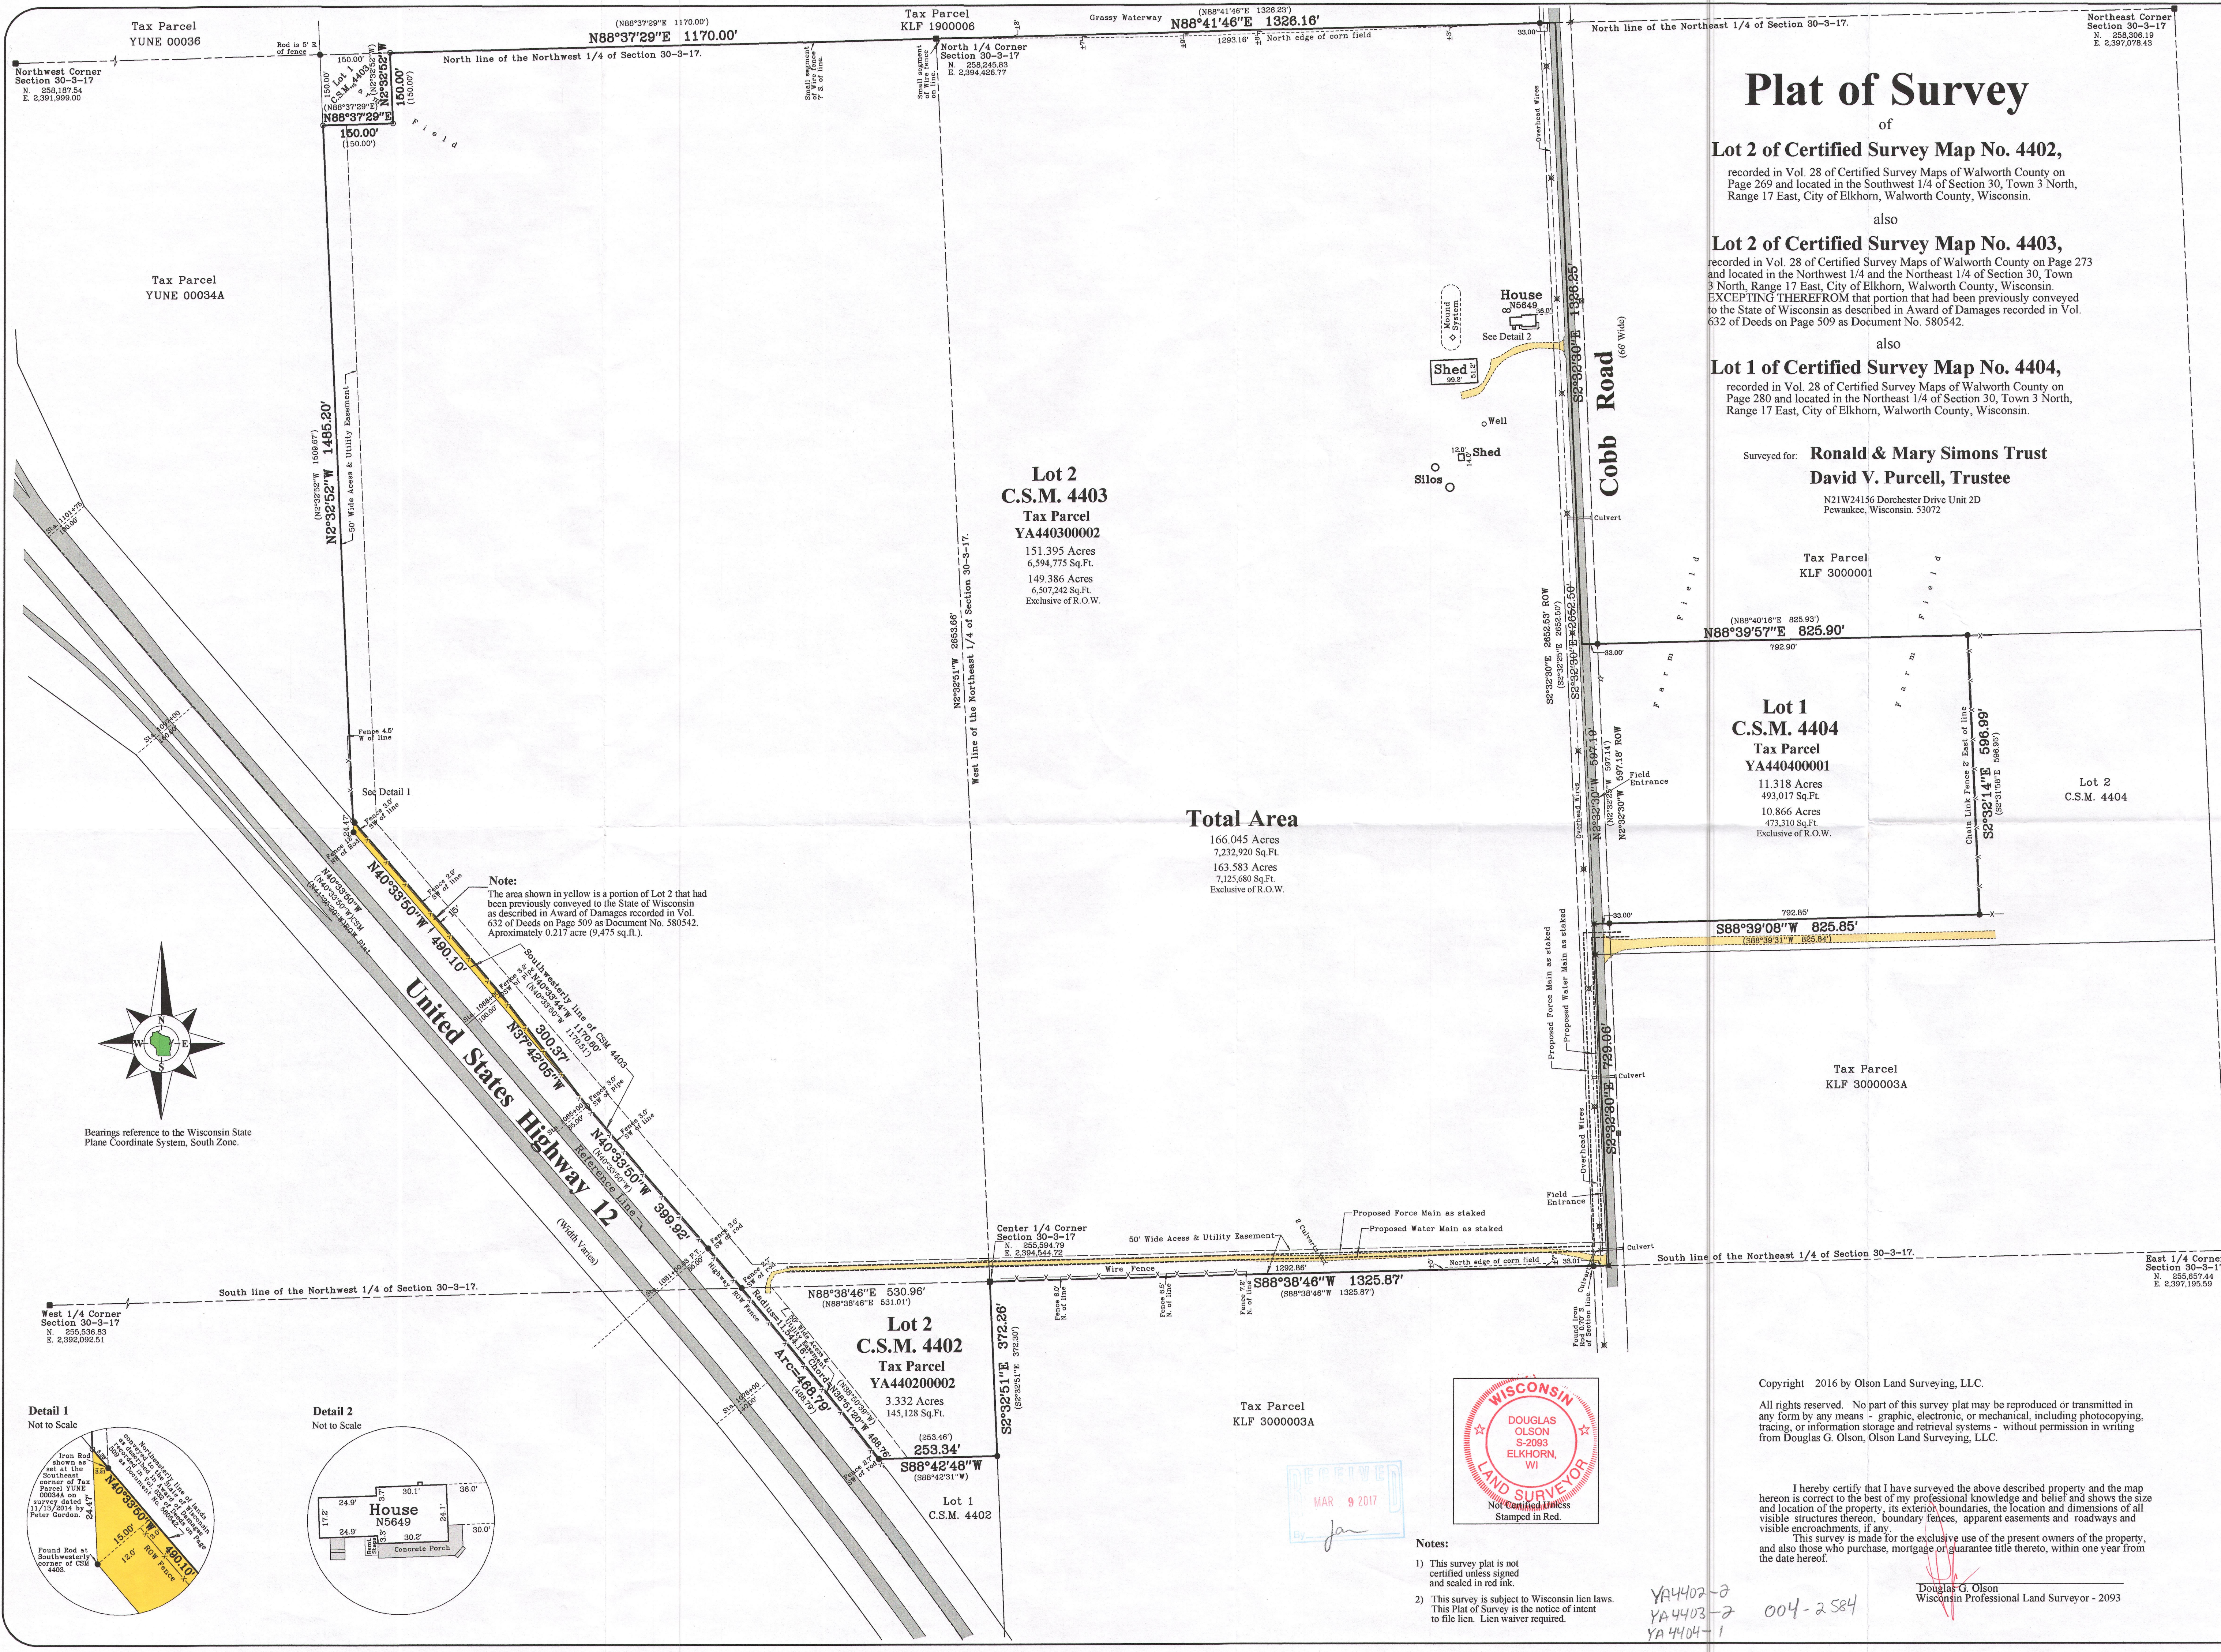

Plat of Survey

of
Lot 2 of Certified Survey Map No. 4402,

recorded in Vol. 28 of Certified Survey Maps of Walworth County on Page 269 and located in the Southwest 1/4 of Section 30, Town 3 North, Range 17 East, City of Elkhorn, Walworth County, Wisconsin.

also
Lot 2 of Certified Survey Map No. 4403,

recorded in Vol. 28 of Certified Survey Maps of Walworth County on Page 273 and located in the Northwest 1/4 and the Northeast 1/4 of Section 30, Town 3 North, Range 17 East, City of Elkhorn, Walworth County, Wisconsin. EXCEPTING THEREFROM that portion that had been previously conveyed to the State of Wisconsin as described in Award of Damages recorded in Vol. 632 of Deeds on Page 509 as Document No. 580542.

also
Lot 1 of Certified Survey Map No. 4404,

recorded in Vol. 28 of Certified Survey Maps of Walworth County on Page 280 and located in the Northeast 1/4 of Section 30, Town 3 North, Range 17 East, City of Elkhorn, Walworth County, Wisconsin.

Surveyed for: **Ronald & Mary Simons Trust**
David V. Purcell, Trustee

N21W24156 Dorchester Drive Unit 2D
Pewaukee, Wisconsin. 53072

Tax Parcel
KLF 3000001

Lot 1
C.S.M. 4404
Tax Parcel
YA440400001

11.318 Acres
493,017 Sq.Ft.
10.866 Acres
473,310 Sq.Ft.
Exclusive of R.O.W.

Lot 2
C.S.M. 4404

Tax Parcel
KLF 3000003A

Total Area

166.045 Acres
7,232,920 Sq.Ft.
163.583 Acres
7,125,680 Sq.Ft.
Exclusive of R.O.W.

Note:
The area shown in yellow is a portion of Lot 2 that had been previously conveyed to the State of Wisconsin as described in Award of Damages recorded in Vol. 632 of Deeds on Page 509 as Document No. 580542. Approximately 0.217 acre (9,475 sq.ft.).

United States Highway 12
(Width Varies)



- Notes:**
- This survey plat is not certified unless signed and sealed in red ink.
 - This survey is subject to Wisconsin lien laws. This Plat of Survey is the notice of intent to file lien. Lien waiver required.

Copyright 2016 by Olson Land Surveying, LLC.

All rights reserved. No part of this survey plat may be reproduced or transmitted in any form by any means - graphic, electronic, or mechanical, including photocopying, tracing, or information storage and retrieval systems - without permission in writing from Douglas G. Olson, Olson Land Surveying, LLC.

I hereby certify that I have surveyed the above described property and the map hereon is correct to the best of my professional knowledge and belief and shows the size and location of the property, its exterior boundaries, the location and dimensions of all visible structures thereon, boundary fences, apparent easements and roadways and visible encroachments, if any.

This survey is made for the exclusive use of the present owners of the property, and also those who purchase, mortgage or guarantee title thereto, within one year from the date hereof.

Douglas G. Olson
Wisconsin Professional Land Surveyor - 2093

Survey date: July 8, 2016.
Revisions:



Olson Land Surveying, LLC

45 South Wisconsin Street * P.O. Box 322 * Elkhorn, Wisconsin. 53121
Telephone: (262) 723-3434 * Facsimile: (262) 723-8044
Email: doug@olsonsurveying.com

Legend

Found County Section Corner
Found Iron Rod
Found Iron Nail
Found Metal
Recorded Information
Utility Pole
Concrete Cover
Concrete Cover
Concrete Surface
Gravel Surface

Sheet 1 of 1 Sheets
Drawing Name:

Job Reference Number
2016.054

2016.054