

FILE NAME: 2017-051 BIELINSKI HOMES HARVEST PT SOUTH LOT 62.DGN



PATRICIA ST.



66' PUBLIC RIGHT OF WAY

C/L
C/L
C/L



7/2


C/L

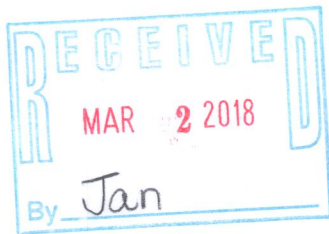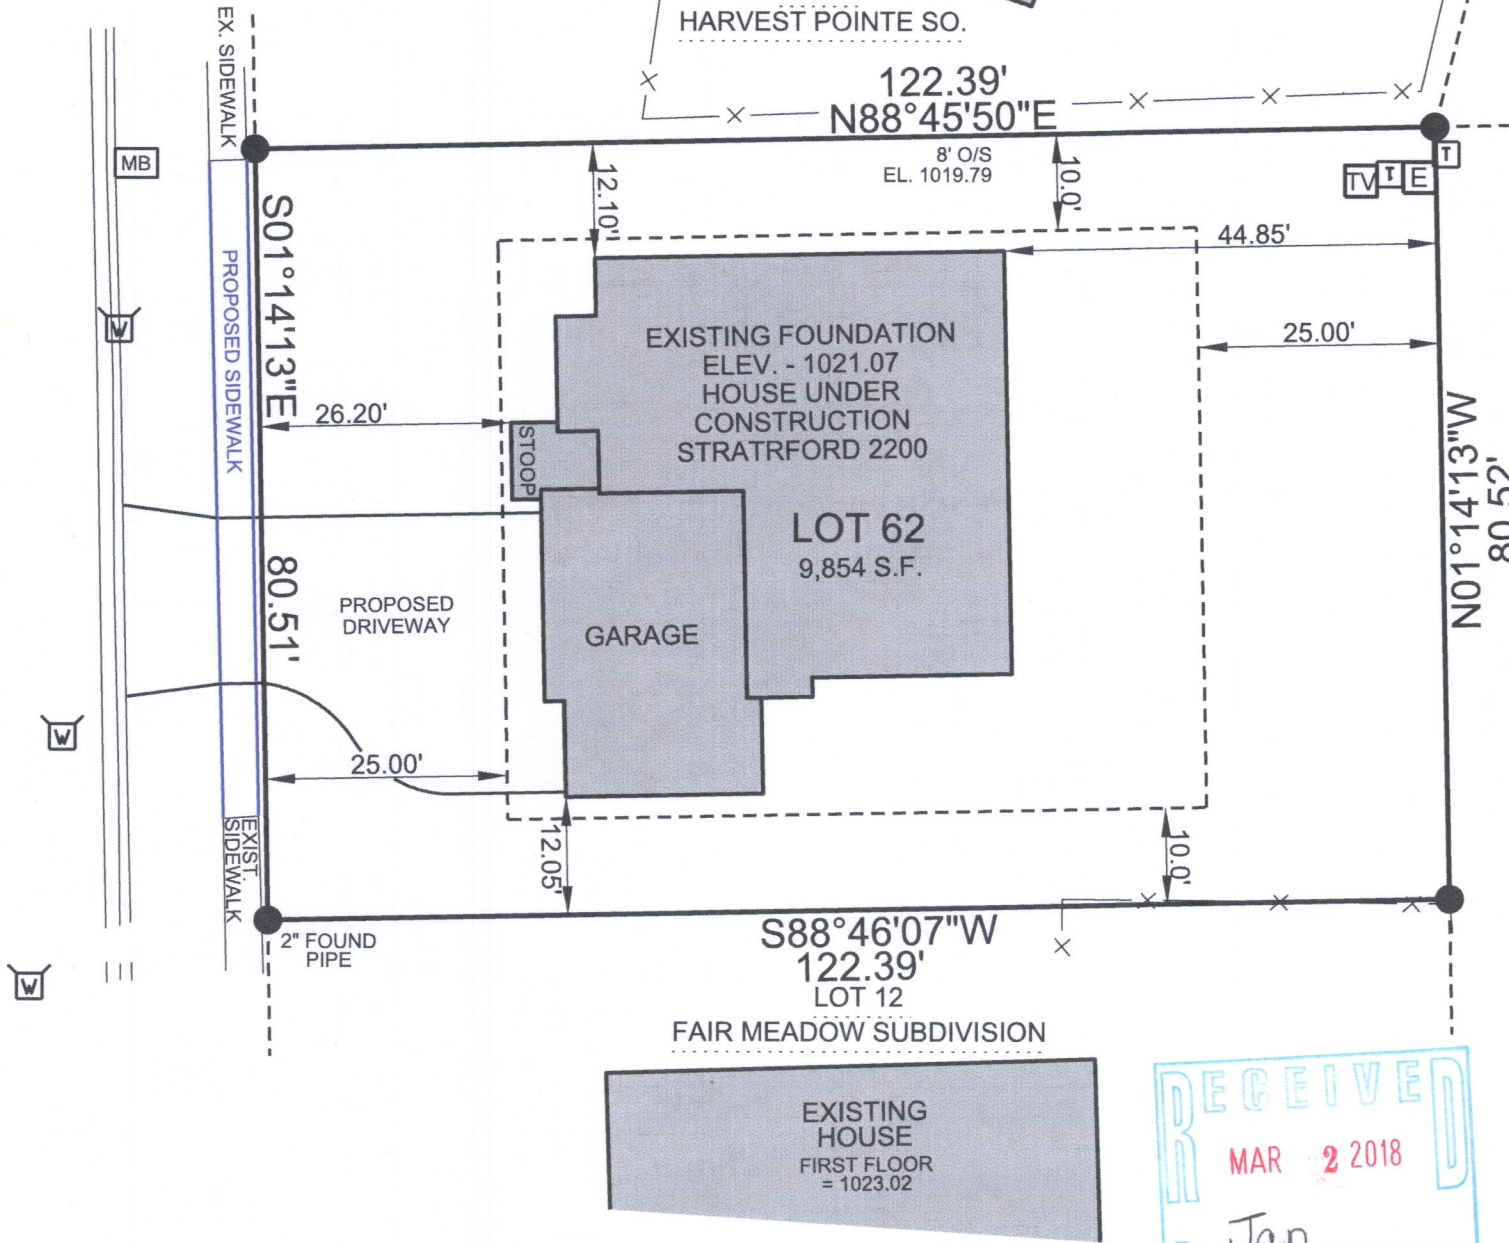

PLAT OF SURVEY

FOUNDATION AS-BUILT

BEING ALL OF LOT 62 OF HARVEST POINTE SOUTH SUBDIVISION, LOCATED IN THE
SOUTHWEST ¼ OF THE SOUTHWEST ¼ OF SECTION 30, TOWNSHIP 3 NORTH,
RANGE 17 EAST, CITY OF ELKHORN, WALWORTH COUNTY, WISCONSIN.

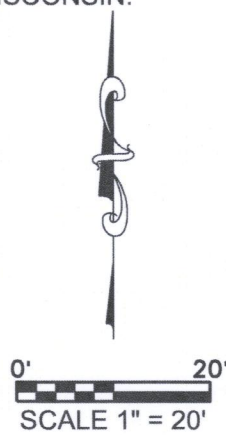

LEGEND:

●	1" FOUND IRON PIPE, UNLESS NOTED	T	TELEPHONE PEDESTAL
▬	STORM INLET	TV	TV PEDESTAL
⊙	STORM MANHOLE	⊕	ELECTRIC PEDESTAL
⊙	SANITARY MANHOLE	E	ELECTRIC TRANSFORMER
⊕	WATER BOX	MB	MAIL BOX
●	EXISTING SPOT ELEVATION	⊕	FIRE HYDRANT
X (1018.00)	PROPOSED SPOT ELEVATION	- 1017 -	EXISTING CONTOUR
⊕	EXISTING TREE	- 1018 -	PROPOSED CONTOUR
		→	DRAINAGE ARROW
		⊕	EXISTING TREE STUMP



THIS SURVEY IS MADE FOR THE USE OF THE PRESENT OWNERS
OF THE PROPERTY, AND ALSO THOSE WHO PURCHASE, MORTGAGE
OR GUARANTEE TITLE TO WITHIN ONE (1) YEAR FROM DATE HERETO.

I, MICHAEL A. GREESON R.L.S. X2770, HEREBY CERTIFY THAT THIS
SURVEY WAS MADE IN ACCORDANCE WITH THE MINIMUM STANDARDS
FOR PROPERTY SURVEYS (CHAPTER A-E 7) FOR THE STATE OF WISCONSIN
AND HAS BEEN PREPARED UNDER MY DIRECTION AND CONTROL AND IS
CORRECT TO THE BEST OF MY KNOWLEDGE AND BELIEF.

DATE	ITEM
04/21/2017	ORIGINAL SURVEY
05/01/2017	REV. GRADES
05/03/2017	STAKED HOUSE
09/12/2017	ASBUILT SURVEY

SURVEY FOR:
BIELINSKI HOMES, INC.
1830 MEADOW LANE
PEWAUKEE, WI 53072

V²G
SURVEYING, LLC

123 WOLF RUN - SUITE 4
MUKWONAGO, WI 53149
(262) 378-5097