


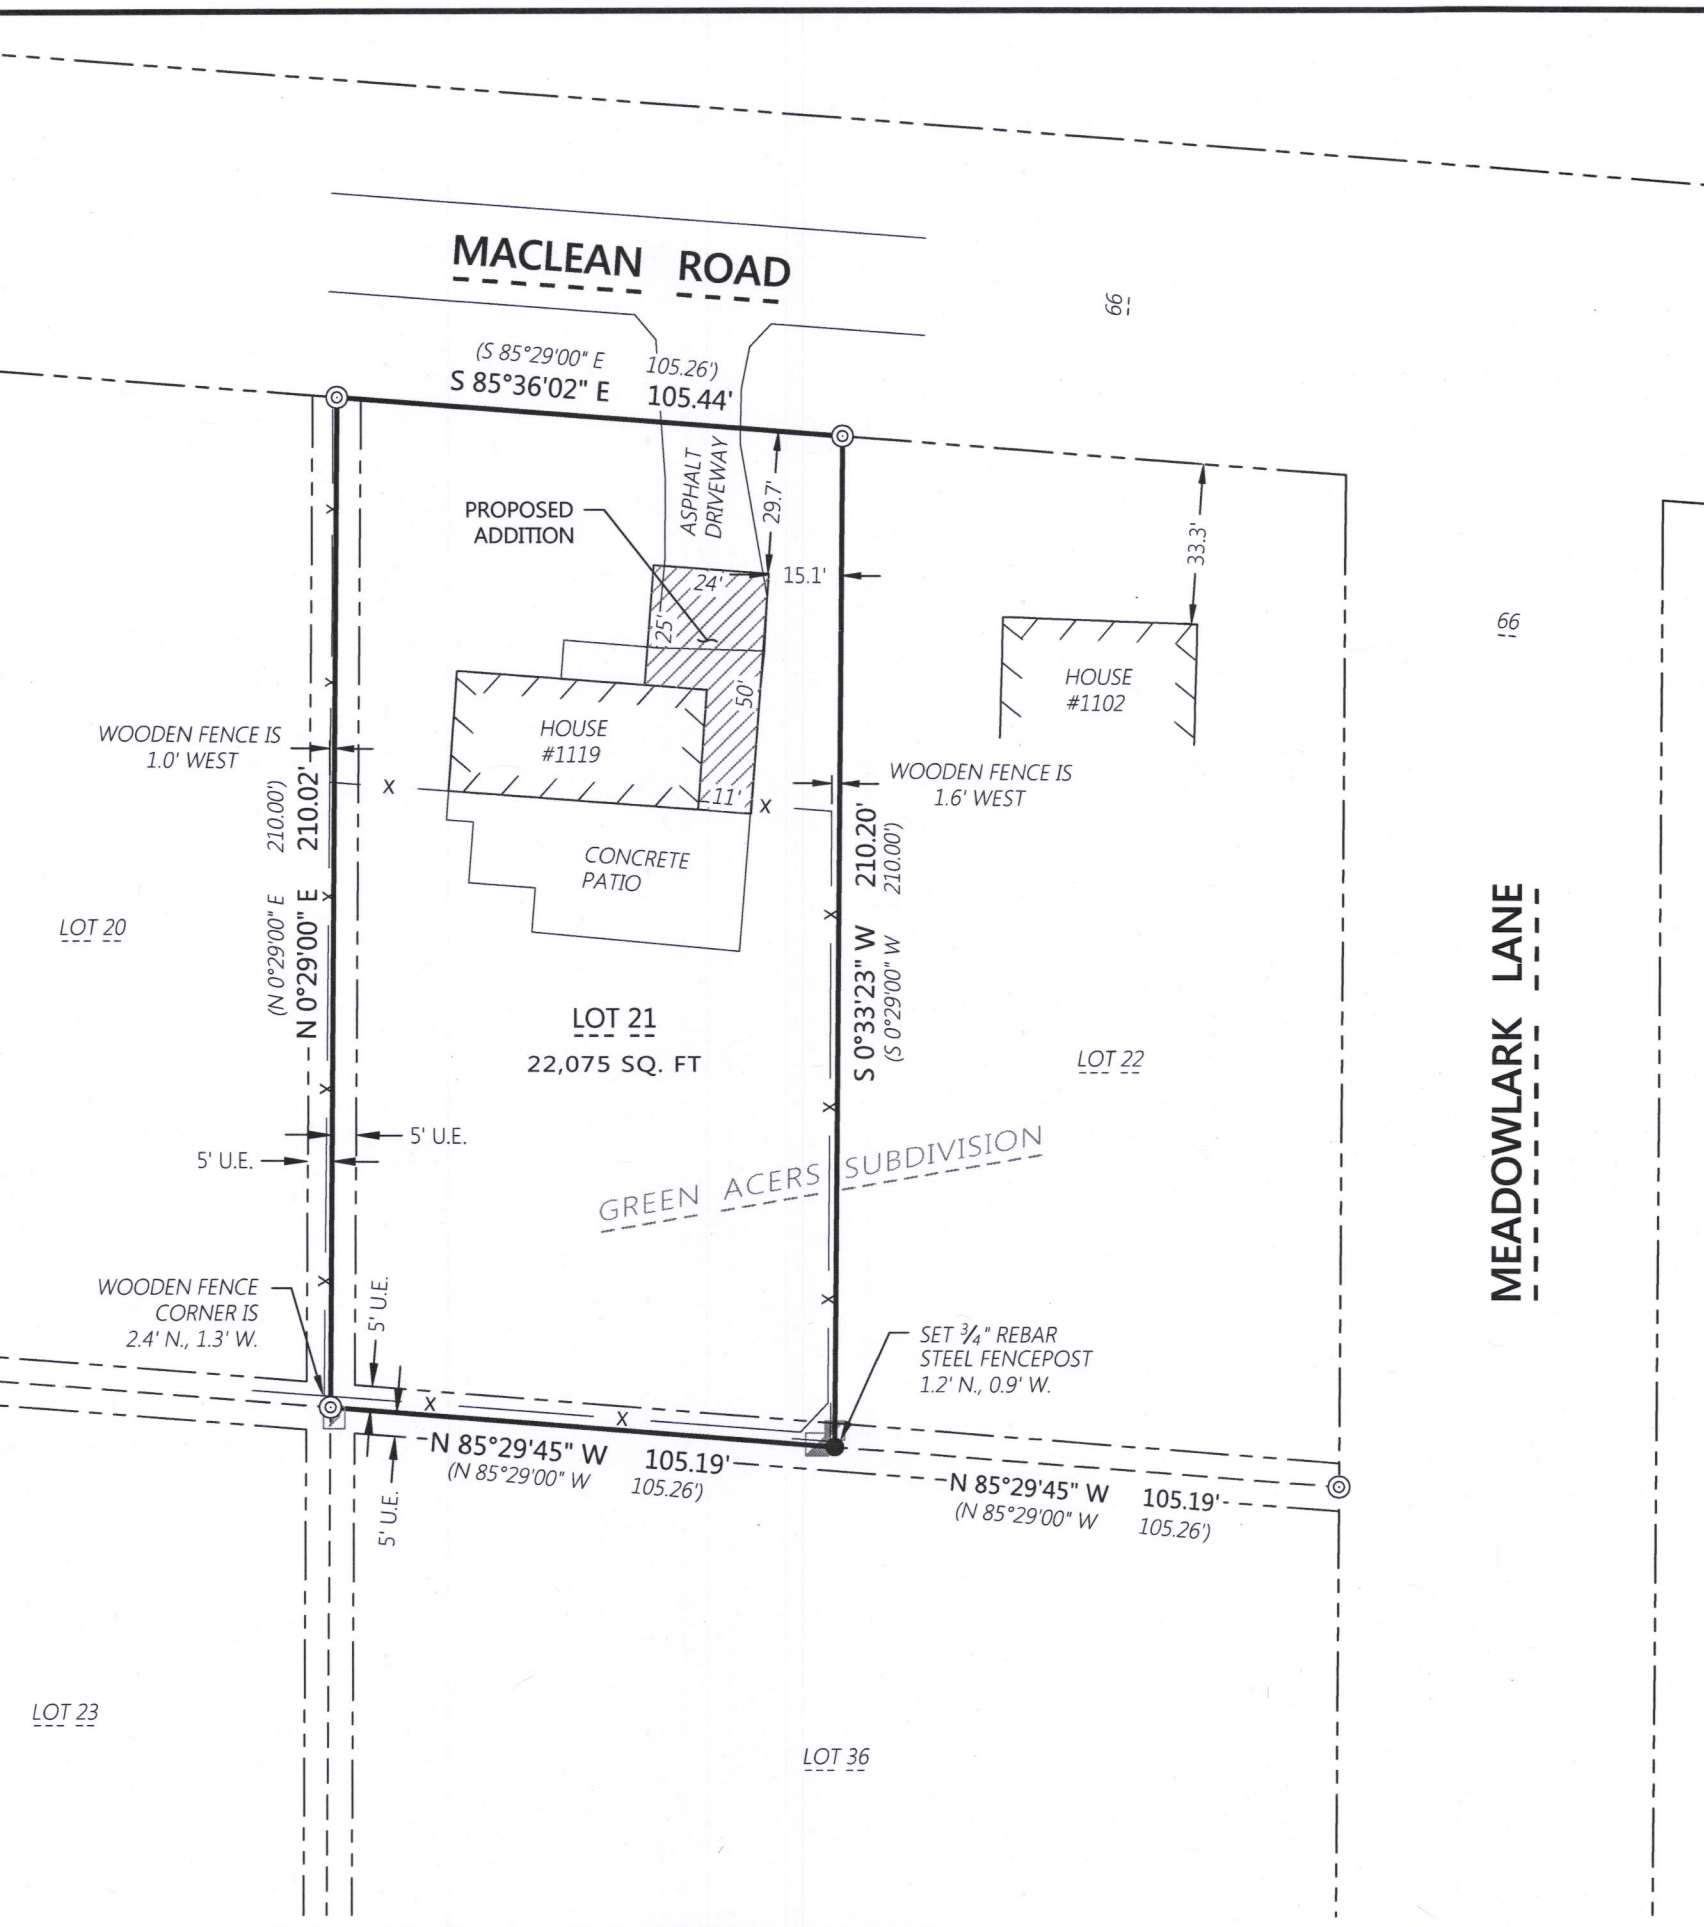



PLAT OF SURVEY
OF LOT 21, GREEN ACERS SUBDIVISION, BEING PART OF THE
NW 1/4 OF THE NW 1/4 OF SECTION 8, T. 2 N., R. 17 E., OF THE
4TH P.M., CITY OF ELKHORN, WALWORTH COUNTY, WISCONSIN.

MONUMENT KEY

- Iron Rebar Set
3/4" x 24" (1.5 Lbs./Ft.)
- ⊙ 1" Iron Pipe Found

LEGEND

- Existing Telephone Pedestal
- ▣ Existing Electric Box
- ▣ Existing Electric Pedestal
- - - Existing Right-of-Way
- Existing Boundary Line
- - - Existing Adjacent Property
- - - Existing Easement Line
- x Existing Fence
- (XXX.XX) Record Information
- U.E. Utility Easement

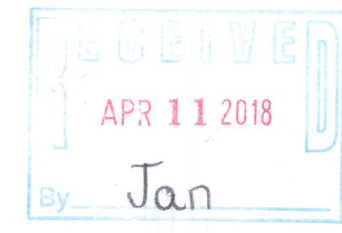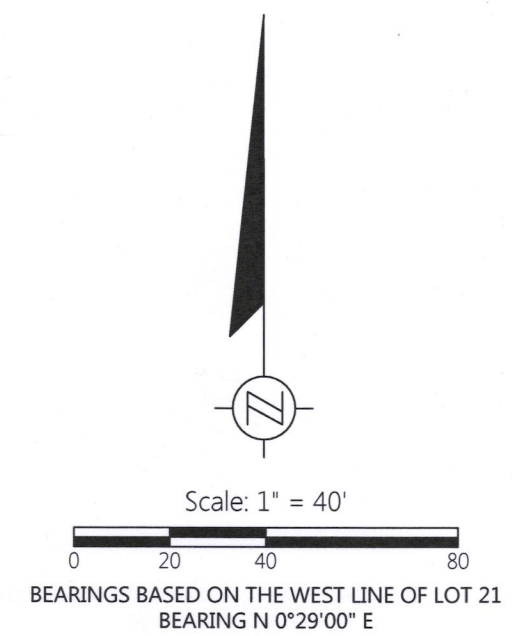

Kristin Belongia

Kristin J. Belongia, P.L.S.
Wisconsin Professional Land Surveyor S-2943

State of Wisconsin } ss
County of Rock

If the surveyor's signature is not red in color,
the plan is a copy that should be assumed to
contain unauthorized alterations.
The certification contained on this document
shall not apply to any copies.

I hereby certify that I have supervised the survey of the property described above and to the best
my knowledge and belief, the plat drawn hereon correctly represents said survey and its location.
Given under my hand and seal this 24th day of February, 2018 at Beloit, Wisconsin.
Last day of field work February 22, 2018

Batterman
engineers surveyors planners
2857 Bartells Drive
Beloit, Wisconsin 53511
608.365.4464
www.batterman.com

PLAT OF SURVEY

FOR THE EXCLUSIVE USE OF:
Charlie Getka
1119 Maclean Road
Elkhorn, WI 53121

ORDER NO: 32922
BOOK: 576 PG 8
FIELD CREW: DGM
DRAWN BY: DGM
DATE: February 26, 2018

File Name: H:\32922\32922A\32922 - Charlie Getka\SUBMITTER DRAWING.DWG

YGR-21 004-2650