

# FARRIS, HANSEN & COOPER, INC.

ENGINEERING, SURVEYING AND LAND PLANNING

715 W. WALWORTH ST. - P.O. BOX 487 - ELKHORN, WI 53121

OFFICE: 414/723-2098

**WARREN E. HANSEN**  
PROFESSIONAL ENGINEER

ENGINEERING  
MUNICIPAL - STRUCTURAL  
HIGHWAYS - PUBLIC WORKS


**DANIEL D. COOPER**  
**ROBERT A. FARRIS**  
LAND SURVEYOR

SURVEYING & PLANNING  
SUBDIVISIONS - LOT SURVEYS  
CONSTRUCTION STAKING - MAPPING

## MORTGAGE INSPECTION SURVEY

GENEVA STREET

Note: This is not a "Property Survey" as defined in Chapter A-E 5.01 of the Wisconsin Administrative Code.

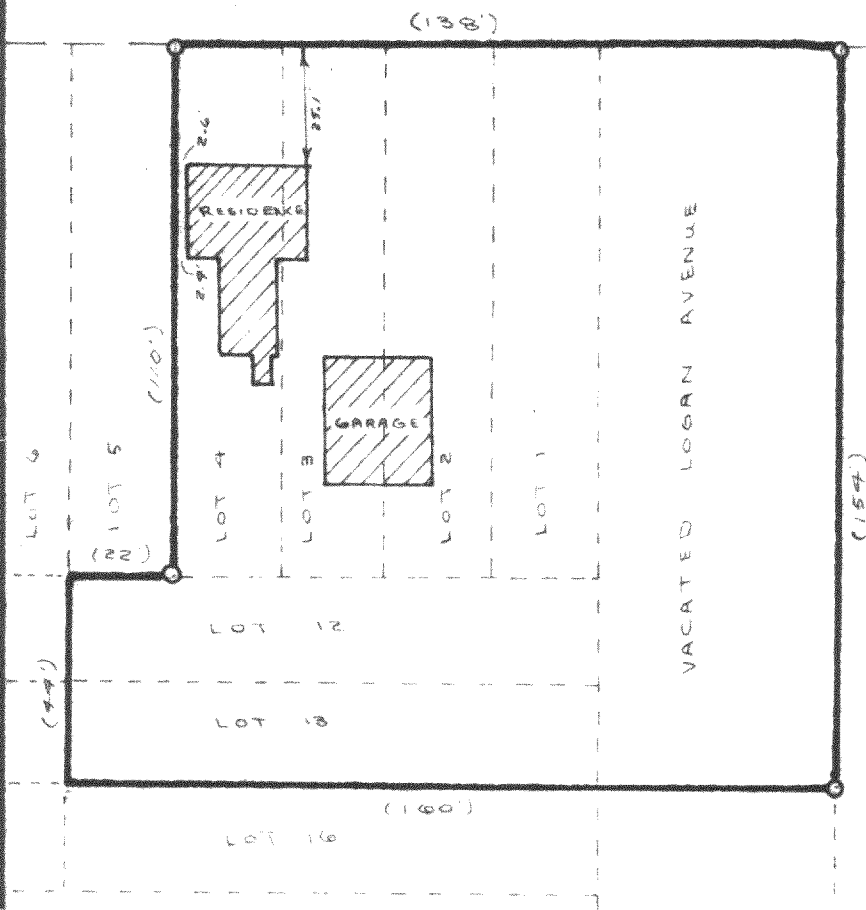

o - indicates iron pipe found  
(xxx) - recorded dist.

SCALE 1" = 40'

I hereby certify that this map is a true and accurate representation of the lot lines and the buildings located thereon to the best of my knowledge and belief.


*Robert A. Farris*  
Robert A. Farris  
Surveyor No. S- 1293

Dated this 30th day of June, 1978.

Lots 1, 2, 3, 4, 12, and 13, also the vacated 50 feet of Logan Avenue adjacent to lots 1, 12, and 13, all in Block 2, Elkhorn Garden Subdivision, City of Elkhorn, Walworth County, Wisconsin.

Buyers: Milan B. & Darlene A. Krempel  
Sellers: Steven E. & Donna J. Fortney  
Property: 415 West Geneva Street  
Elkhorn, Wisconsin 53121

Work Ordered By: Sandra J. Butler  
for Waukesha Savings  
& Loan.

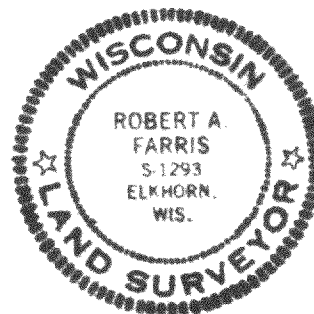

Drawing No. 1359

FN-5 and FN-10

4-265F