

FARRIS, HANSEN & COOPER, INC.

ENGINEERING, SURVEYING AND LAND PLANNING

715 W. WALWORTH ST. - P.O. BOX 487 - ELKHORN, WI 53121

OFFICE: 414/723-2098

DANIEL D. COOPER

ROBERT A. FARRIS

LAND SURVEYOR

WARREN E. HANSEN

PROFESSIONAL ENGINEER

ENGINEERING

MUNICIPAL - STRUCTURAL

HIGHWAYS - PUBLIC WORKS


SURVEYING & PLANNING

SUBDIVISIONS - LOT SURVEYS

CONSTRUCTION STAKING - MAPPING

MORTGAGE INSPECTION SURVEY

LOT 3 OF LANDMARK SUBDIVISION, CITY OF ELKHORN, WALWORTH CO. WIS.

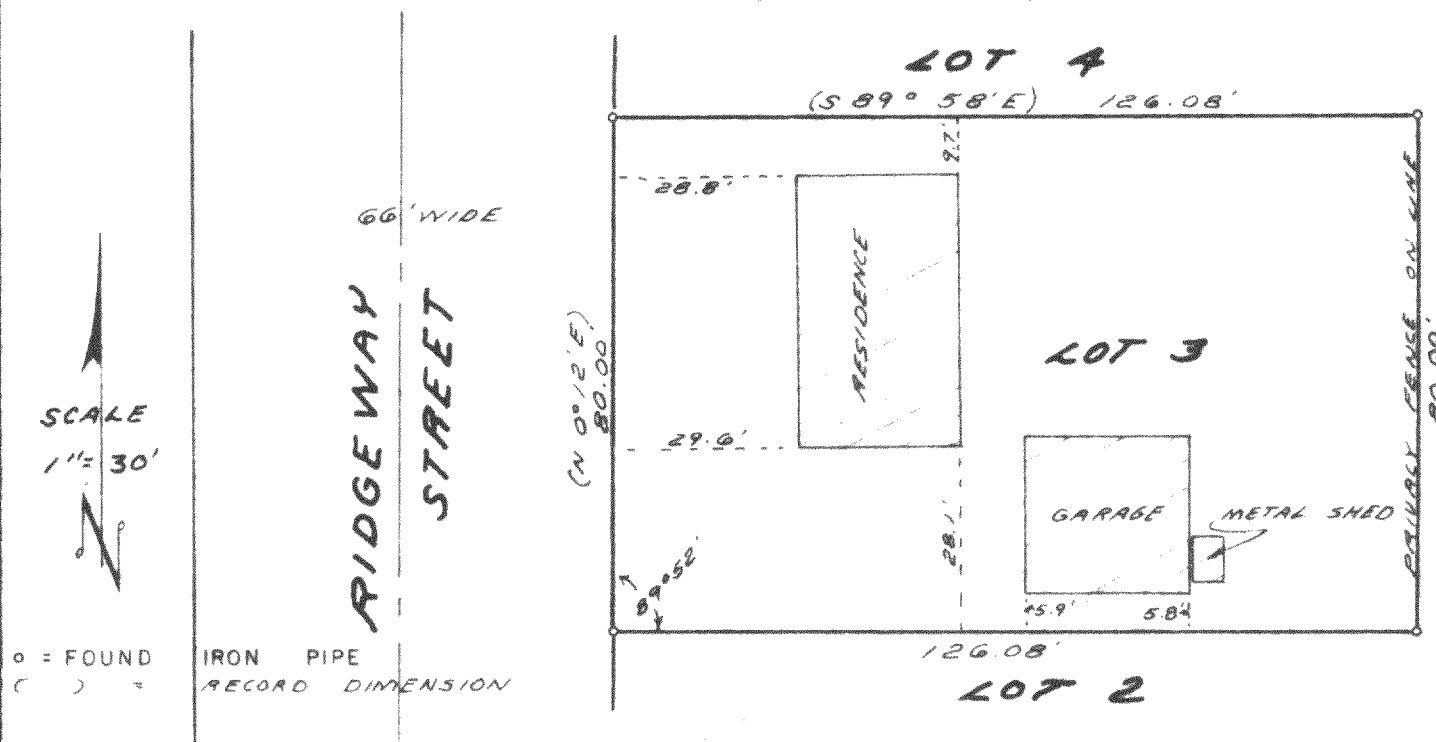

NOTE: THIS IS NOT A "PROPERTY SURVEY" AS DEFINED IN SEC. AE-5.01 OF THE WISCONSIN ADMINISTRATIVE CODE.

Buyers: William J. & Jennifer P. Neis

Sellers: Michael C. & Susan A. Klett

Address: 11 Ridgeway Street

Elkhorn, WI 53121

Work Ordered: Sandra J. Butler for

Waukesha Savings & Loan

Association - East Troy

I HEREBY CERTIFY: that this map is a true representation of the lot lines and buildings located thereon to the best of my knowledge & belief.

Dated This 8th Day of August 1978.

Robert A. Farris
Robert A. Farris, RLS

