


Plat of Survey

of

Lot 4 and the North 30' of Lot 3 of Bartelson Subdivision,

located in the Northeast 1/4 of the Southwest 1/4 of Section 36, Town 3
North, Range 16 East, City of Elkhorn, Walworth County, Wisconsin.

Surveyed for: **John & Linda Chase**
113 Pleasant Street
Elkhorn, Wisconsin. 53121

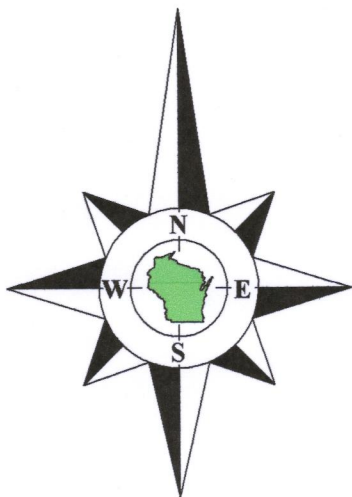

Bearings referenced to the West line of Pleasant Street,
recorded as N0°26'W on the plat of Bartelson Subdivision.



Notes:

- 1) This Plat of Survey is not certified unless signed and sealed in red ink.
- 2) This survey is subject to Wisconsin lien laws. This Plat of Survey is the notice of intent to file lien. Lien waiver required.
- 3) The Survey Date shown on this Plat of Survey is the completion date of the field work.

Copyright ©2018 by Olson Land Surveying, LLC.

All rights reserved. No part of this survey plat may be reproduced or transmitted in any form by any means - graphic, electronic, or mechanical, including photocopying, tracing, or information storage and retrieval systems - without permission in writing from Douglas G. Olson, Olson Land Surveying, LLC.

I hereby certify that I have surveyed the above described property in compliance with Chapter A-E 7 of the Wisconsin Administrative Code and that the map hereon is correct to the best of my professional knowledge and belief and shows the size and location of the property, its exterior boundaries, the location and dimensions of all visible structures thereon, boundary fences, apparent easements and roadways and visible encroachments, if any.

This survey is made for the exclusive use of the present owners of the property, and also those who purchase, mortgage or guarantee title thereto, within one year from the date hereof.

Douglas G. Olson
Wisconsin Professional Land Surveyor - 2093

YB-3

004-2672


Survey Date: July 11, 2018.

Revisions:

Scale in Feet
1" = 20'



45 South Wisconsin Street | P.O. Box 322
Elkhorn, Wisconsin. 53121
Telephone: (262) 723-3434
Facsimile: (262) 723-8044
Email: doug@olsonsurveying.com
Website: www.olsonsurveying.com

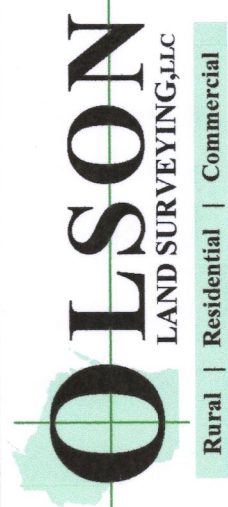

Legend of Symbols & Abbreviations

Found Iron Pipe	Found Iron Rod
Set Iron Pipe, 1" dia.	Recorded Information
Utility Pedestal	Water Valve
Catch Basin	Manhole
Asphalt Surface	Brick Pavers
Concrete Surface	

Sheet 1 of 1 Sheets

Drawing Name:

Job Reference Number

2018.091

2018.091