


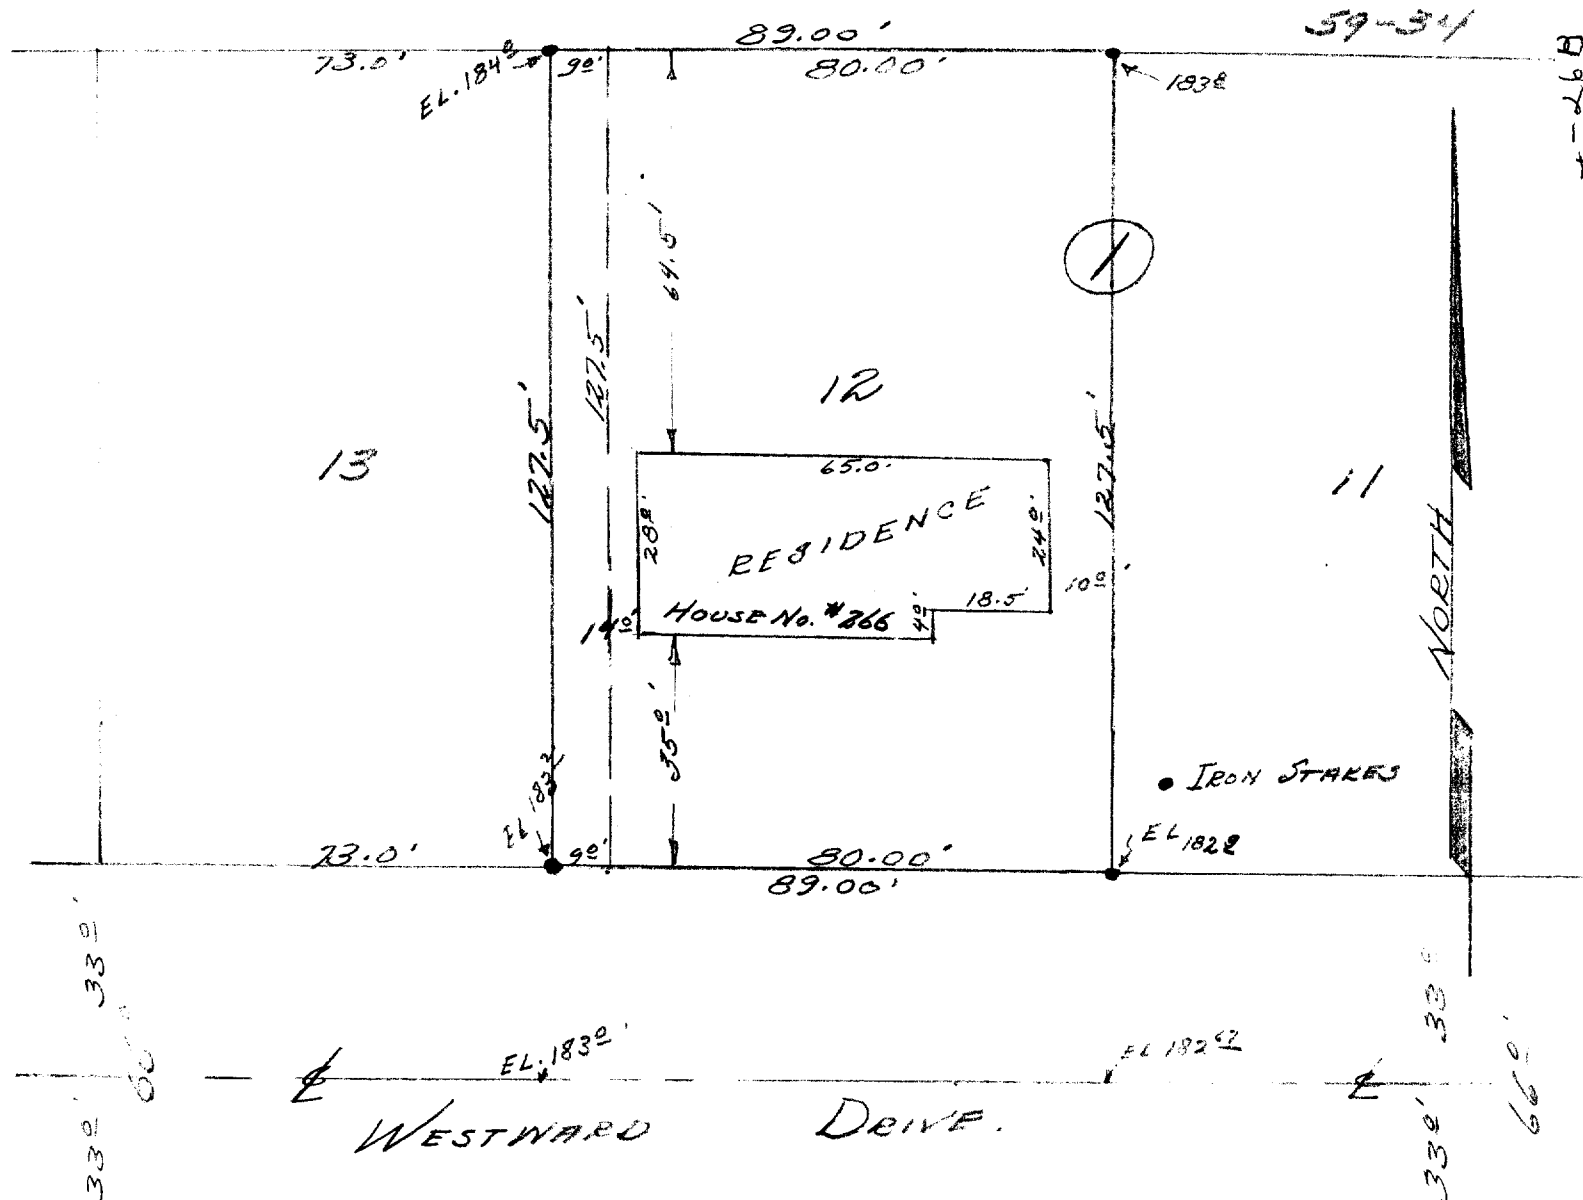

DESCRIPTION:


Lot 12 and the East 9.0 feet of Lot 13, Block 1, of James Jones 2nd Addition of the City of Elkhorn, Walworth County, Wisconsin.

CERTIFICATE:

I, James F. Biagi, Registered Surveyor, do hereby certify that I have surveyed and staked the above described property, and that the bearings and measurements of the boundary lines are in accordance with the official records on file in the Office of the Registrar of Deeds in and for Walworth County, Wisconsin; and that no encroachments exist and that as of this day a building is located on the above described property as hereon portrayed.

SIGNED AND SEALED ON THIS THE 24TH DAY OF JULY, 1959.

James F. Biagi, Registered Surveyor
Elkhorn Wisconsin.

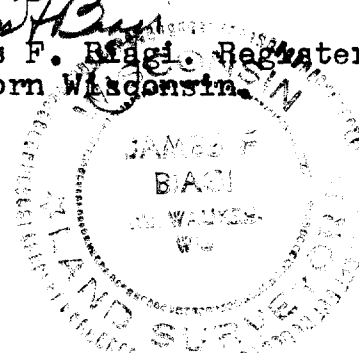

4-570

YJA 2-12

26