


FARRIS, HANSEN & COOPER, INC.

ENGINEERING, SURVEYING AND LAND PLANNING
715 W. WALWORTH ST. - P.O. BOX 487 - ELKHORN, WI 53121
OFFICE: 414/723-2098

MORTGAGE INSPECTION SURVEY

NOTE: THIS IS NOT A "PROPERTY SURVEY" AS DEFINED IN SEC. 5.01 OF THE WIS. ADMIN. CODE.

ORDERED BY: Waukesha Savings & Loan Assn. BUYER: Charles R. SELLER: Phyllis
Attn.: Sandra J. Butler Platts Patek

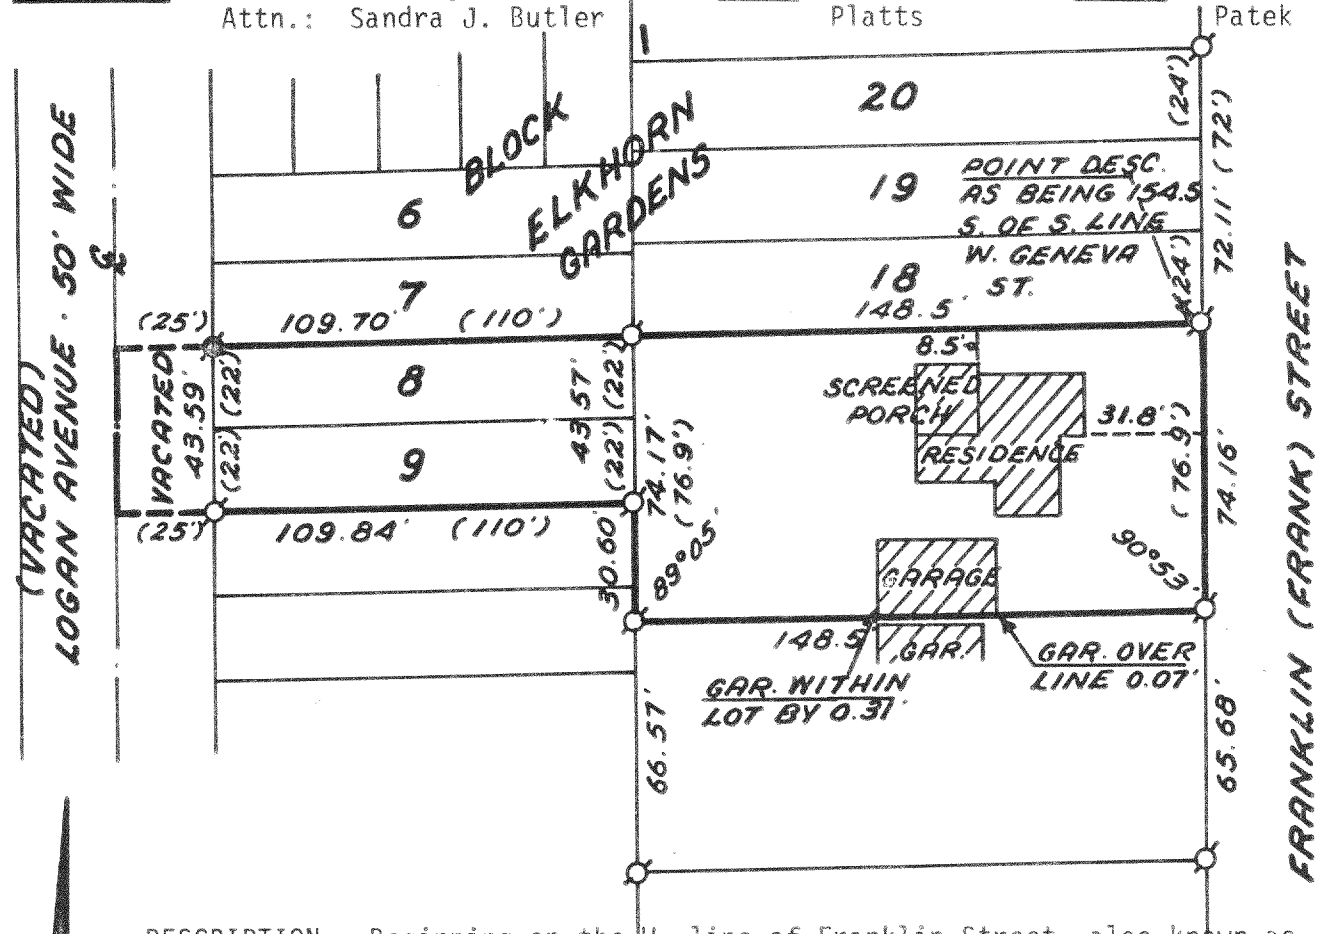

DESCRIPTION: Beginning on the W. line of Franklin Street, also known as Frank Street, in the City of Elkhorn, 154.5 feet S. of the S. line of West Geneva Street; thence S. 76.9 feet; thence W. 148.5 feet; thence N. 76.9 feet; thence E. 148.5 feet to the place of beginning. Also, Lots 8 and 9 in Block 1 of Elkhorn Gardens, a subdivision lying and being in the City of Elkhorn, Walworth County, Wisconsin, according to a plat thereof on record in the office of the Register of Deeds in and for the County of Walworth and State of Wisconsin. Also, the East 25 feet of vacated Logan Avenue adjoining the West lines of said Lots 8 and 9 in Block 1 of Elkhorn Gardens.

SCALE: 1"=30'

LEGEND

- Iron Rod Found
- Iron Pipe Found
- ()—Record Dimension



I hereby certify that this map is a true and accurate representation of the lot lines as found to be monumented and the location of the buildings located thereon to the best of my knowledge and belief.

Daniel D. Cooper
Daniel D. Cooper RLS No. 1464

2 Nov, 1978
Date

DRAWING NUMBER 1429

Lots 8 + 9 Blk 1 + VU-SW-23

4-272^v