


FARRIS, HANSEN & ASSOCIATES, INC.

ENGINEERING - ARCHITECTURE - SURVEYING
7 RIDGWAY COURT - P.O. BOX 437 - ELKHORN, WISCONSIN 53121
PHONE: (262) 723-2098 FAX: (262) 723-5886

PLAT OF SURVEY - AS BUILT

LOT 133 OF ELKHORN WEST ADDITION NO. 2
LOCATED IN PART OF THE NE 1/4 OF THE SE 1/4
OF SECTION 35, TOWN 3 NORTH, RANGE 16 EAST,
CITY OF ELKHORN, WALWORTH COUNTY, WISCONSIN

- WORK ORDERED BY -
DAN CARMODY & FRED ARBANELLA
5803 GLEN HAVEN DRIVE
GREENDALE, WI 53129

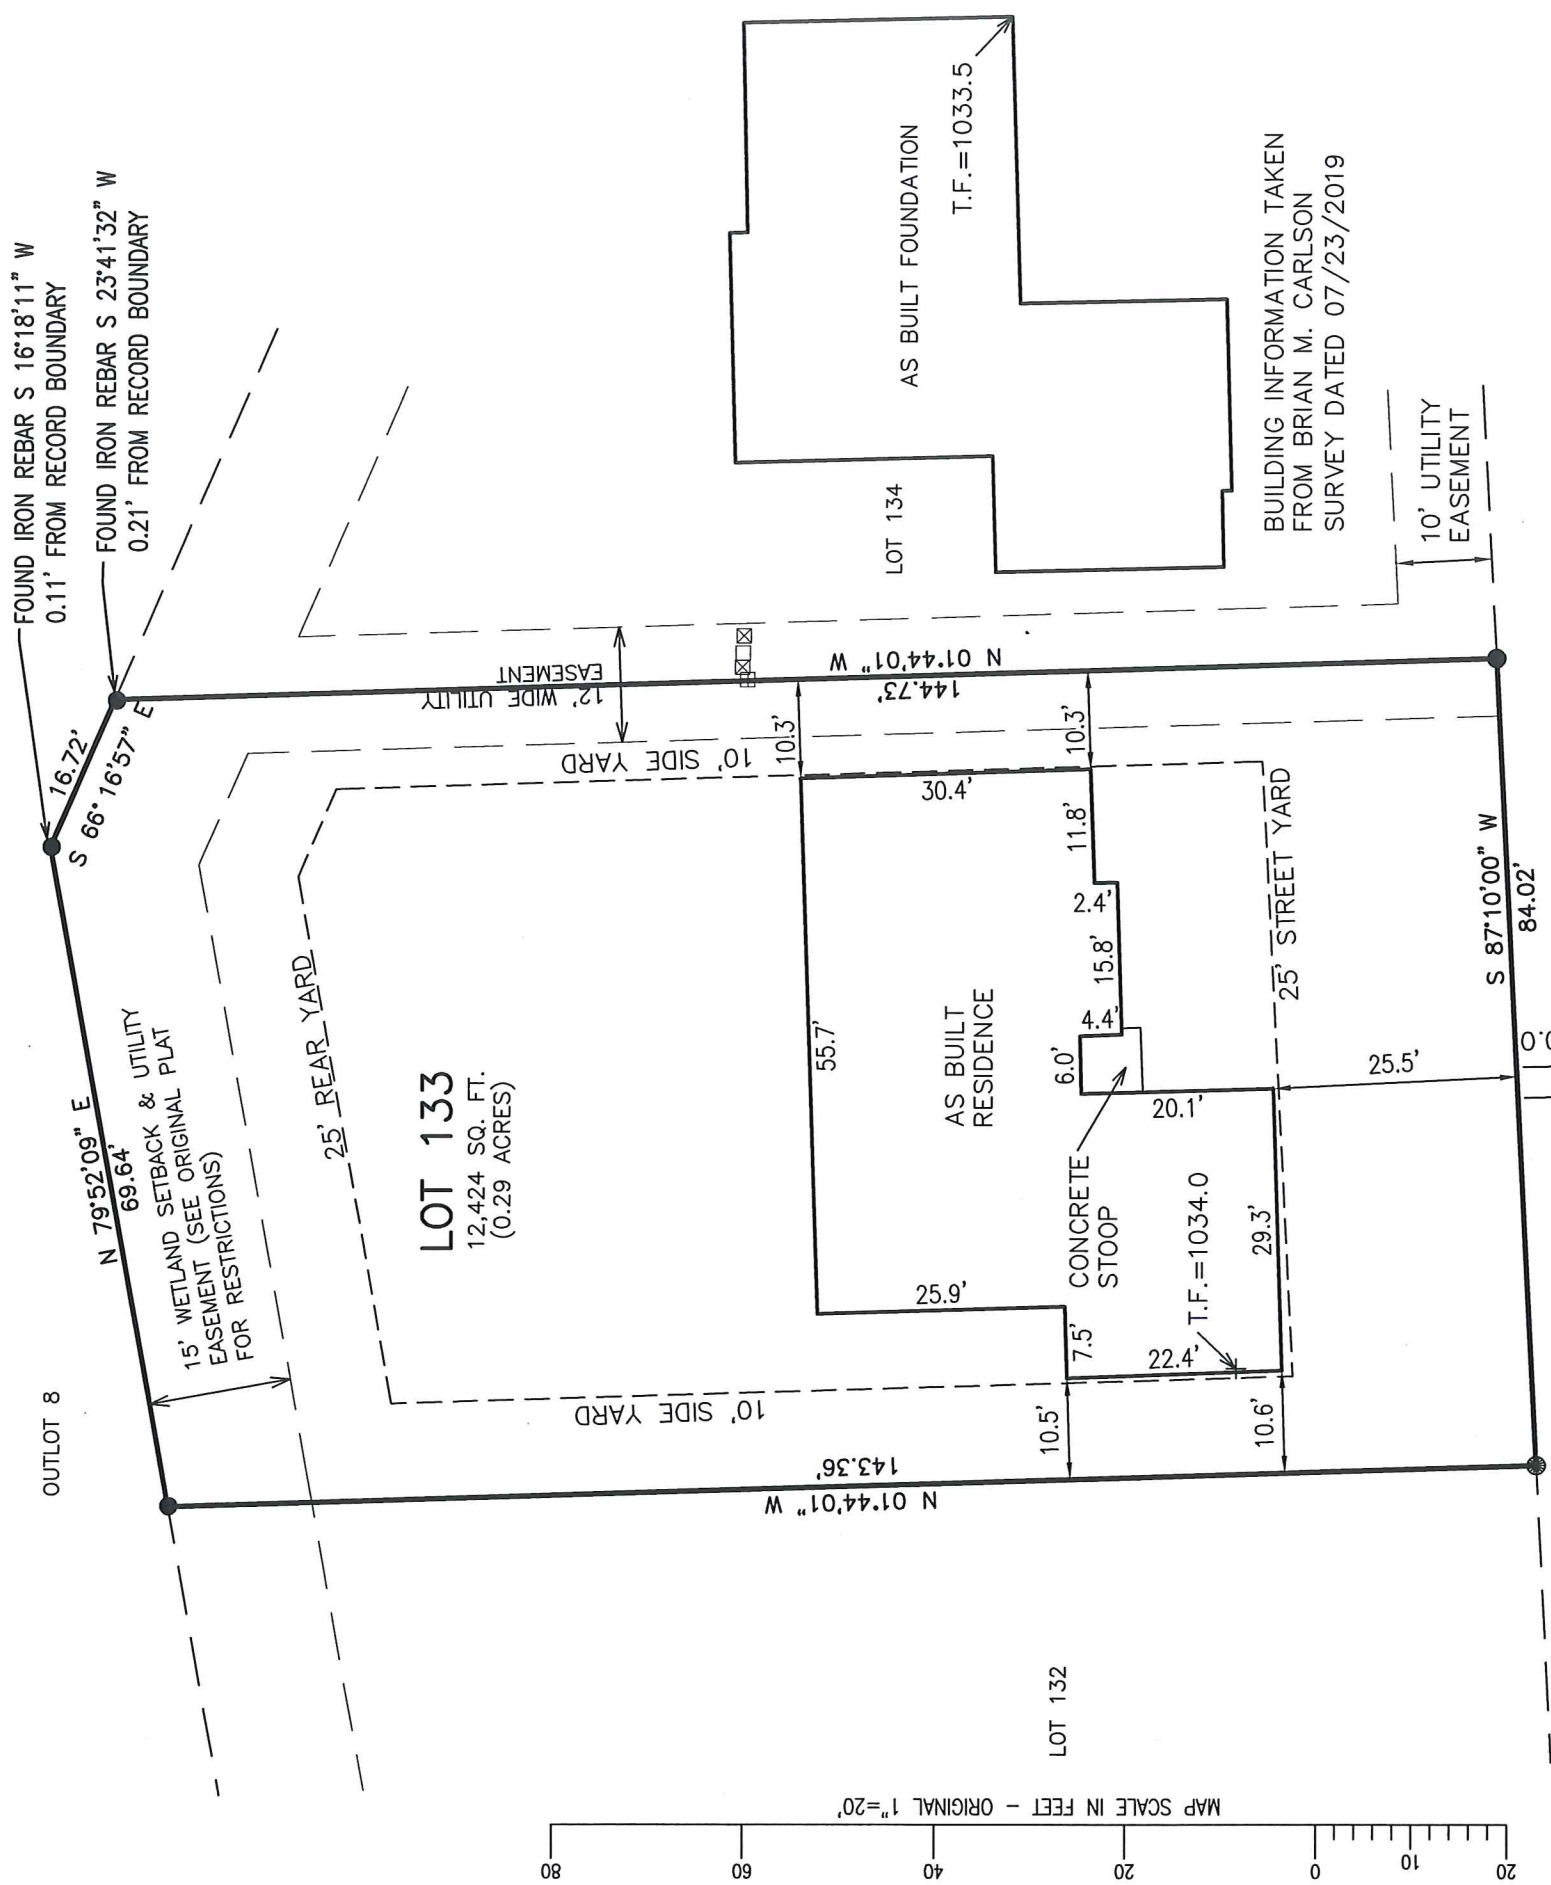

DATED: 03/11/2021

Christopher A. Hodges

CHRISTOPHER A. HODGES P.L.S. 2760



PROJ: 6103.02.133
DATE: 09/13/2005
SHEET 1 OF 1