


FARRIS, HANSEN & COOPER, INC.

ENGINEERING, SURVEYING AND LAND PLANNING
715 W. WALWORTH ST. - P.O. BOX 487 - ELKHORN, WI 53121
OFFICE: 414/723-2098

MORTGAGE INSPECTION SURVEY

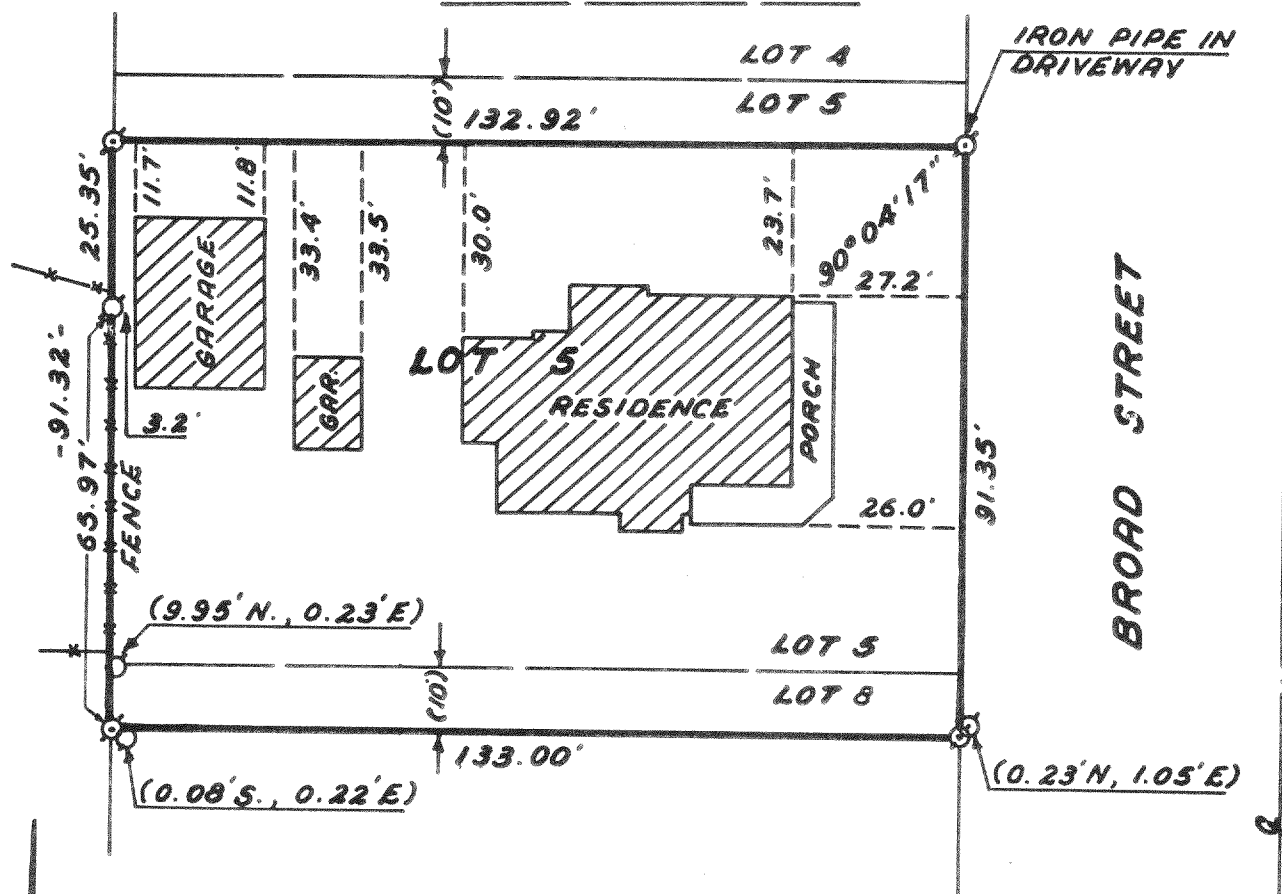

DESCRIPTION: A strip of land 10 feet in width off the entire North side of Lot 8, and all of Lot 5 except a strip 10 feet in width off the entire North side, all in Block 17 in the City of Elkhorn, Walworth County, Wis.

LOCATION: 116 North Broad Street Elkhorn, Wisconsin

SELLER: B.E.S.P. Corporation **BUYER:** S.S. Partnership

ORDERED BY: Waukesha Savings & Loan Assn. Attn.: Sandra J. Butler

NOTE: THIS IS NOT A "PROPERTY SURVEY" AS DEFINED IN SECTION 5.01 OF THE WIS. ADMINIS. CODE.

I hereby certify that this map is a true and accurate representation of the lot lines as found to be monumented and the location of the buildings located thereon to the best of my knowledge and belief.


Daniel D. Cooper
Daniel D. Cooper, RLS No. 1454

7 December 1978
Date

SCALE: 1" = 30'

LEGEND

- Ø—Iron Pipe Found
- ()—Record Dimension

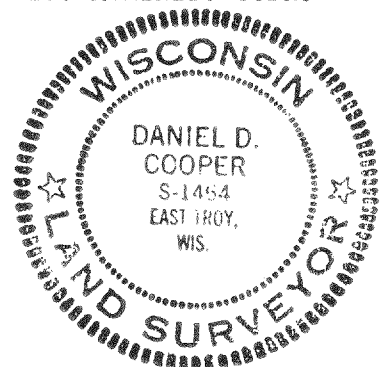

DRAWING NUMBER 1442

4-274