




PLAT OF SURVEY

OF THE NORTH LINE OF LOT 1 OF CERTIFIED SURVEY MAP No. 3696,
RECORDED IN VOLUME 22, PAGES 107 - 109, LOCATED IN THE NORTHWEST 1/4
OF THE NORTHWEST 1/4 OF SECTION 7, TOWNSHIP 2 NORTH, RANGE 17 EAST,
OF THE 4TH P.M., CITY OF ELKHORN, WALWORTH COUNTY, WISCONSIN.

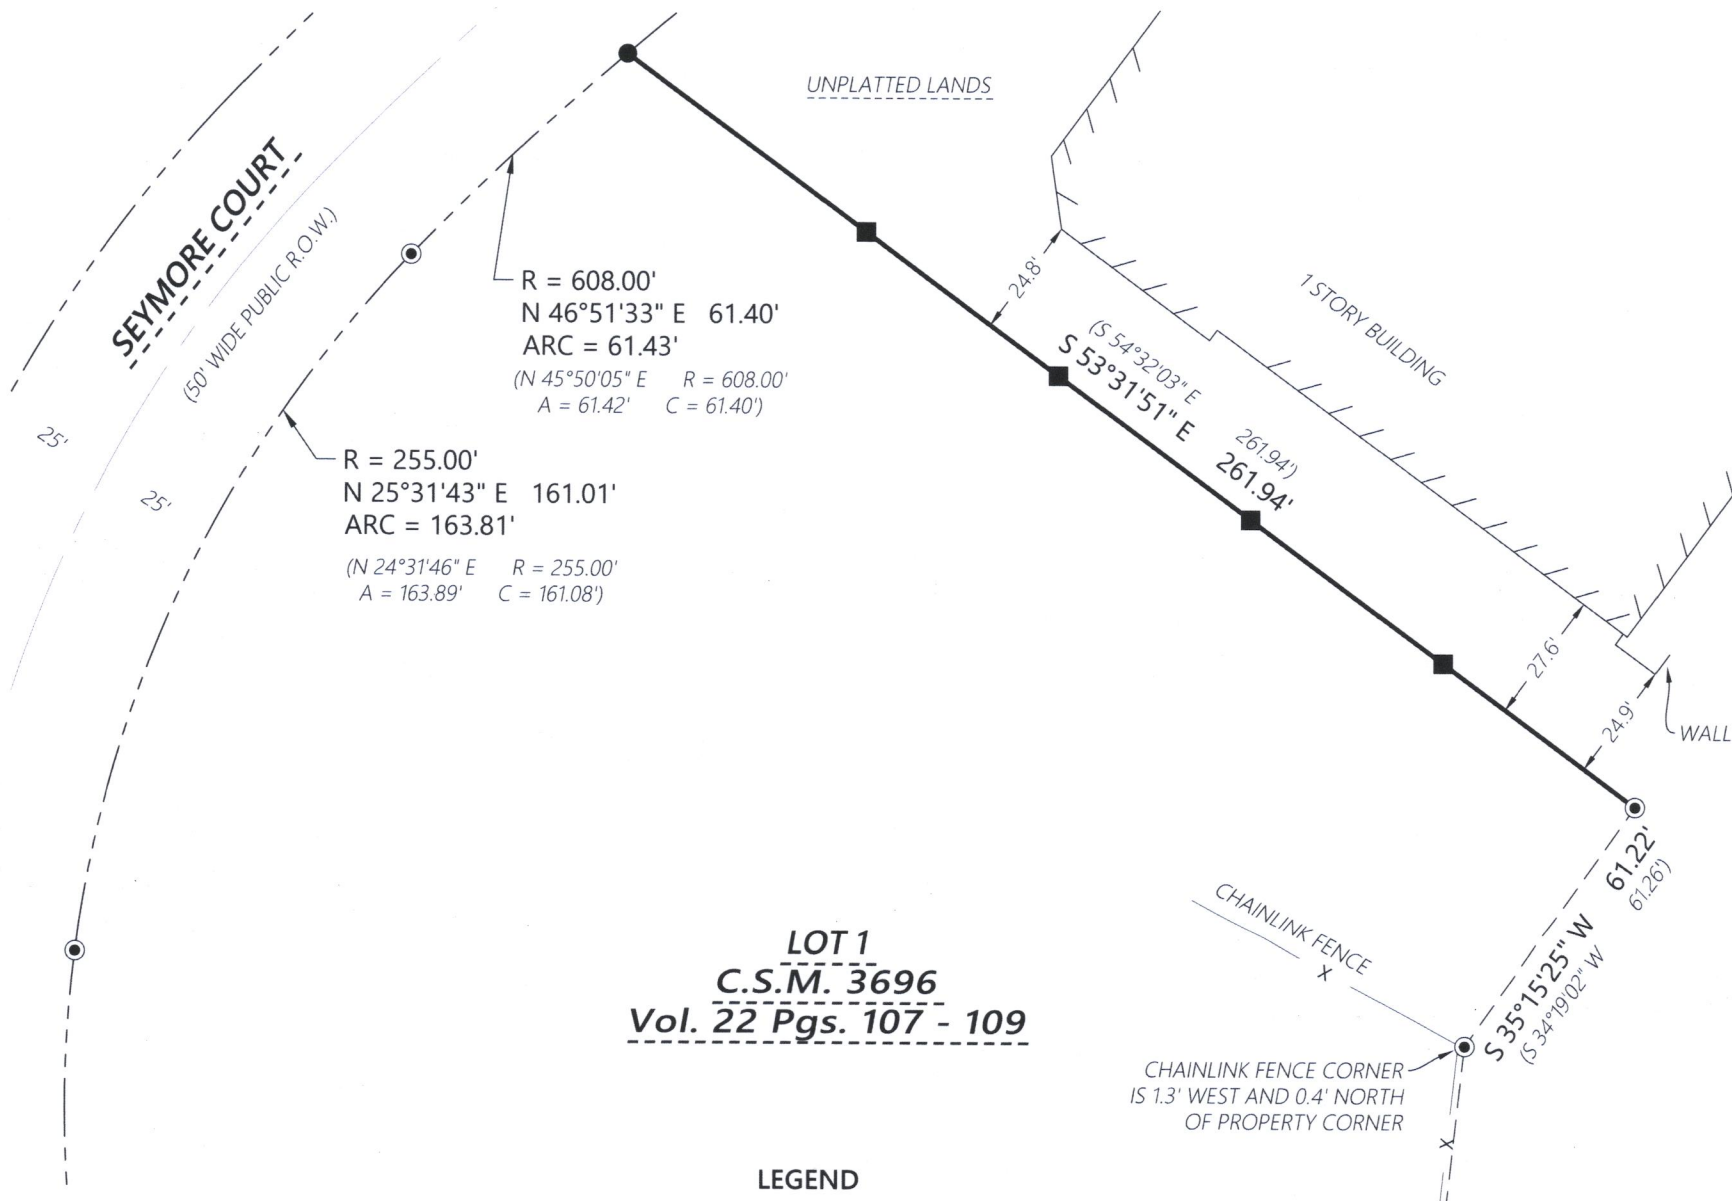

LEGEND

- Iron Rebar Set
3/4" x 24" (1.5 Lbs./Ft.)
- ⊙ 3/4" Iron Rebar Found
- Wooden Lath Set on Line
- Existing Right-of-Way
- Existing Boundary Line
- - - Existing Adjacent Property
- - - Existing Easement Line
- - - Existing Centerline
- X - Existing Fence
- (XXX.XX) Record Information

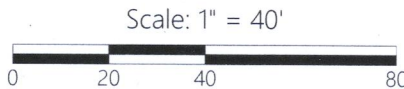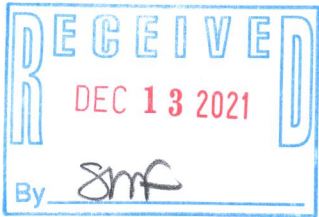

Kristin J. Belongia

Kristin J. Belongia, P.L.S.
Wisconsin Professional Land Surveyor S-2943

State of Wisconsin } ss
County of Rock

If the surveyor's signature is not red in color,
the plan is a copy that should be assumed to
contain unauthorized alterations.
The certification contained on this document
shall not apply to any copies.

I hereby certify that I have supervised the survey of the property described above and to the best
my knowledge and belief, the plat drawn hereon complies with Chapter A-E 7 of the State of
Wisconsin Administrative Code, Minimum Standards for Property Surveys and correctly
represents said survey and its location.

Given under my hand and seal this 9th day of November, 2021 at Beloit, Wisconsin.
Last day of field work November 8th, 2021

DISTANCE UNITS BASED ON THE UNITED STATES SURVEY FOOT

BEARINGS BASED ON THE WISCONSIN COORDINATE REFERENCE
SYSTEM, WALWORTH ZONE. THE NORTH PROPERTY LINE HAVING
A BEARING OF S 53°31'51" E

ORDER NO: 34111

FIELD CREW: BMR
DRAWN BY: BMR

FOR THE EXCLUSIVE USE OF:
Lakelands Little Learners
240 Commerce Court
Elkhorn, WI 53121

PLAT OF SURVEY

Batterman
engineers surveyors planners

2857 Bartells Drive Beloit, Wisconsin 53511
608.365.4464 www.rhbatterman.com

