


Parcel ID's # YA395400001 / YA395400002

Plat of a survey for SHANE AND GWEN GRIFFIN of Lots 1 and 2 of Certified Survey Map No. 3954, recorded in the Office of the Register of Deeds for Walworth County, Wisconsin, on June 19, 2006, in Volume 24, at Page 171, as Document No. 679833, being a redivision of Lot 2 of Certified Survey Map No. 3562, located in part of the Southwest 1/4 of the Northwest 1/4 of Section 36, Town 3 North, Range 16 East. Said land being in the City of Elkhorn, County of Walworth and State of Wisconsin.




Certificate
The above-described property has been surveyed under my direction and the map hereon drawn is a correct representation thereof to the best of my knowledge and belief.

12/06/2021 *Mark R. Nielsen*

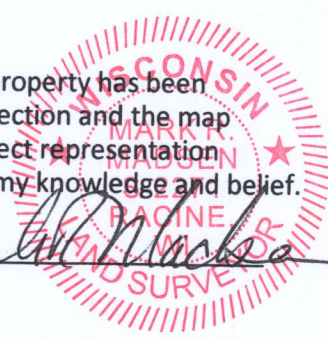

RECEIVED
JAN 24 2022
By *smf*

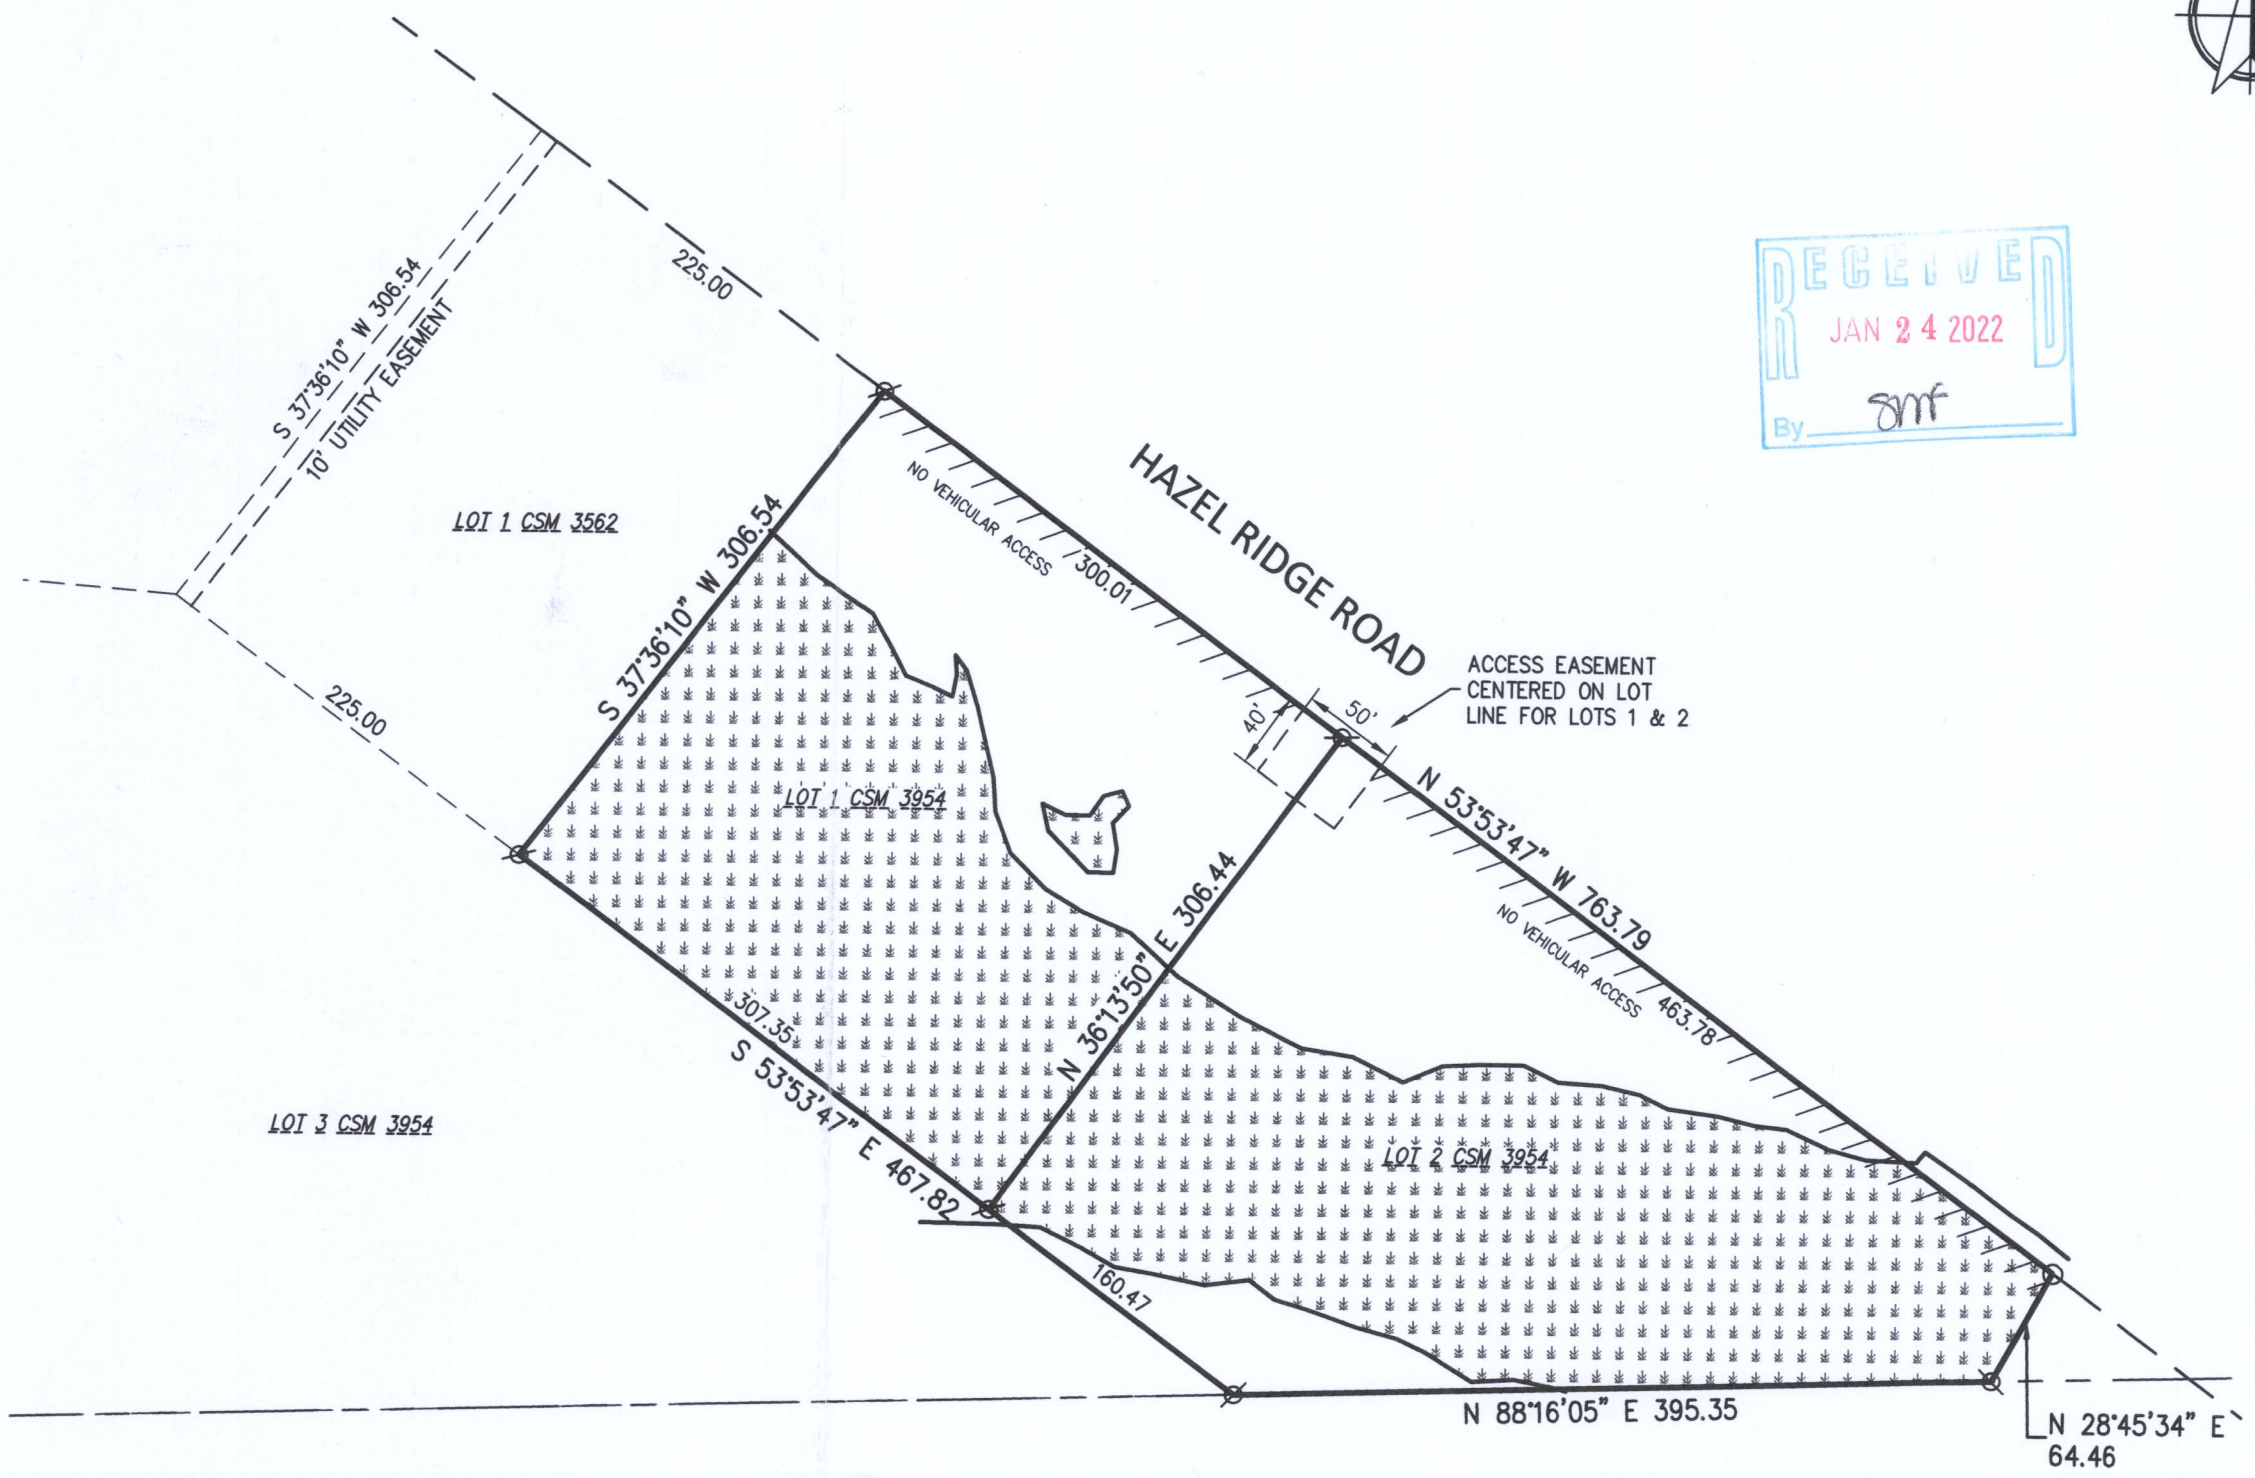

NOTES
BEARING BASE: GRID NORTH, WISCONSIN
COORDINATE SYSTEM, SOUTH ZONE.
BASED UPON NAD 1983 / 2011.

WETLANDS DELINEATED BY S.E.W.R.P.C. ON
OCTOBER 20, 2021.

LEGEND
X 3/4" REBAR FOUND
O 1-1/2" IRON STAKE FOUND

mb Nielsen Madsen + Barber
CIVIL ENGINEERS AND LAND SURVEYORS
1458 Horizon Blvd. Suite 200, Racine, WI. 53406
Tele: (262)634-5588 Website: www.nmbasc.net

FIELD WORK 12-02-21 BY JWP
DRAWN 12-03-2021 BY SCB
SCALE 1" = 100'
SHEET 1 OF 1 SHEETS
JOB NO. 2021.0299.01

YA3954-1 YA3954-2

004-2764

Monday, December 06, 2021 7:22:04 AM