


PLAT OF SURVEY

Of Lot 1, Block 43, Davis Addition to the city of Elkhorn, Walworth County, Wisconsin.

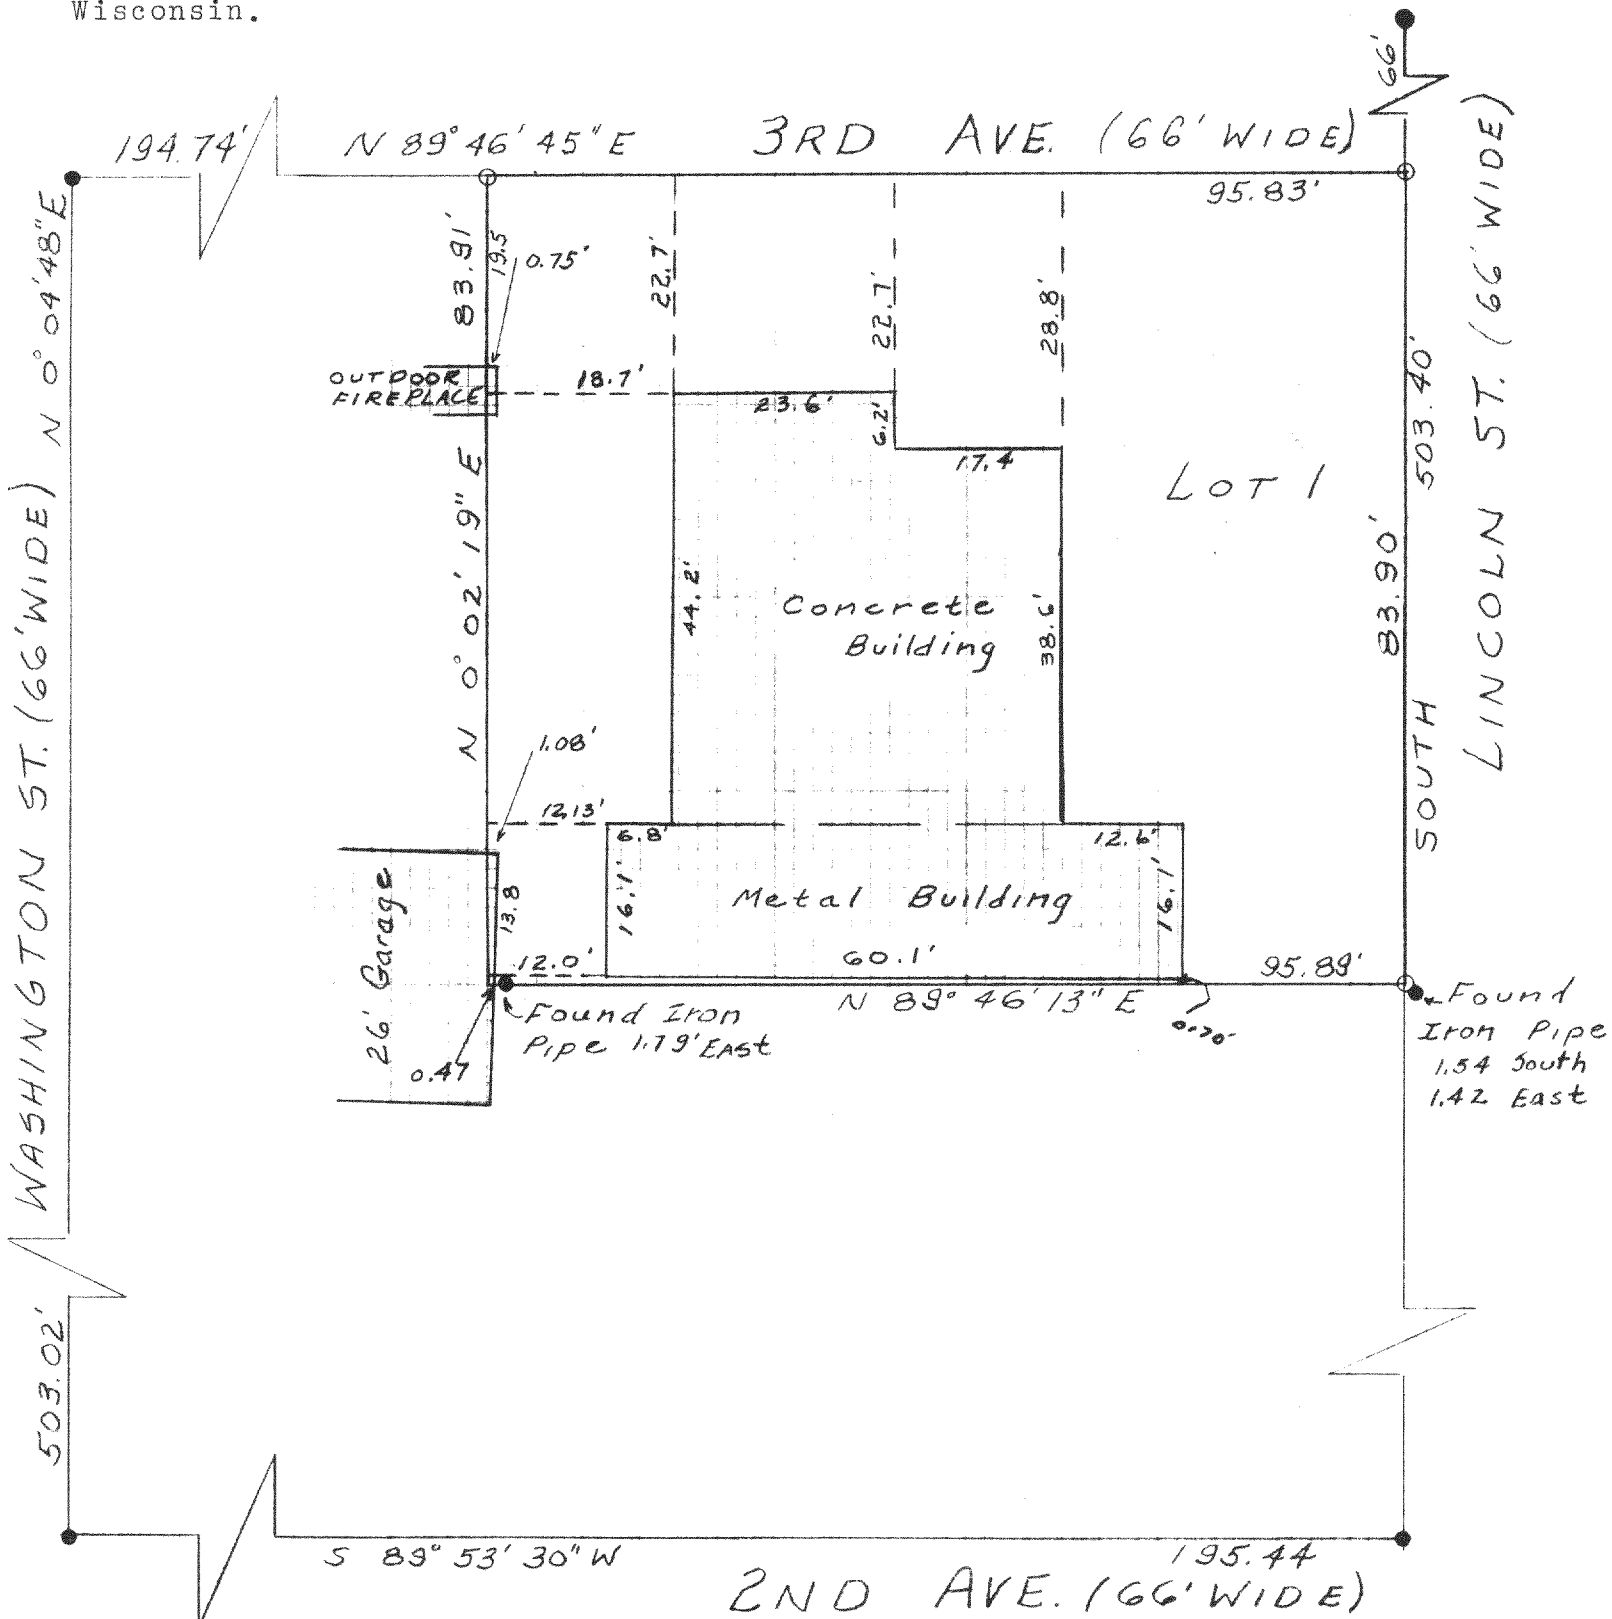

- Found Iron Pipe
- o Set Iron Pipe

I certify that I have surveyed the above described property and that the plat shown hereon is an accurate survey and a true representation thereof and correctly shows the boundary lines of said property and all buildings thereon.

June 6, 1978

Thomas P. A. Jensen
 Thomas P. A. Jensen
 Jensen Surveying and Mapping
 Elkhorn, Wi.

Owner: Gerald Norton



Scale 1" = 20'

VO-47

1978.030

004-276J