


#205-67

● Indicates Iron Stake

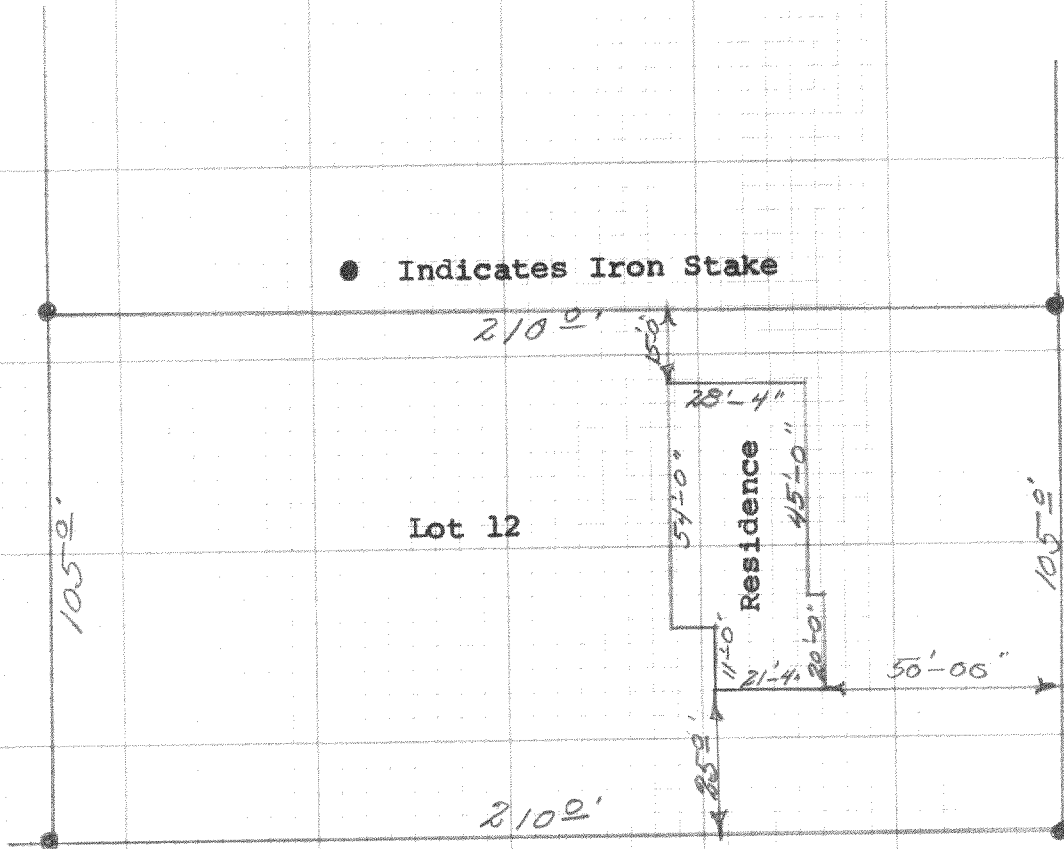

Robincroast

Lane

DESCRIPTION:

Lot 12 Green Acres Subdivision of a portion of Section 8, Town 2 north, Range 17 east, Geneva Township, Walworth County, Wisconsin.

CERTIFICATE: I, hereby certify that I have surveyed the above described property on this the 18th day of August 1967.

Dated this 19th day of August 1967.

Carl Elfstrom
 Carl Elfstrom RLS 4903
 Elkhorn, Wisconsin

