


May 15, 1978

Recorded in: Vol. 190 P. 229 & 230 Deeds.

Thomas P.A. Jensen
Thomas P.A. Jensen S-1084
JENSEN SURVEYING & MAPPING
ELKHORN, WISCONSIN

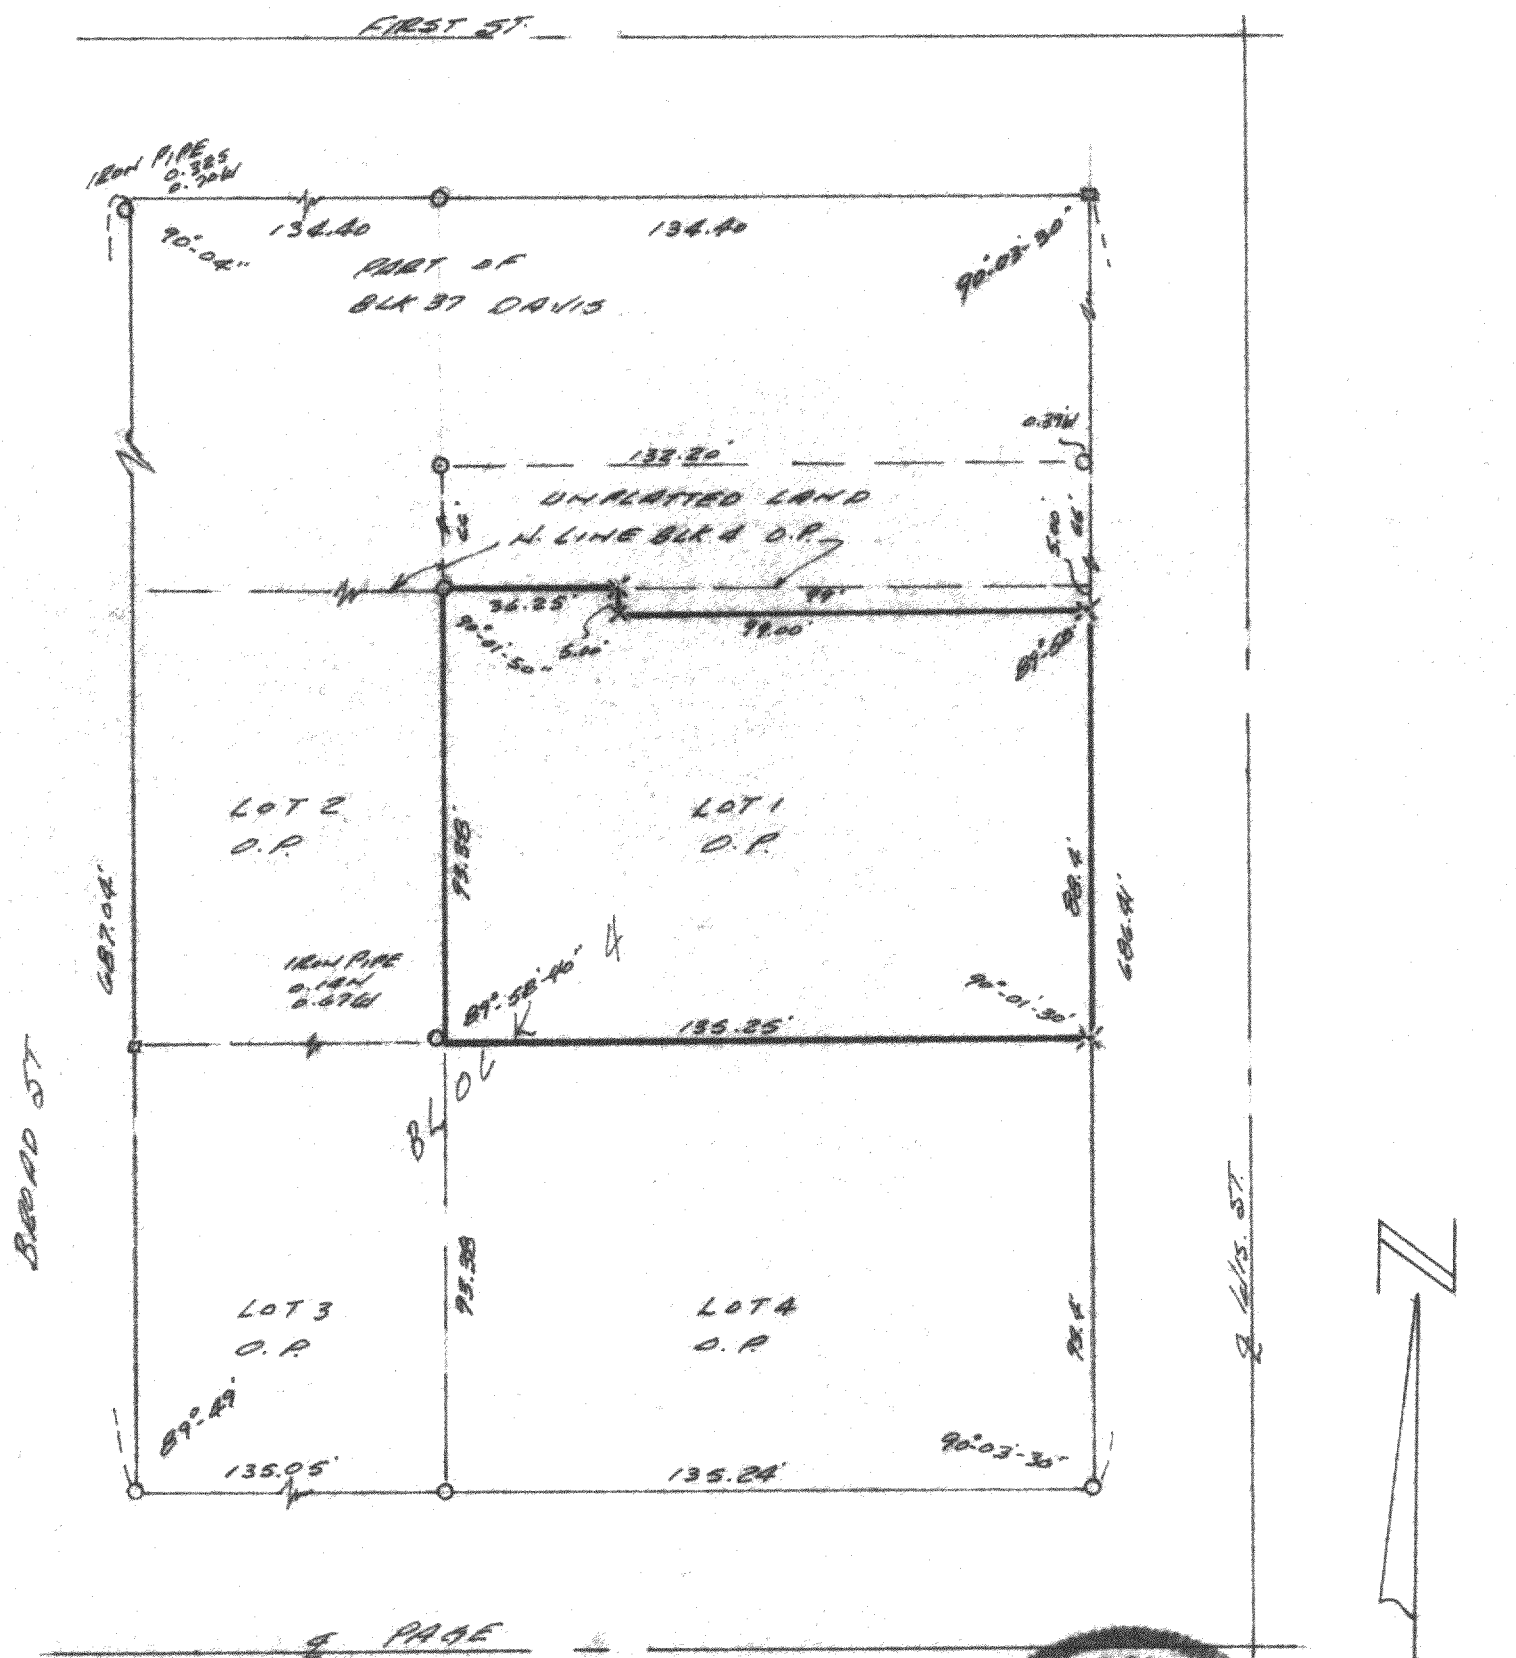

O ~ IRON PIPE FOUND
 □ ~ IRON ROD FOUND
 X ~ CROSS CUT IN CONCRETE & PAINTED



SCALE 1" = 40'

40 P-7

4-277 J