


ELKDALE LANE

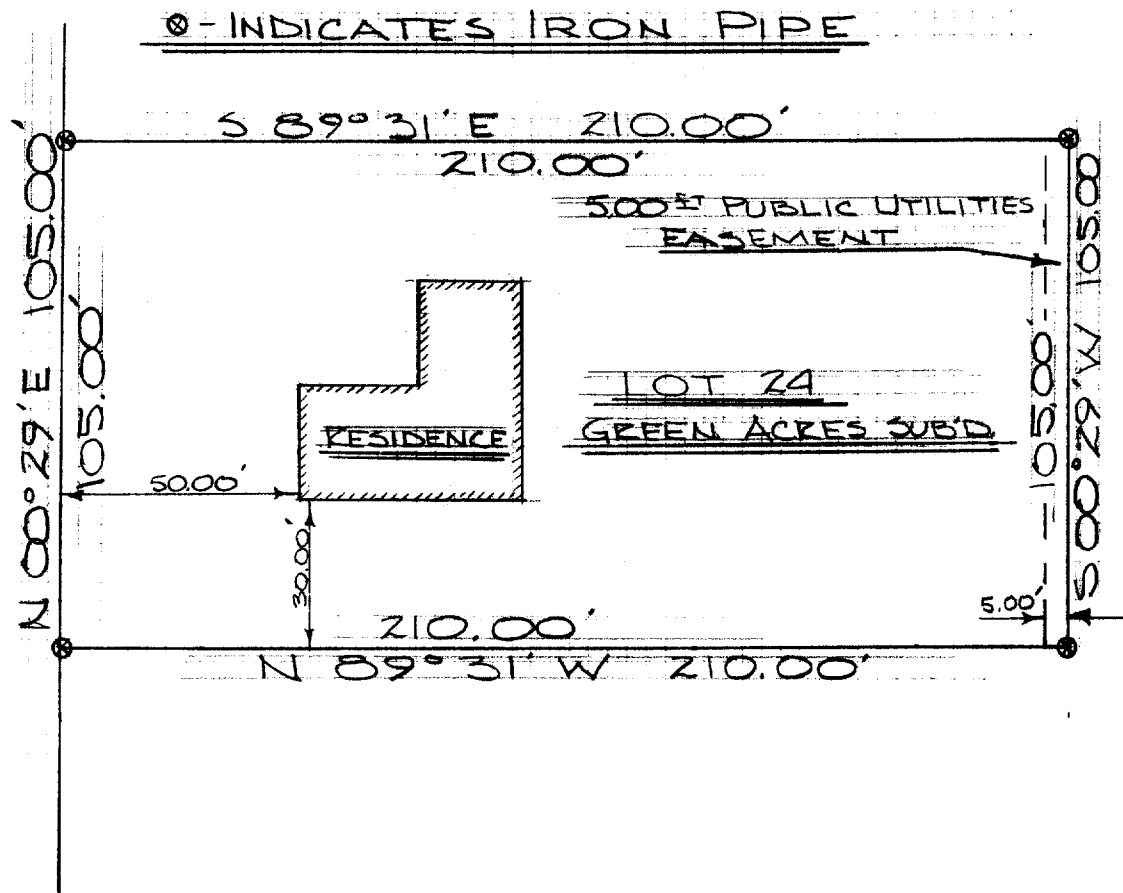


DESCRIPTION: Lot 24 of Green Acres Subdivision located in Section 8, T. 2 N., R. 17 E., Walworth County, Wisconsin.

CERTIFICATE: I, James F. Biagi, surveyor, do hereby certify that I have surveyed the property hereon described, and that the location of the improvements are as shown.

December 19, 1969.

James F. Biagi, R.L.S. 272

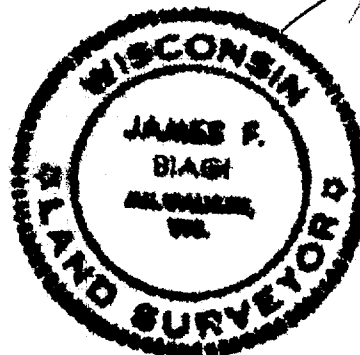

ENGINEERS ASSOCIATED, INC.
203 W. WALWORTH STREET
ELKHORN, WISCONSIN 53121

4-278

217-1273