


HAROLD H. KOLB

REGISTERED PROFESSIONAL LAND SURVEYOR
LAKE GENEVA, WISCONSIN

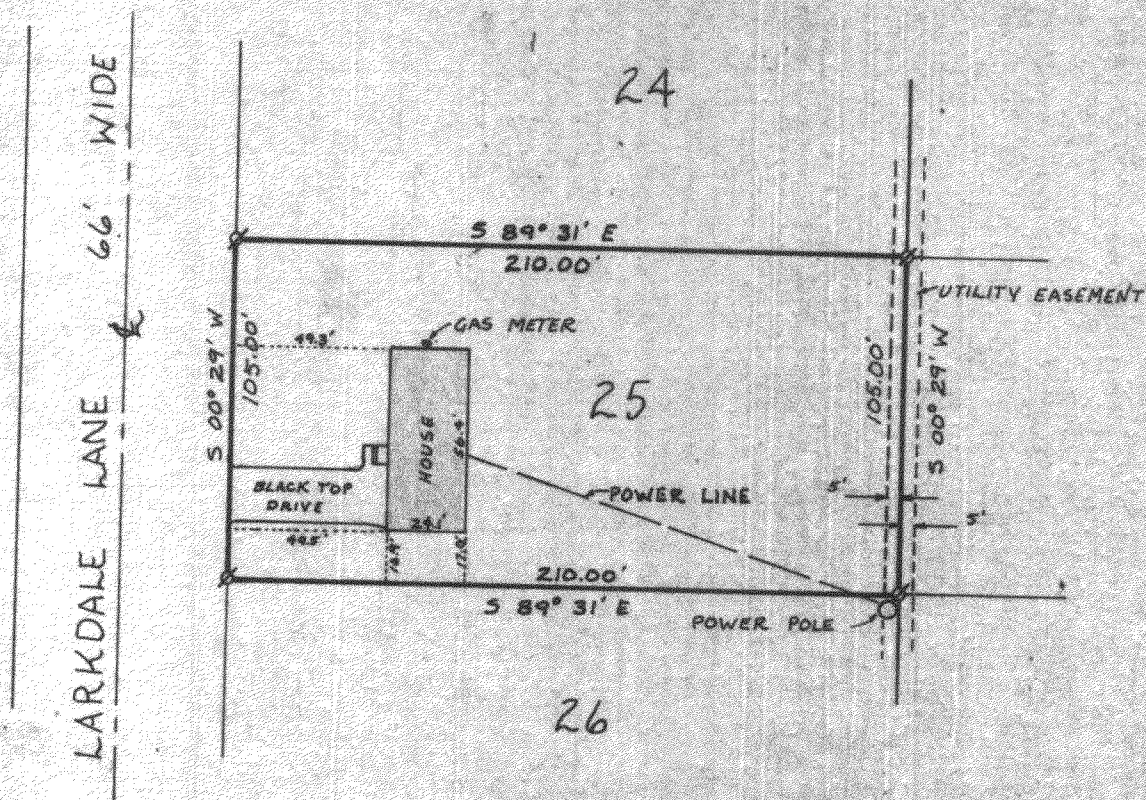

SCALE: 1"=60'

LEGEND

- φ - IRON PIPE FOUND
- O - IRON PIPE PLACED
- - CONCRETE MONUMENT
- X - SPIKE



PLAT OF SURVEY OF

Lot 25, Green Acres Subdivision, located
in the Northwest 1/4 of Section 8, T2N, R17E,
Walworth County, Wisconsin.

NOTE: Bearings assumed as platted.

Ordered by: Knight Realty
P.O. BOX 15
Elkhorn, Wisc.

EUGENE BLOMQUIST DO HEREBY CERTIFY THAT I HAVE
SURVEYED THE PROPERTY HEREON DESCRIBED ACCORDING
TO THE OFFICIAL RECORDS, AND THAT THE PLAT HEREON
IS A CORRECT REPRESENTATION OF THE LOT LINES.

EUGENE A. BLOMQUIST
WISCONSIN REGISTERED LAND SURVEYOR, S1279
DATE Jan 23, 1979

YGR-25

4-279
~~217-553~~