


PLAT OF SURVEY & TOPOGRAPHIC MAPPING
LOT 8 AND THE EAST 1/2 OF LOT 7 OF BLOCK 19 OF THE ORIGINAL PLAT OF ELKHORN
LOCATED IN PART OF THE SW 1/4 OF THE SE 1/4 OF SECTION 36, TOWN 4 NORTH, RANGE 16 EAST, CITY OF ELKHORN, WALWORTH COUNTY, WISCONSIN

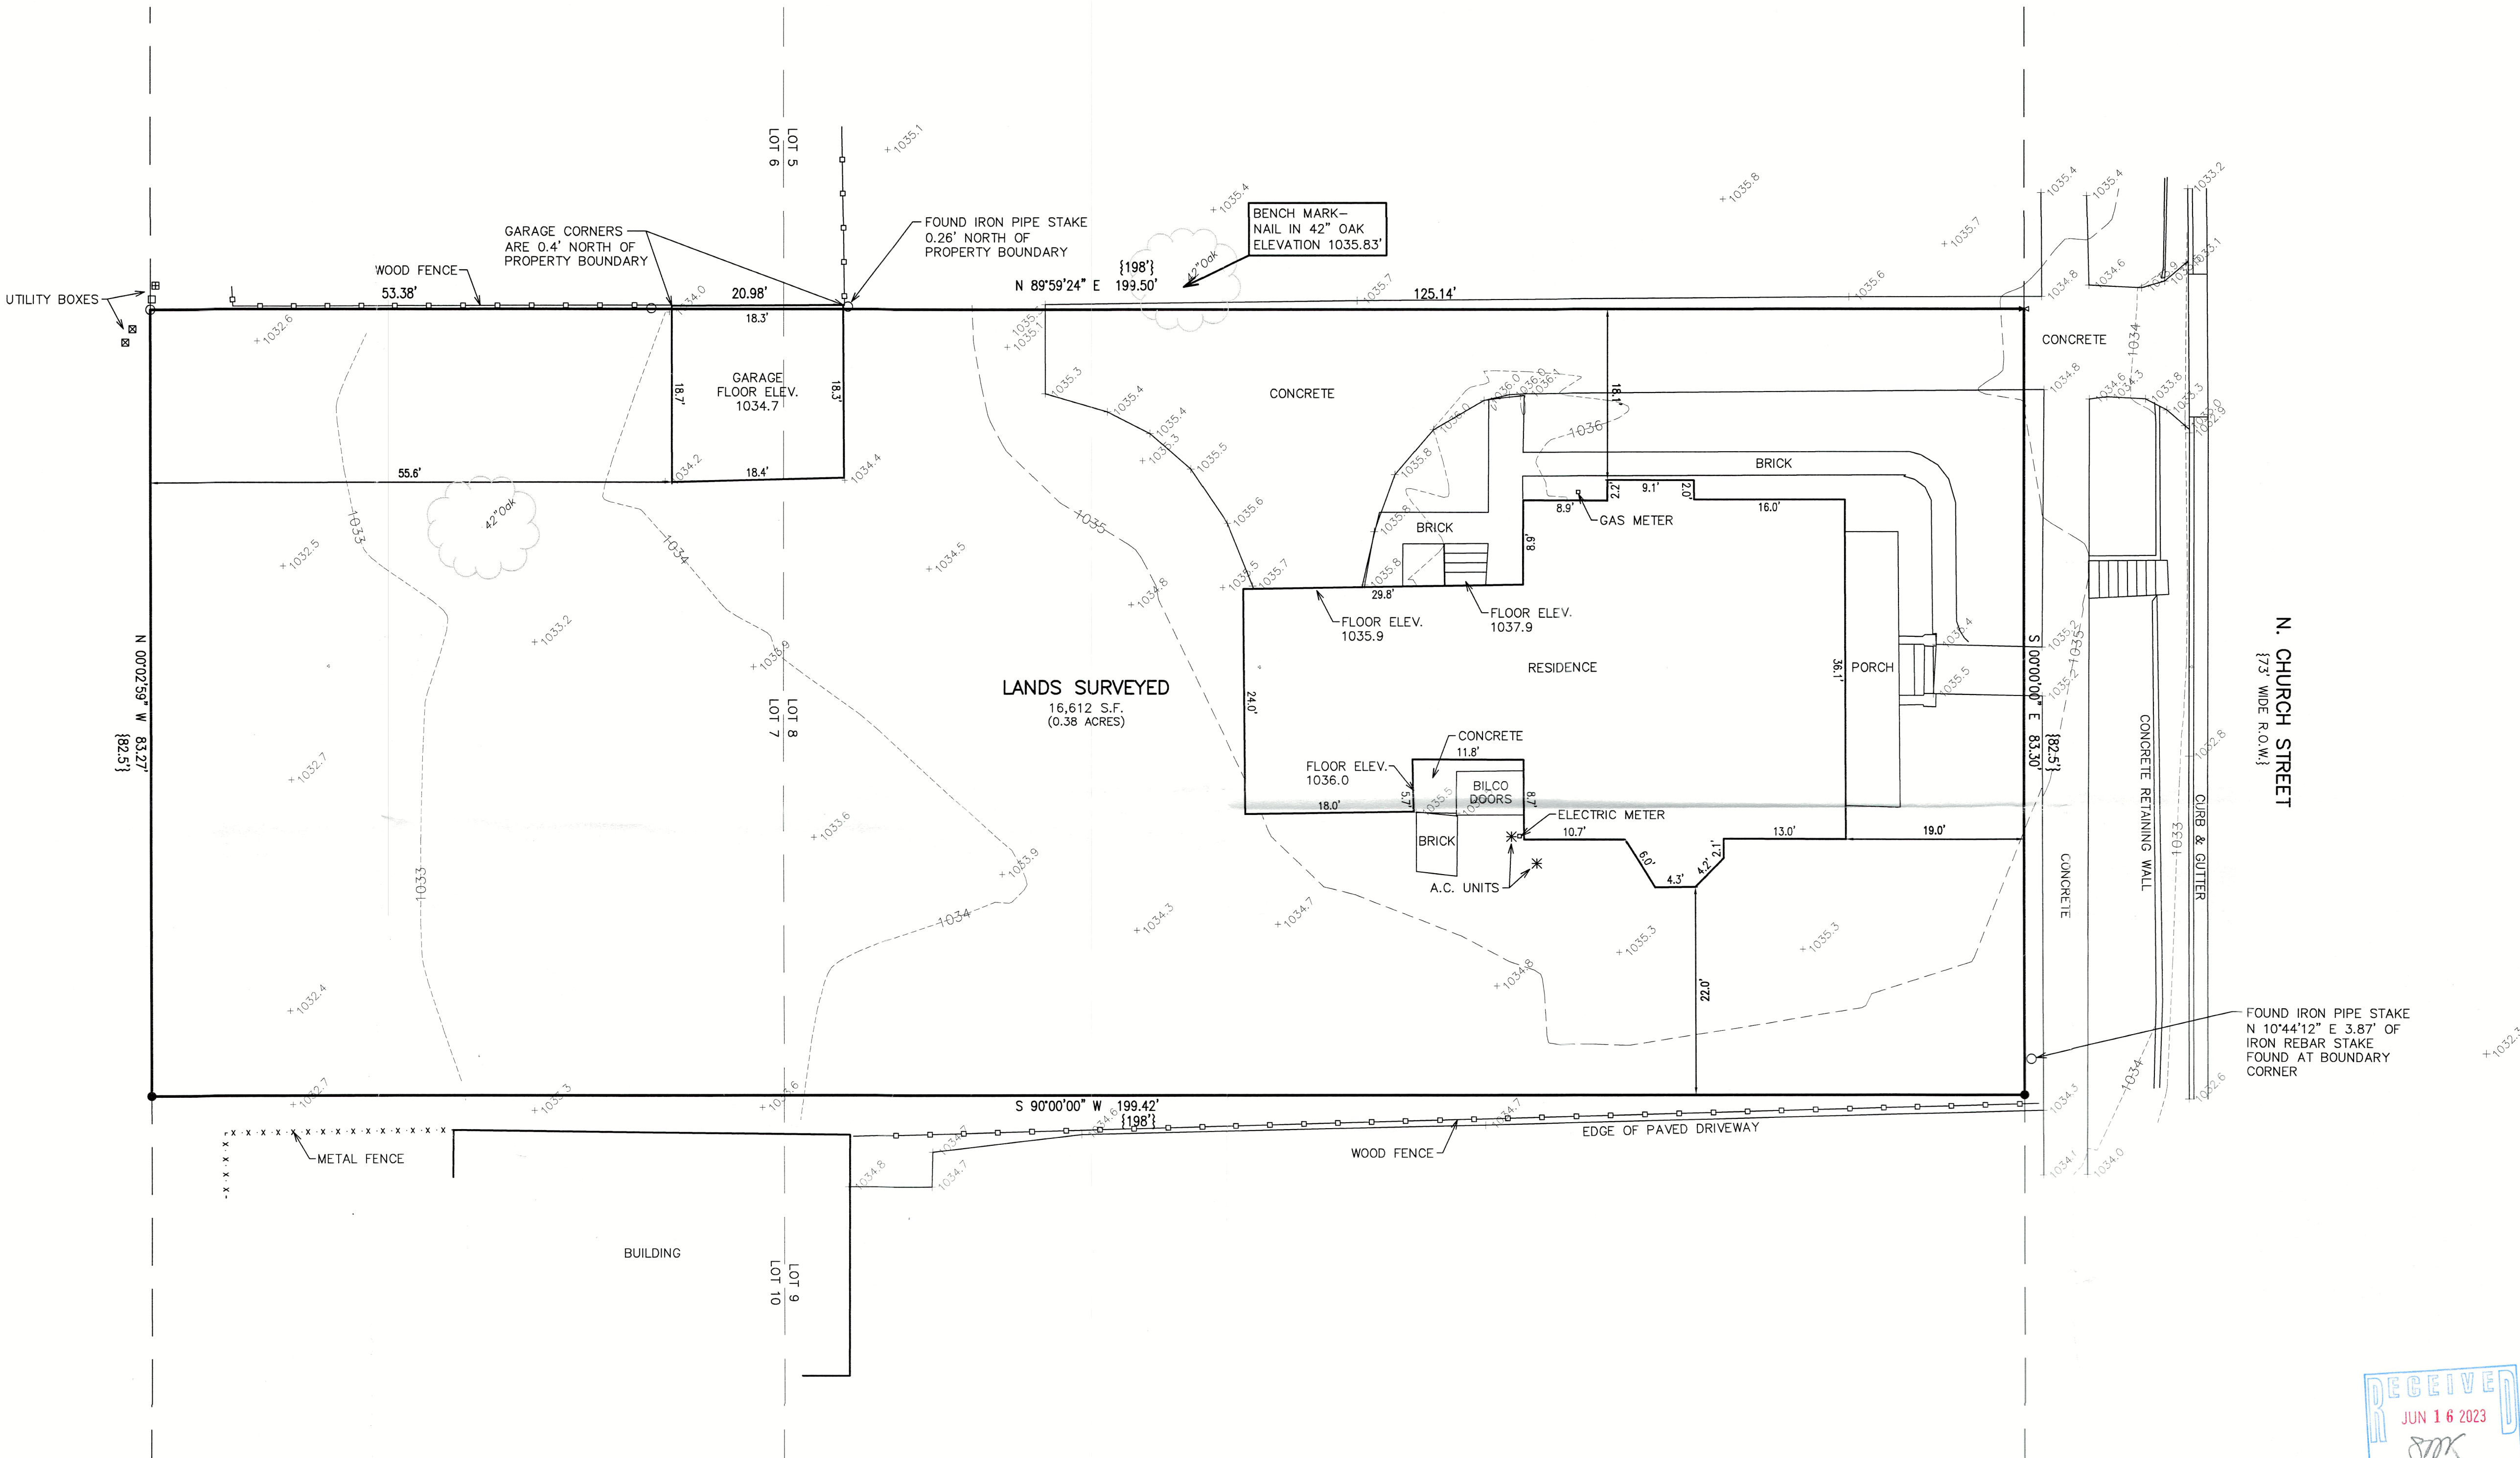

LEGEND
○ = FOUND IRON PIPE STAKE
● = FOUND IRON REBAR STAKE
✕ = FOUND CHISELED "X" IN CONCRETE
{xxx} = RECORDED AS

MAP SCALE IN FEET - ORIGINAL 1"=10'
10 5 0 10 20 30 40

NOTE: COPIES OF THIS MAP TO WHICH THE FOLLOWING CERTIFICATE WILL APPLY SHOW THE SURVEYOR'S ORIGINAL SEAL AND SIGNATURE IN RED INK. COPIES BY ANY OTHER MEANS MAY HAVE ALTERATIONS WHICH DO NOT REPRESENT THE SURVEYOR'S WORK PRODUCT.
I HEREBY CERTIFY THAT THE ABOVE DESCRIBED PROPERTY HAS BEEN SURVEYED UNDER MY DIRECTION AND THAT THE ABOVE MAP IS A TRUE REPRESENTATION THEREOF AND SHOWS THE SIZE AND LOCATION OF THE PROPERTY AND ITS EXTERIOR BOUNDARIES. THIS SURVEY IS MADE FOR THE USE OF THE PRESENT OWNERS OF THE PROPERTY, AND ALSO THOSE WHO PURCHASE, MORTGAGE, OR GUARANTEE THE TITLE THERETO WITHIN ONE YEAR FROM THE DATE HEREOF.

DATED: 4/13/2023

CHRISTOPHER A. HODGES
P.L.S. 2760
ELKHORN, WIS.



TOPOGRAPHIC SURVEY
12 N CHURCH STREET
ELKHORN, WISCONSIN

WORK ORDERED BY -
JULIE TAYLOR
12 N CHURCH STREET
ELKHORN, WI 53121

FARRIS, HANSEN & ASSOCIATES, INC.
ENGINEERING - ARCHITECTURE - SURVEYING
7 RIDGWAY COURT P.O. BOX 437
ELKHORN, WISCONSIN 53121
PHONE: (262) 723-2098 e-mail: office@farris-hansen.com

REVISIONS
PROJECT NO. 10867
DATE 04/13/2023
SHEET NO. 1 OF 1