


LARKDALE

LANE

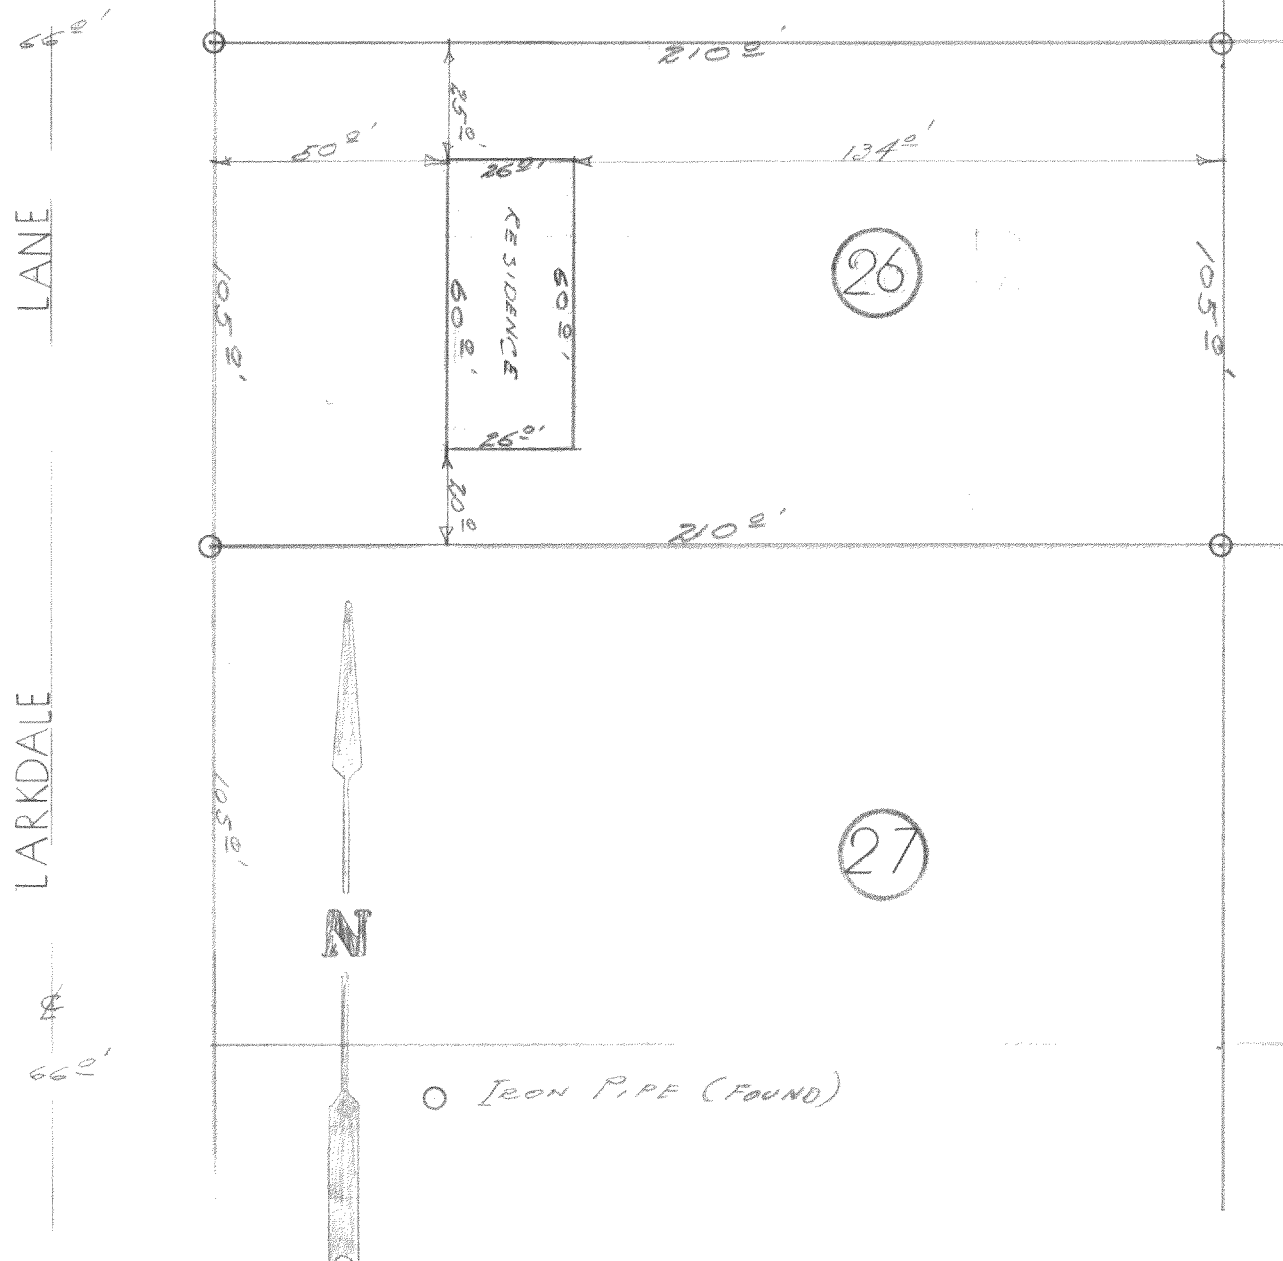

DESCRIPTION:

Lot #26, Green Acres Subdivision of a portion of NW $\frac{1}{4}$ of Section 8, Town 2 North, Range 17 East, Geneva Township Walworth County, Wisconsin.

CERTIFICATE:

I, Joseph M. Biagi, Surveyor, do hereby certify that I have surveyed the lands hereon portrayed and described.

Dated: July 6th 1973.

Joseph M. Biagi
 Joseph M. Biagi, RLS. #12
 Elkhorn, Wisconsin.

4-280