


DUNHAM SURVEYING, S.C.
SURVEYING & SUBDIVIDING
DELAVAN, WISCONSIN 53115

Easterly line of Lincoln Street intersects the Southerly line of the Chicago, Milwaukee, St. Paul and Pacific Railway Company's right of way.

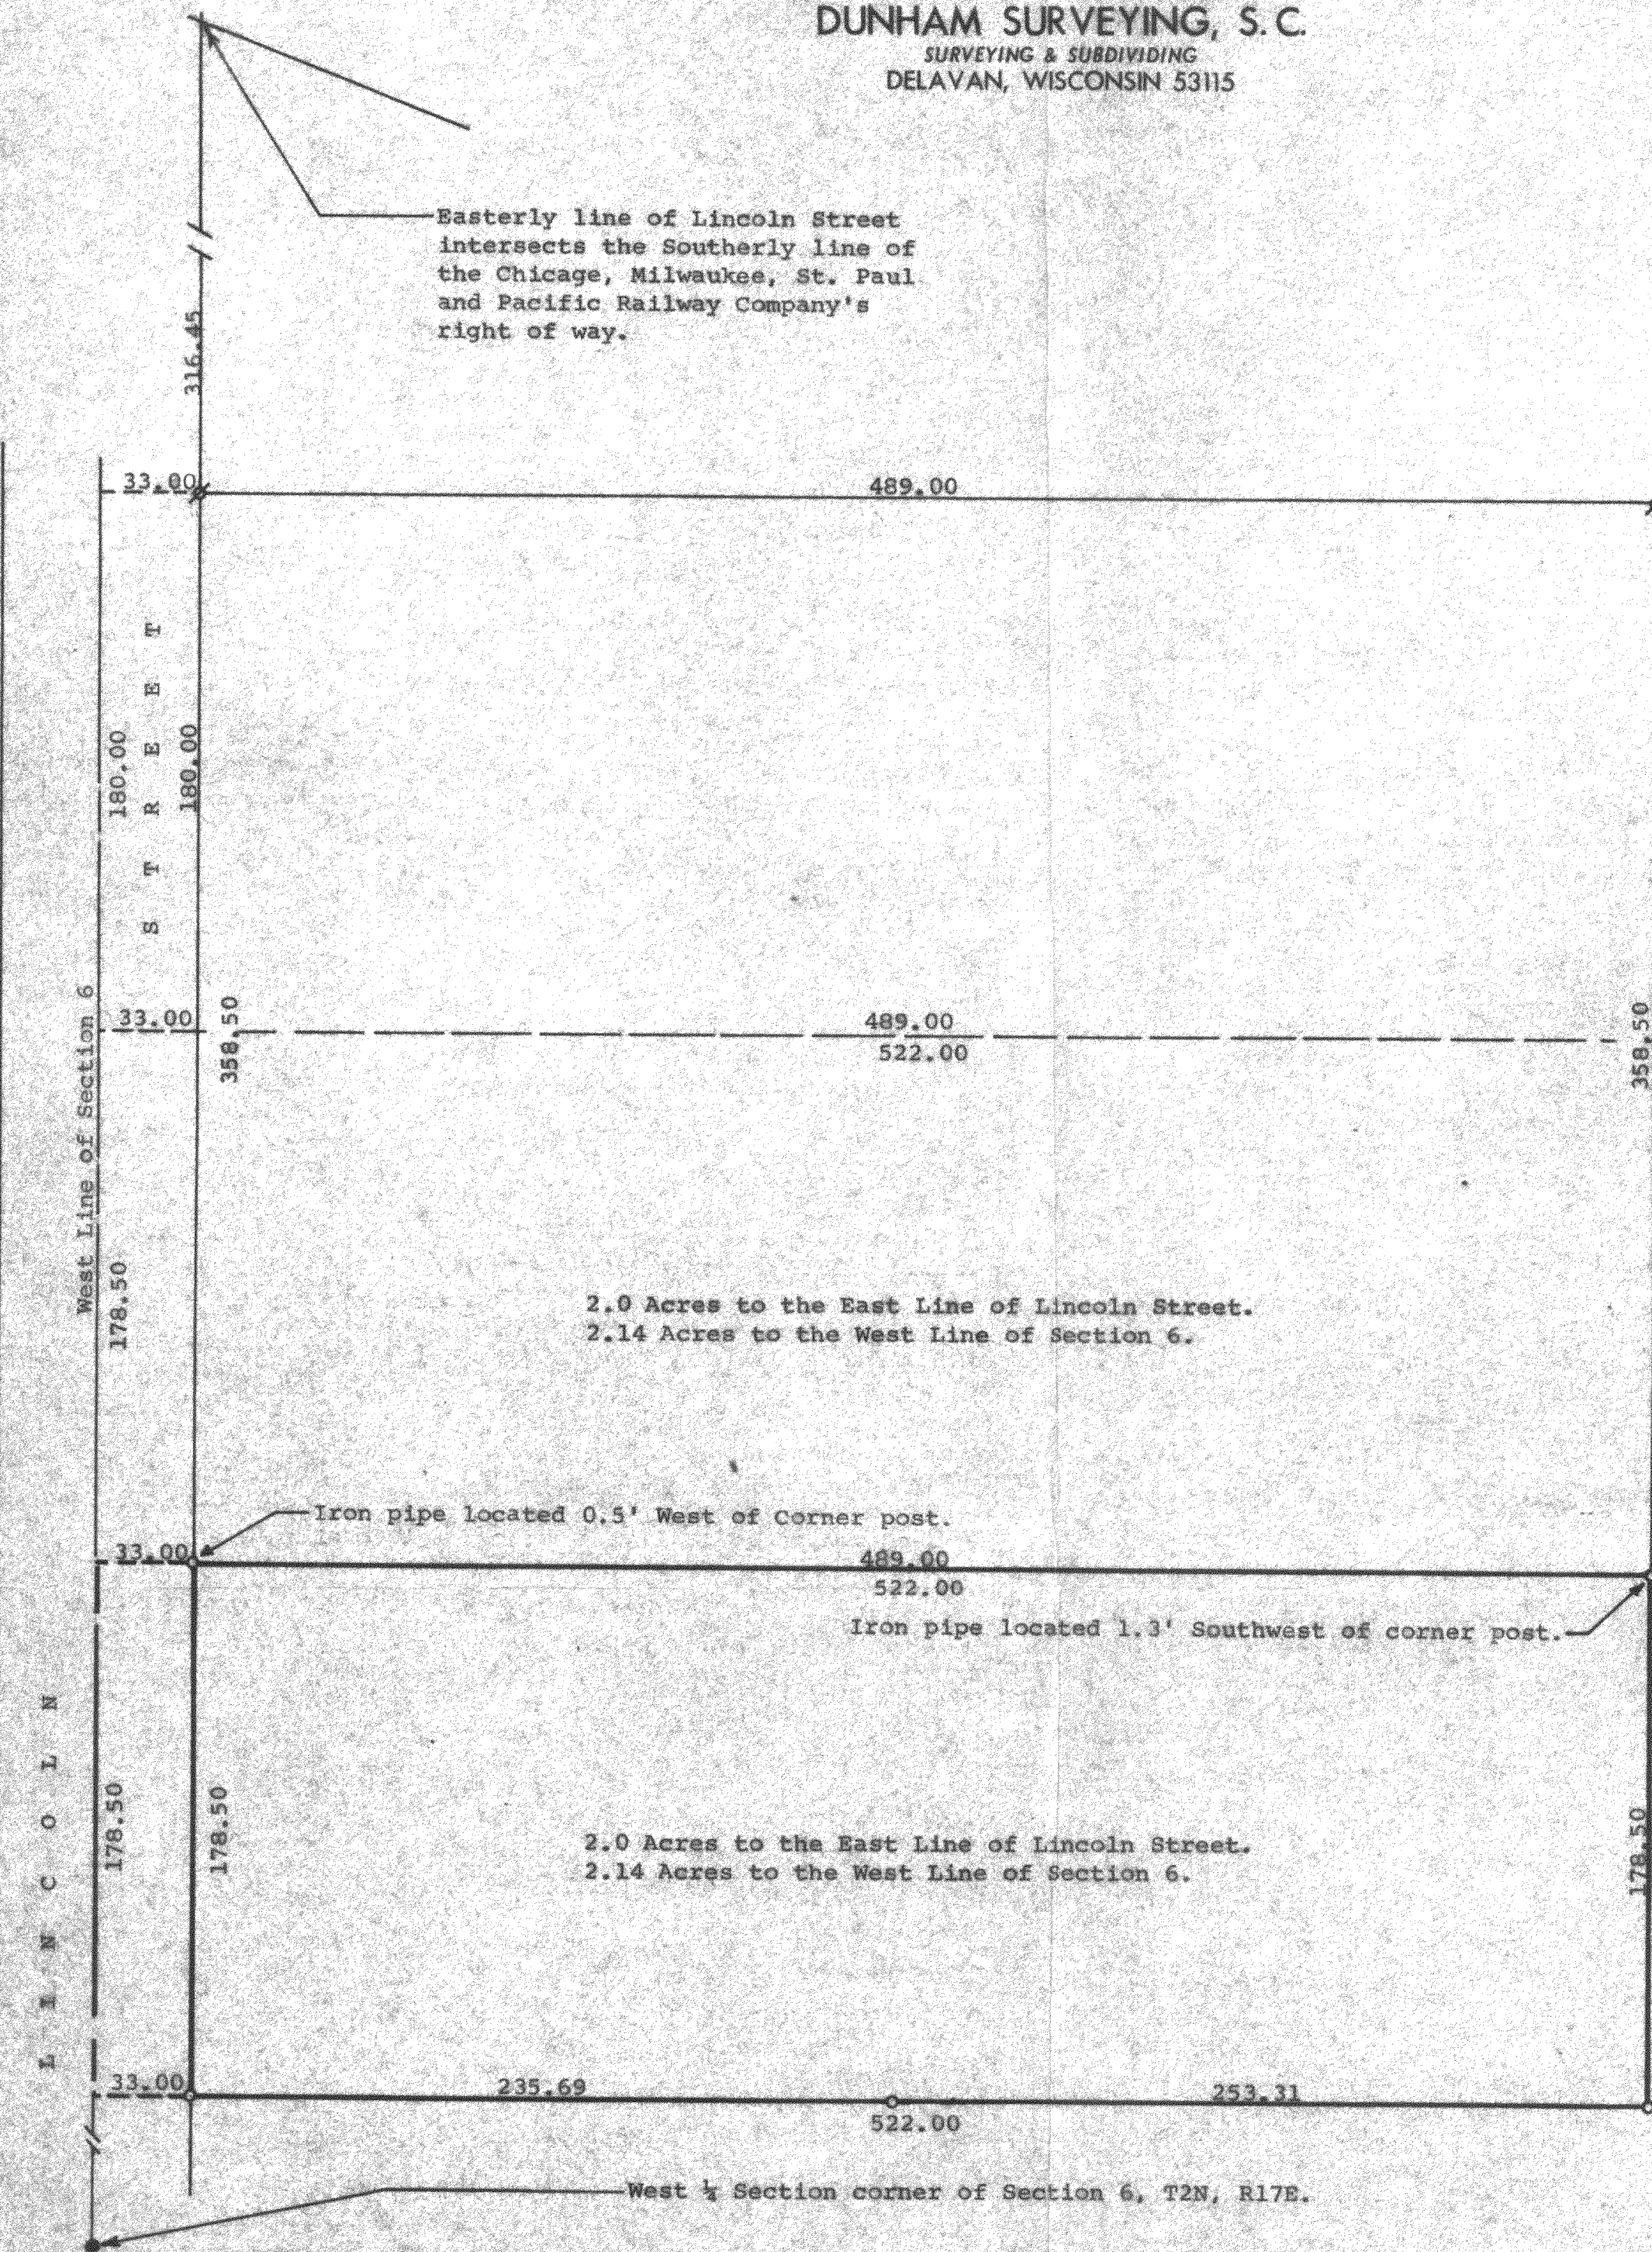


Scale - 1" = 50'
 P = Iron Pipe Found
 O = Iron Pipe Set
 ● = Iron Plug

STATE OF WISCONSIN) SS
 COUNTY OF WALWORTH)

I, George T. Dunham, Surveyor, certify that I have surveyed the property described as follows:

A parcel of land located in the Southwest 1/4 of the Northwest 1/4 of Section 6, T 2 N, R 17 E, City of Elkhorn, Walworth County, Wisconsin, described as follows: Commencing at the intersection of the Easterly line of Lincoln Street and the Southerly right of way line of the Chicago, Milwaukee, St. Paul, and Pacific Railroad Company; thence South along the Easterly line of said street 316.45 feet; thence West 33.00 feet to the centerline of Lincoln Street; thence South along said centerline and the West line of said Section 6, 358.50 feet to the place of beginning; thence continue South in said line 178.50 feet; thence East 522.00 feet; thence North 178.50 feet to the Southeast corner of land owned by the Elkhorn Bus Service, Inc., a corporation; thence West along the South line of said land owned by said Elkhorn Bus Service, Inc. 522.00 feet to the place of beginning. and the above map is a true representation thereof and shows the size and location of the property, its exterior boundaries, the location and dimensions of all structures thereon, fences, apparent easements and roadways and visible encroachments, if any. This survey is made for the exclusive use of the present owners of the property, and also those who purchase, mortgage, or guarantee the title thereto within one (1) year from date hereof; and as to them I warrant the accuracy of said survey and map. December 6, 1978

George T. Dunham
 George T. Dunham, Surveyor

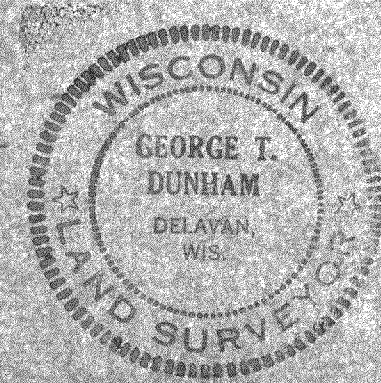

VUSE-16A2

Pg 10B

VSE-16A1

4-281