


DUNHAM SURVEYING, S.C.
SURVEYING & SUBDIVIDING
DELAVER, WISCONSIN 53115

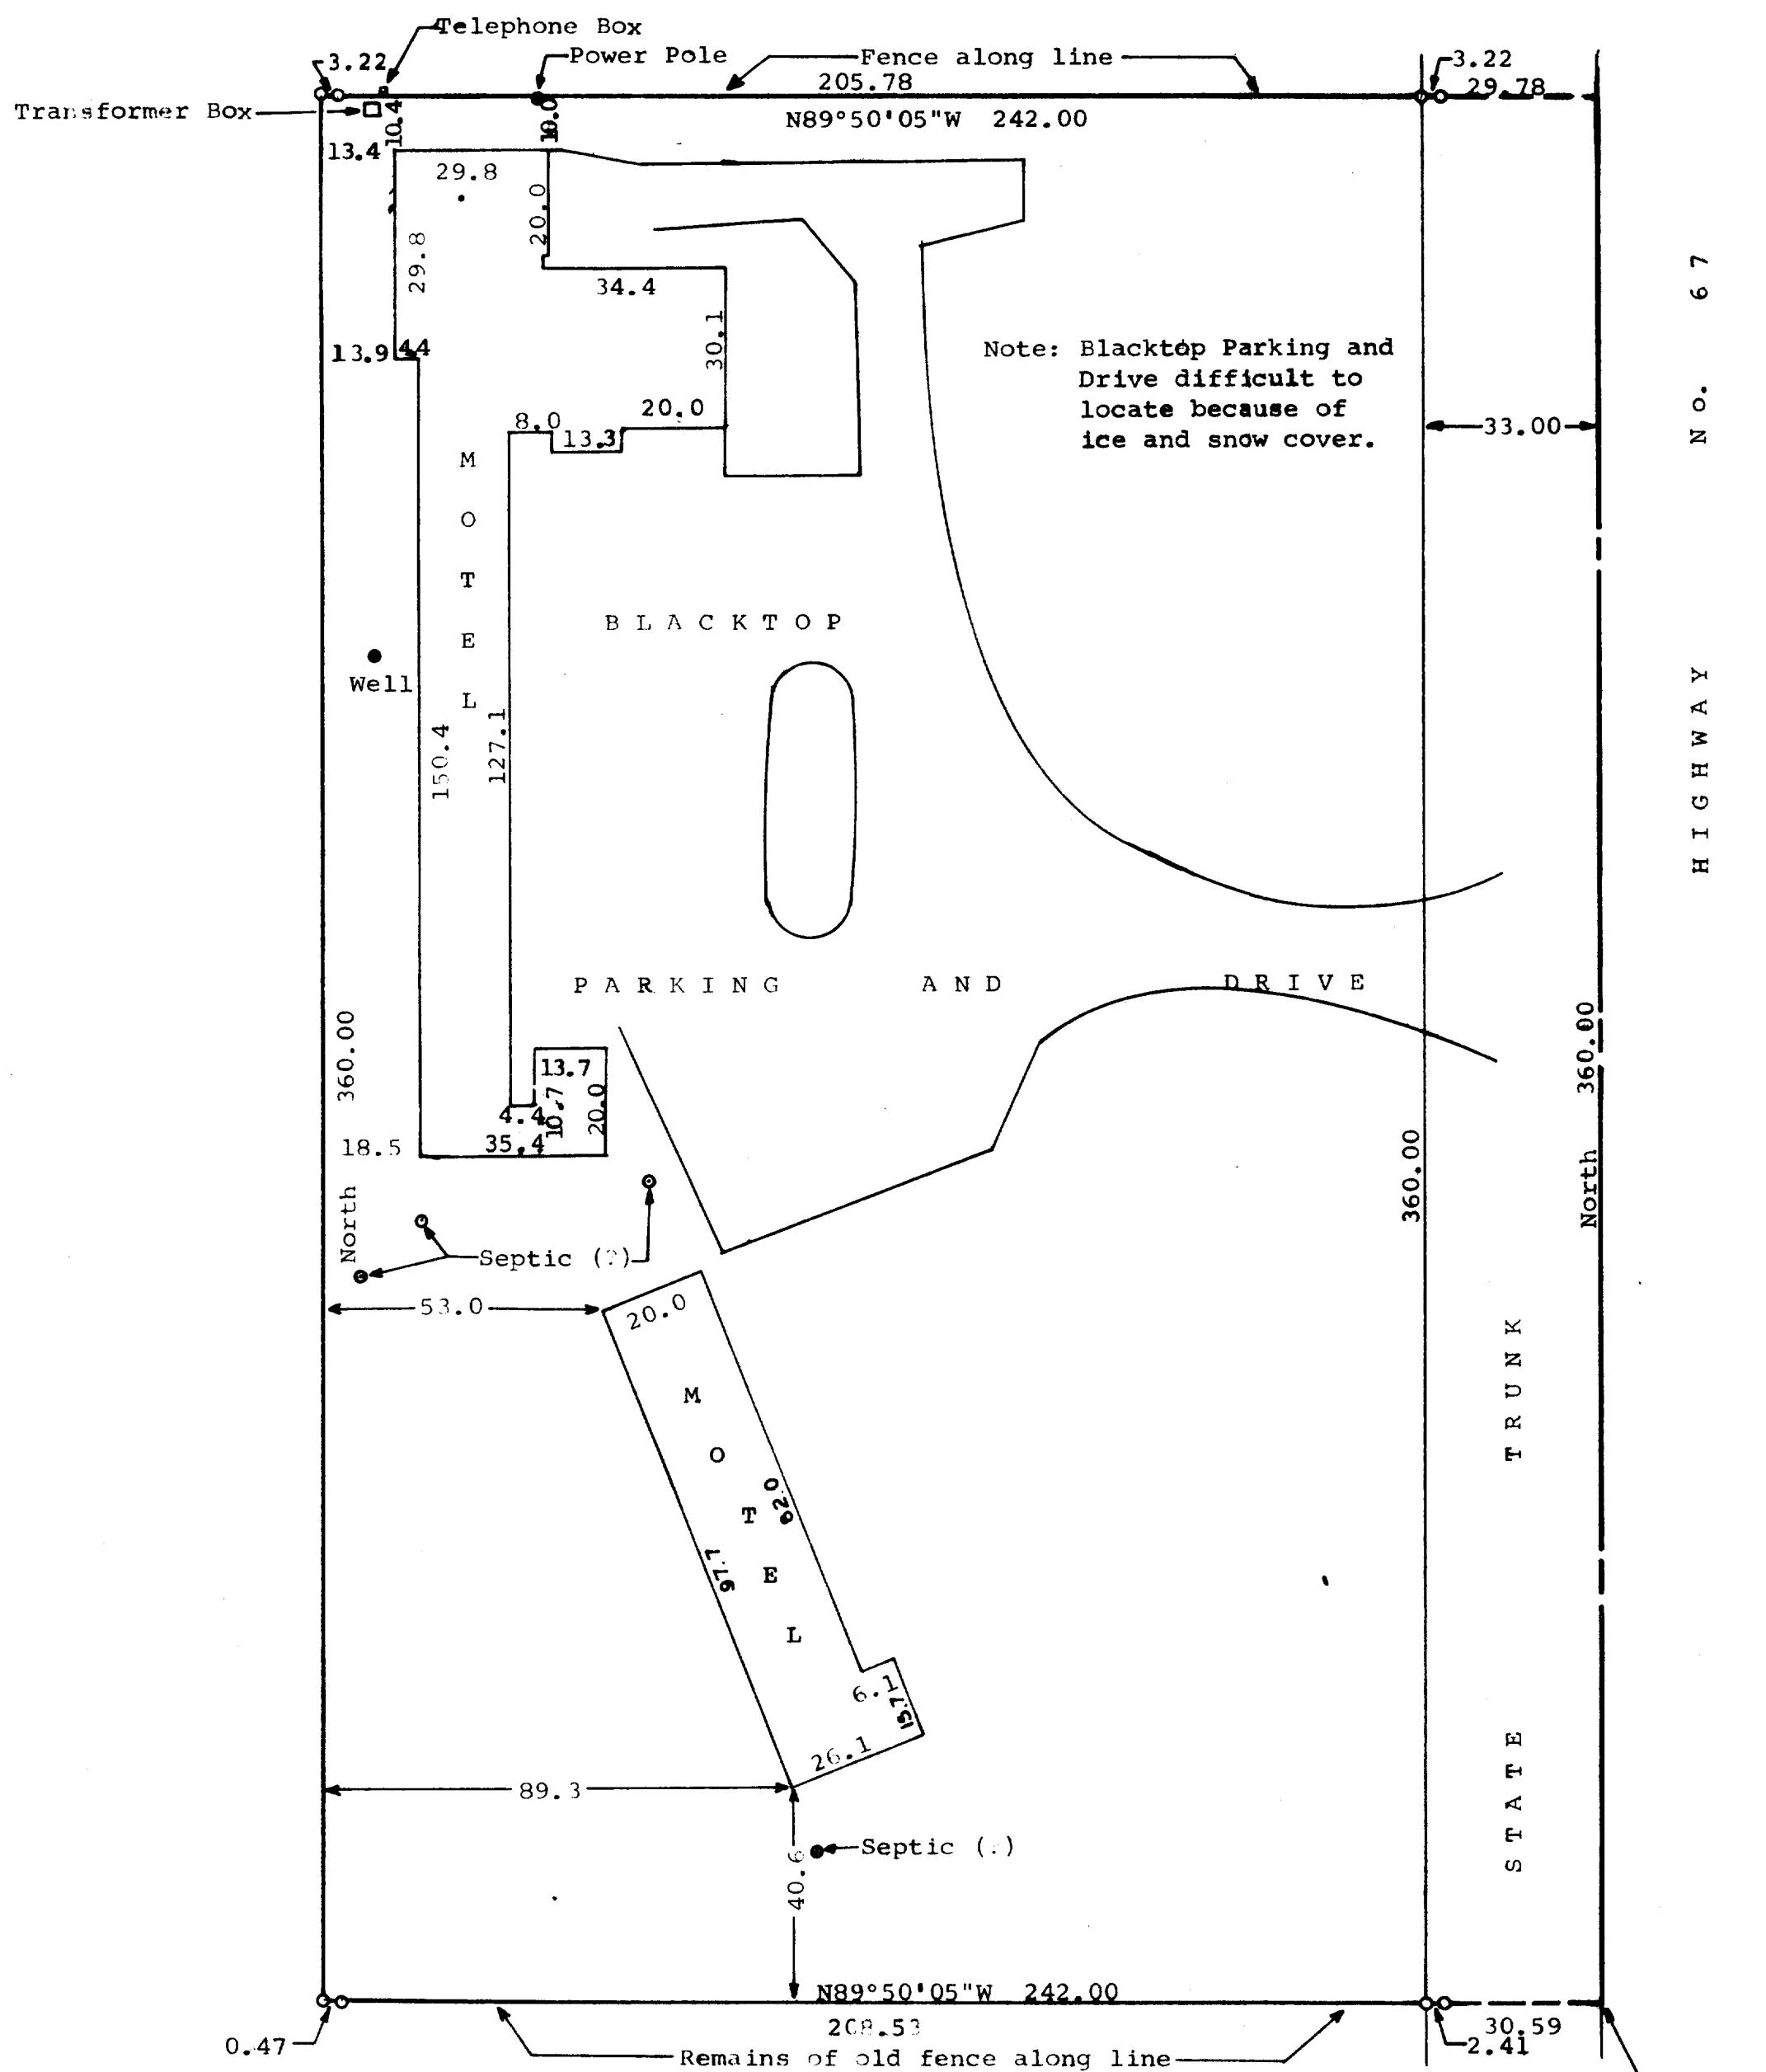

Scale - 1" = 30'
o = Iron Pipe or
Iron Rod Found

The Southeast corner of the
Northeast 1/4 of the Southeast 1/4
of Section 25, T3N, R16E.

STATE OF WISCONSIN)
COUNTY OF WALWORTH) SS


I, George T. Dunham, Surveyor, certify that I have surveyed the
property described as follows,

A parcel of land located in the Northeast 1/4 of the Southeast 1/4
of Section 25, T3N, R16E, Walworth County, Wisconsin described
as follows: Beginning at the Southeast corner of said Northeast 1/4,
which point is the centerline of State Trunk Highway No. 67,
thence West 242.00 feet; thence North parallel with the East line
of said Southeast 1/4 360.00 feet; thence East 242.00 feet to the
East line of said Section 25 and the centerline of said Highway
No. 67; thence South along the East line of said Section 25 360.00
feet to the place of beginning containing 2.0 acres of land
subject to easement of record,

and the above map is a true representation thereof and shows the size
and location of the property, its exterior boundaries, the location
and dimensions of all structures thereon, fences, apparent easements
and roadways and visible encroachments, if any.

This survey is made for the exclusive use of the present owners of
the property, and also those who purchase, mortgage, or guarantee
the title thereto within one (1) year from date hereof; and as to
them I warrant the accuracy of said survey and map.

December 22, 1978

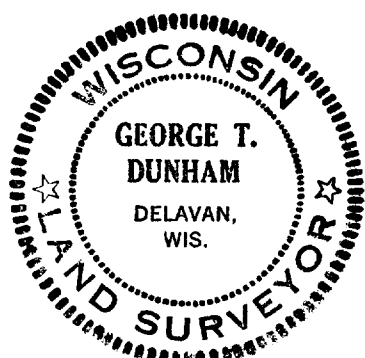

George T. Dunham
George T. Dunham, Surveyor