



KOLB LAND CONSULTING, INC.
WHITEWATER, WISCONSIN

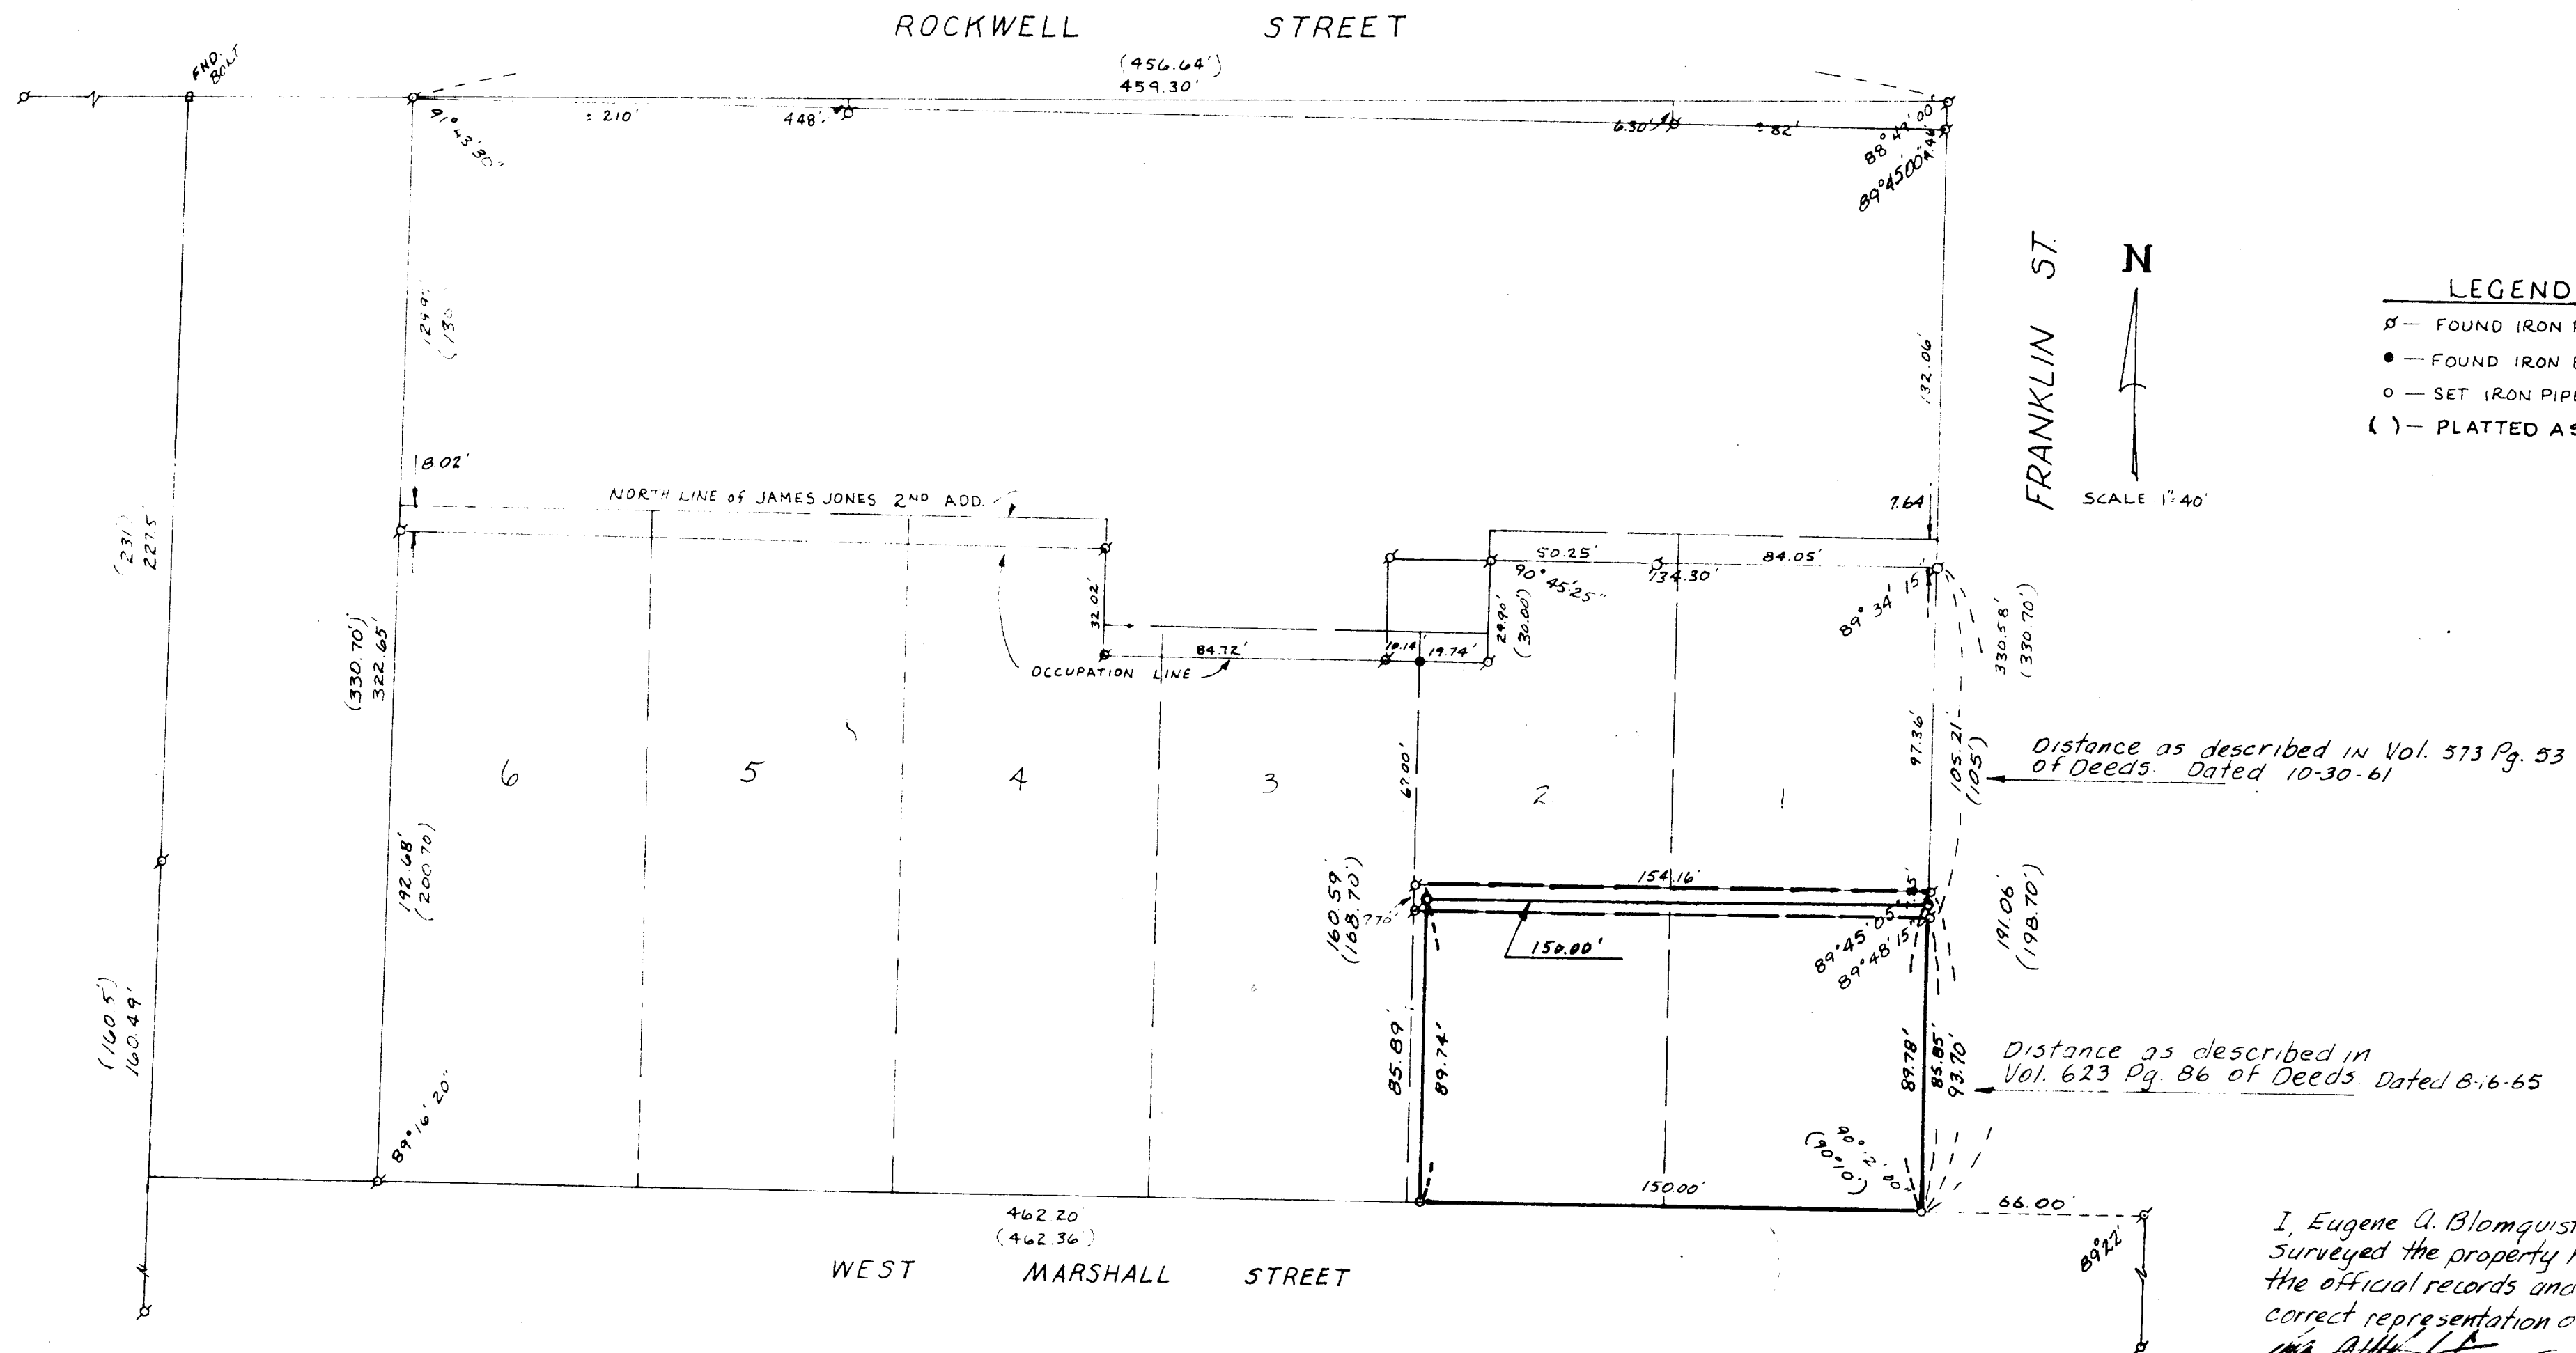

- LEGEND**
- Ø — FOUND IRON PIPE
 - — FOUND IRON BAR
 - — SET IRON PIPE
 - () — PLATTED AS

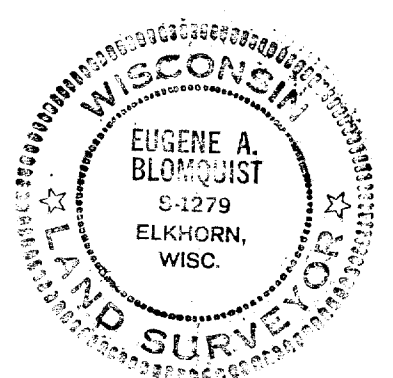

I, Eugene A. Blomquist, do hereby certify that I have surveyed the property hereon described according to the official records and that the Plat hereon is a correct representation of the lot lines.

Eugene A. Blomquist Sept 6, 1979
EUGENE A. BLOMQUIST Wis. Reg. Land Surveyor 5-1279
REV. JULY 11, 1979

Elkhorn - 1 4-2808