



61-65

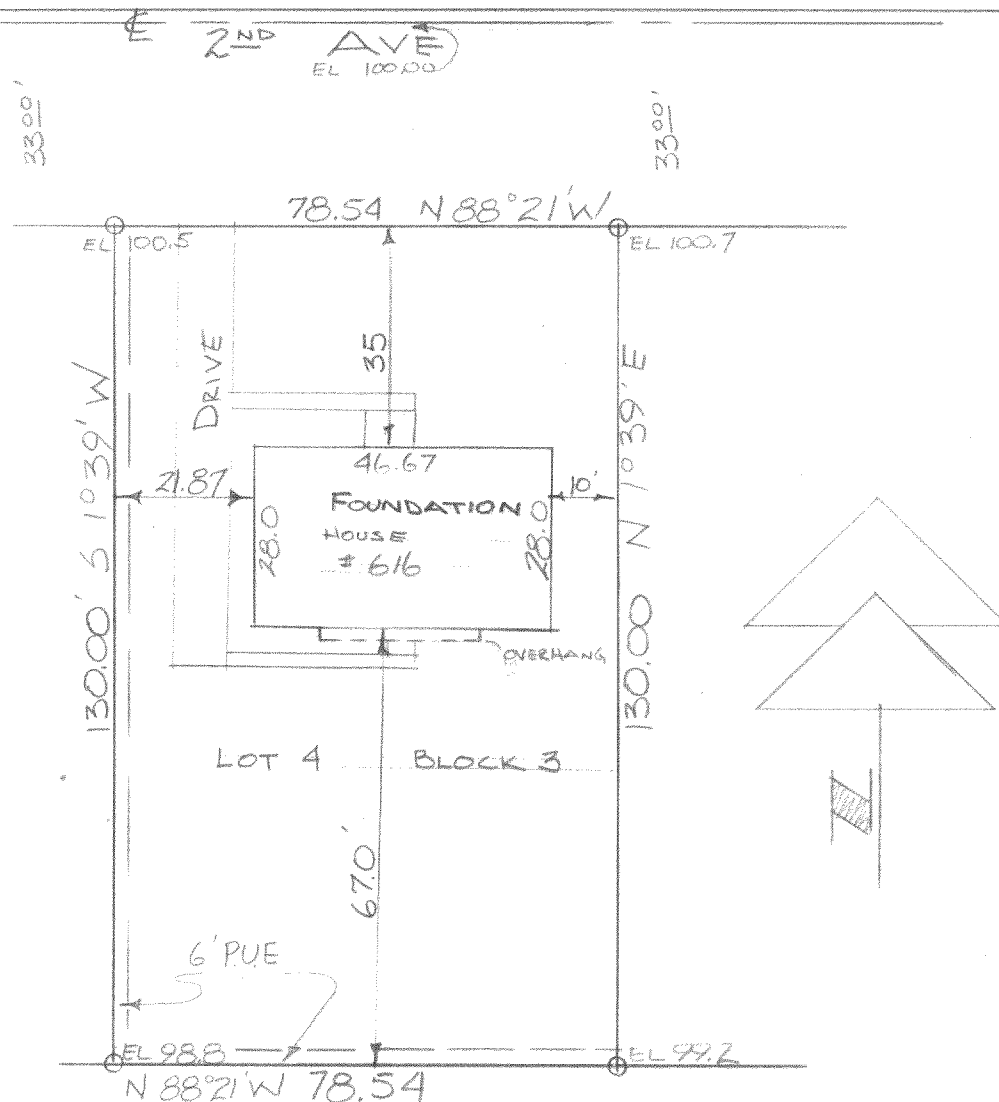

DESCRIPTION: Lot 4 of block 3 of Edgewood Subdivision, in the City of Elkhorn, Walworth County, Wisconsin.

CERTIFICATE: I, James F. Biagi, surveyor, do hereby certify that I have surveyed the property hereon described, and that the location of all the improvements are as shown on the drawing above.

DECEMBER 14, 1961.

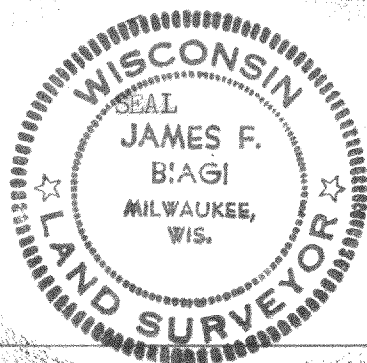

James F. Biagi
James F. Biagi RLS 272

YE-10

4-286