


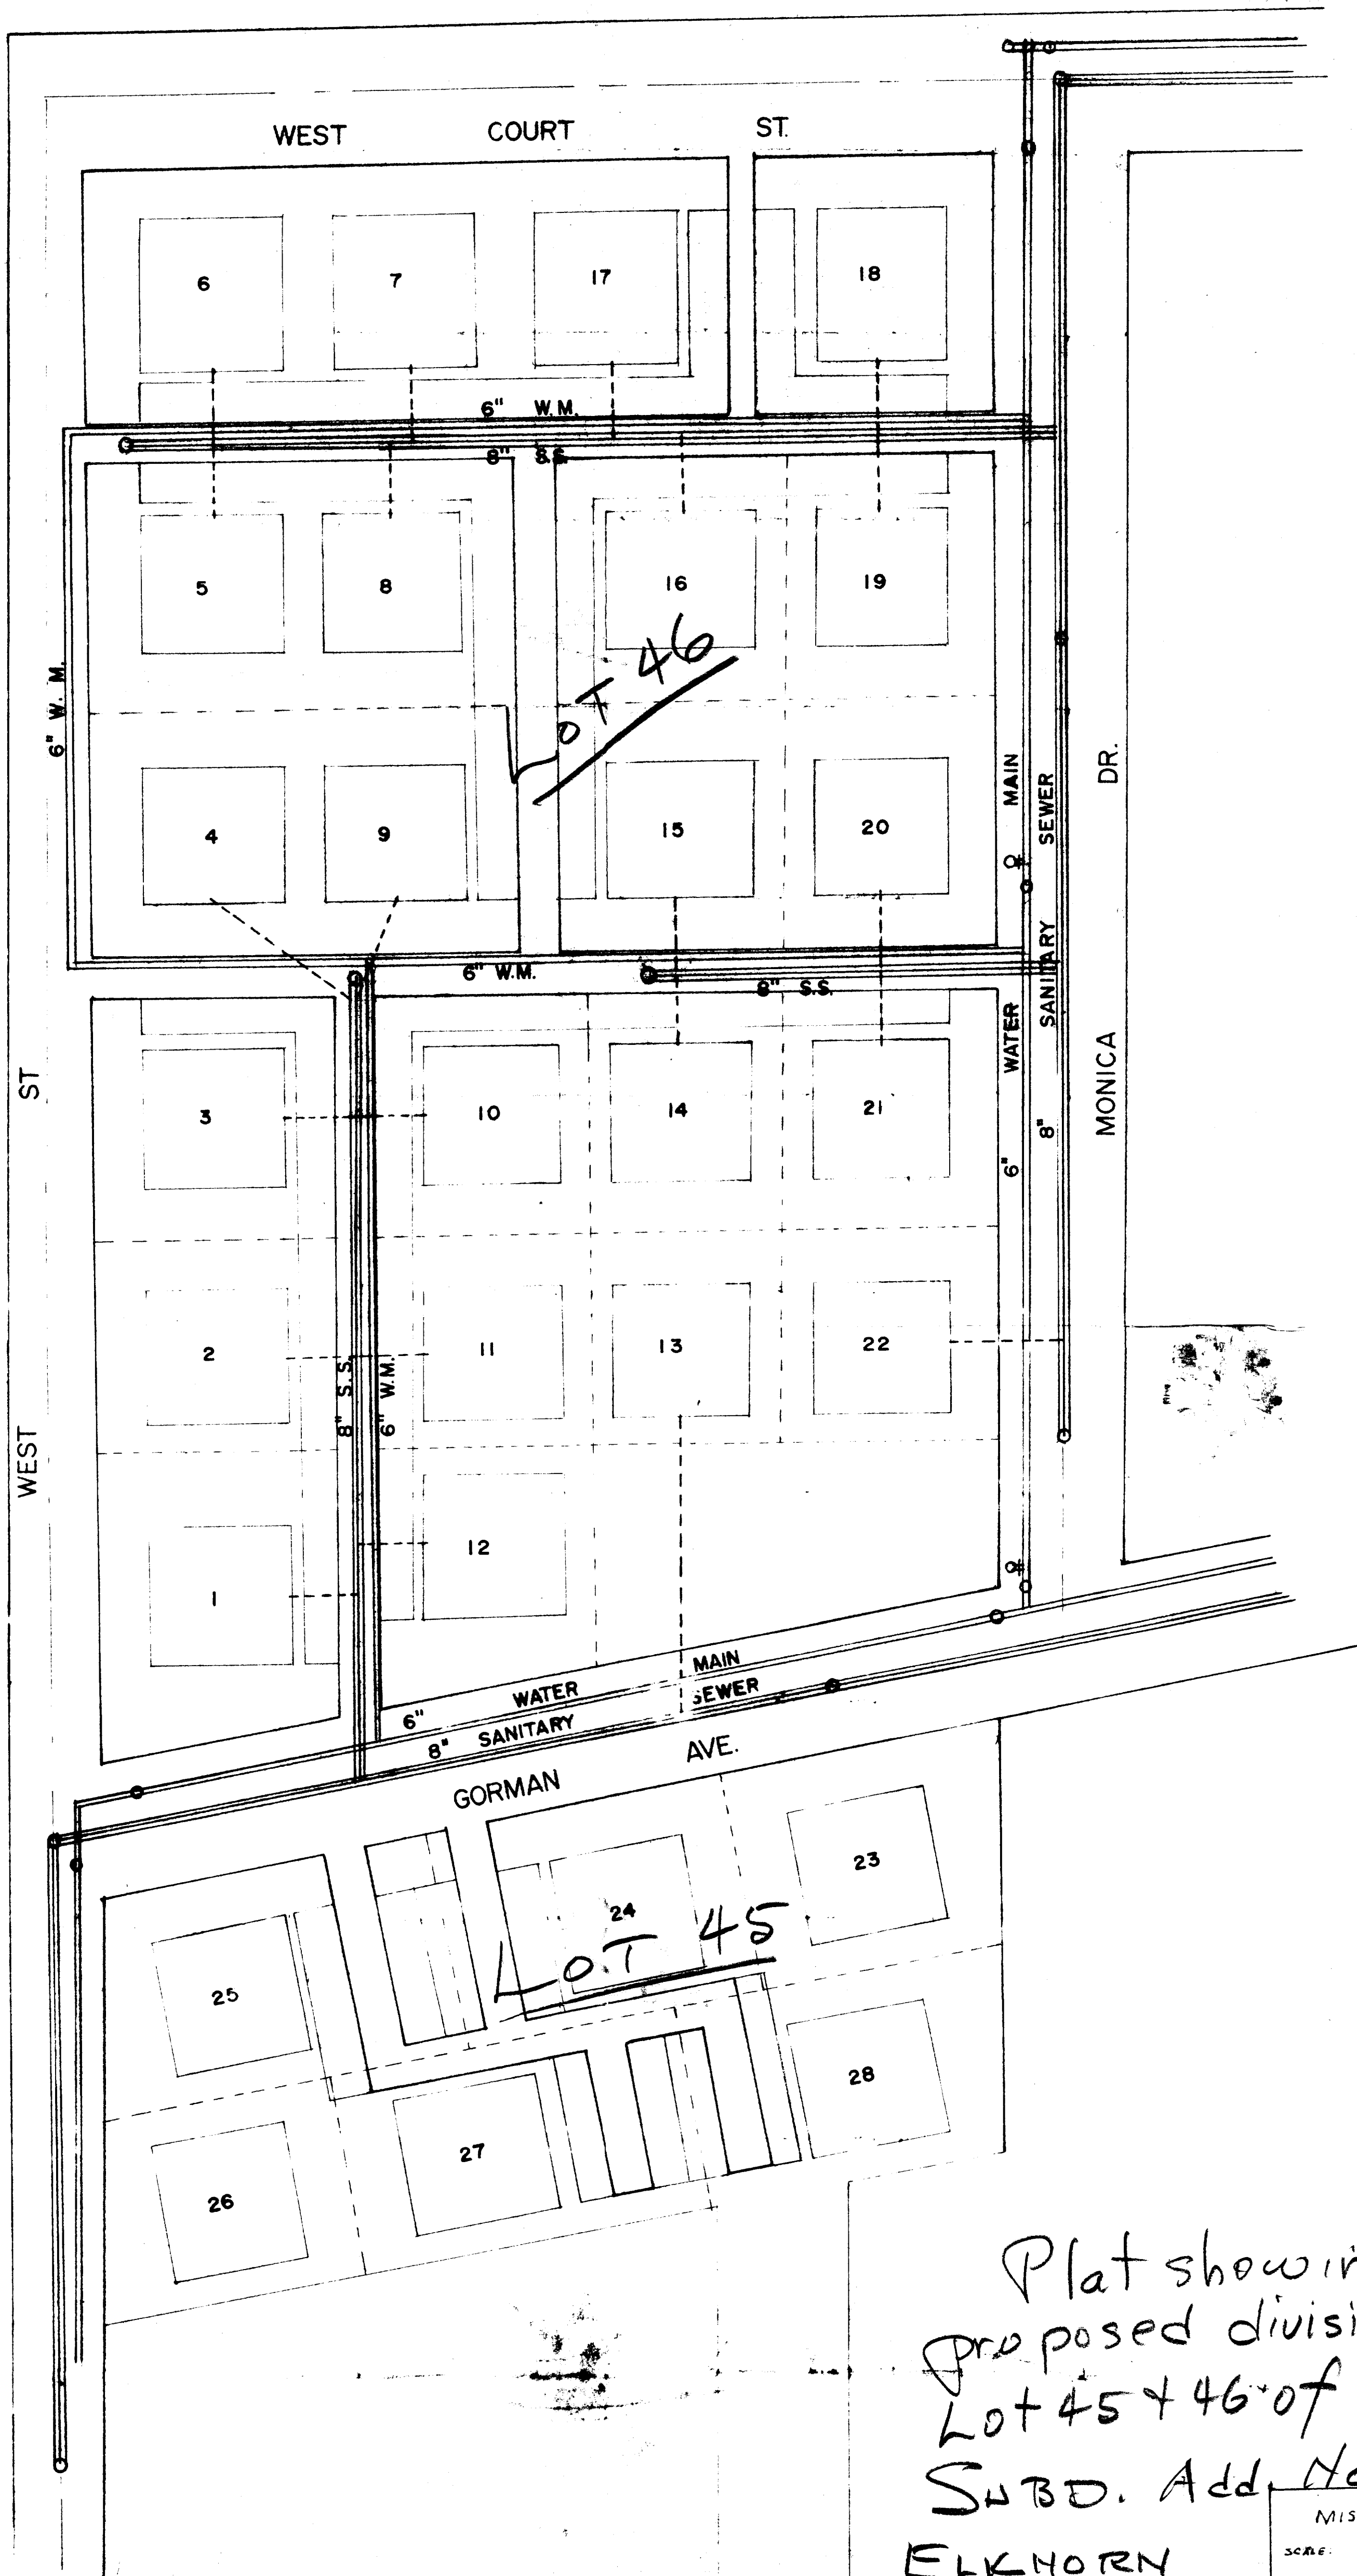

Plat showing
proposed division of
Lot 45 + 46 of Landmark
SUBD. Add. No I

ELKHORN
WIS

MISSION HILLS
SCALE: 1" = 50'
DATE: 7/30/71
DR BY: [signature]