


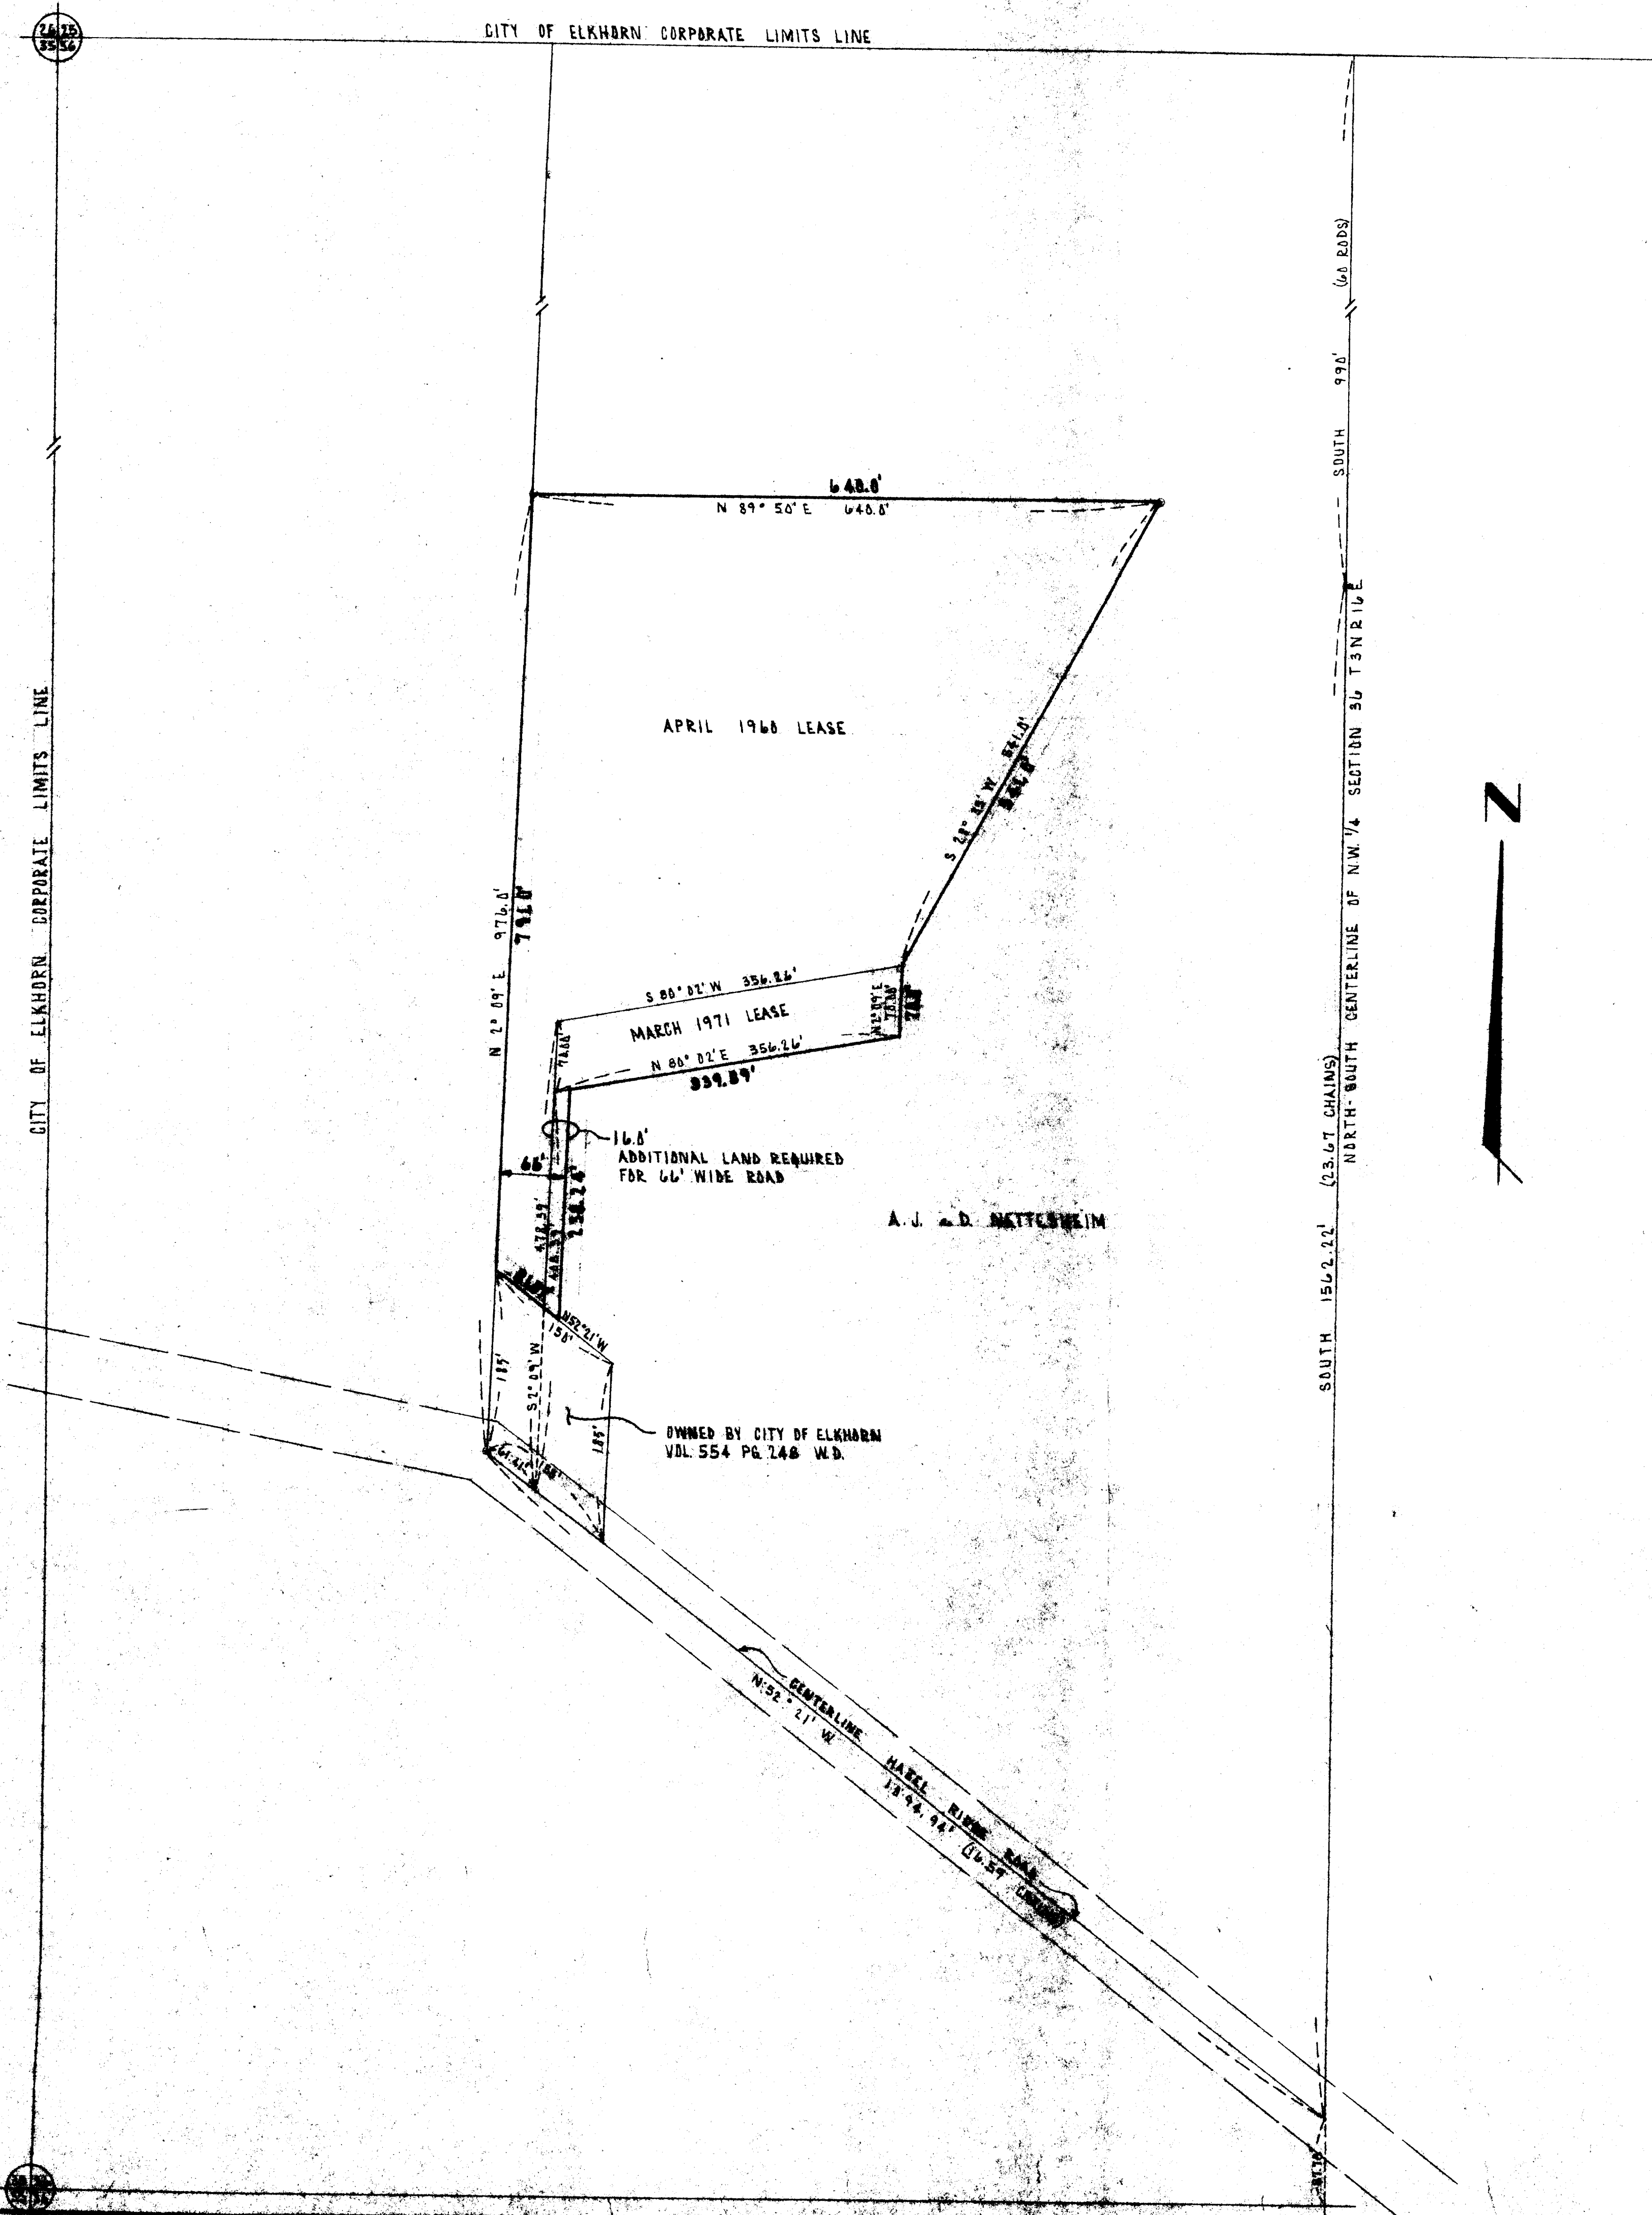

PLAT OF LAND LOCATED IN THE NORTHWEST 1/4 OF SECTION 36, T3N R16E CITY OF ELKHORN, WALWORTH CO., WIS.		
DRAWN BY BILL K.	JENSEN & JOHNSON CIVIL ENGINEERS ELKHORN, WIS.	SCALE: 1" = 100' REVISIONS SHEET NO. OF
APPROVED BY 	DATE FEB 13, 1976	