



PLAT OF SURVEY OF LOT 10 BLOCK 31
ROCKWELL'S ADDITION TO THE ORIGINAL PLAT
CITY OF ELKHORN, WALWORTH CO., WISCONSIN

NOTE: MR. TUBBS AS CITY ENG.
RE-SURVEYED ELKHORN AND
FOUND THE OVERLAP UNDERLAP
IN THE BLOCKS AND RECORDED
THE MEAS. IN THE CITY ENG.
RECORDS.

I CERTIFY THAT I HAVE SURVEYED THE
DESCRIBED PROPERTY AND THAT THE PLAT
SHOWN HEREON IS AN ACCURATE SURVEY &
A TRUE REPRESENTATION THEREOF. CORRECTLY
SHOWS THE BOUNDARY LINES OF SAID
PROPERTY & ALL BUILDINGS THEREON
JULY 2, 1979


THOMAS P. A. JENSEN S 1084

JENSEN SURVEYING & MAPPING
ELKHORN, WISCONSIN

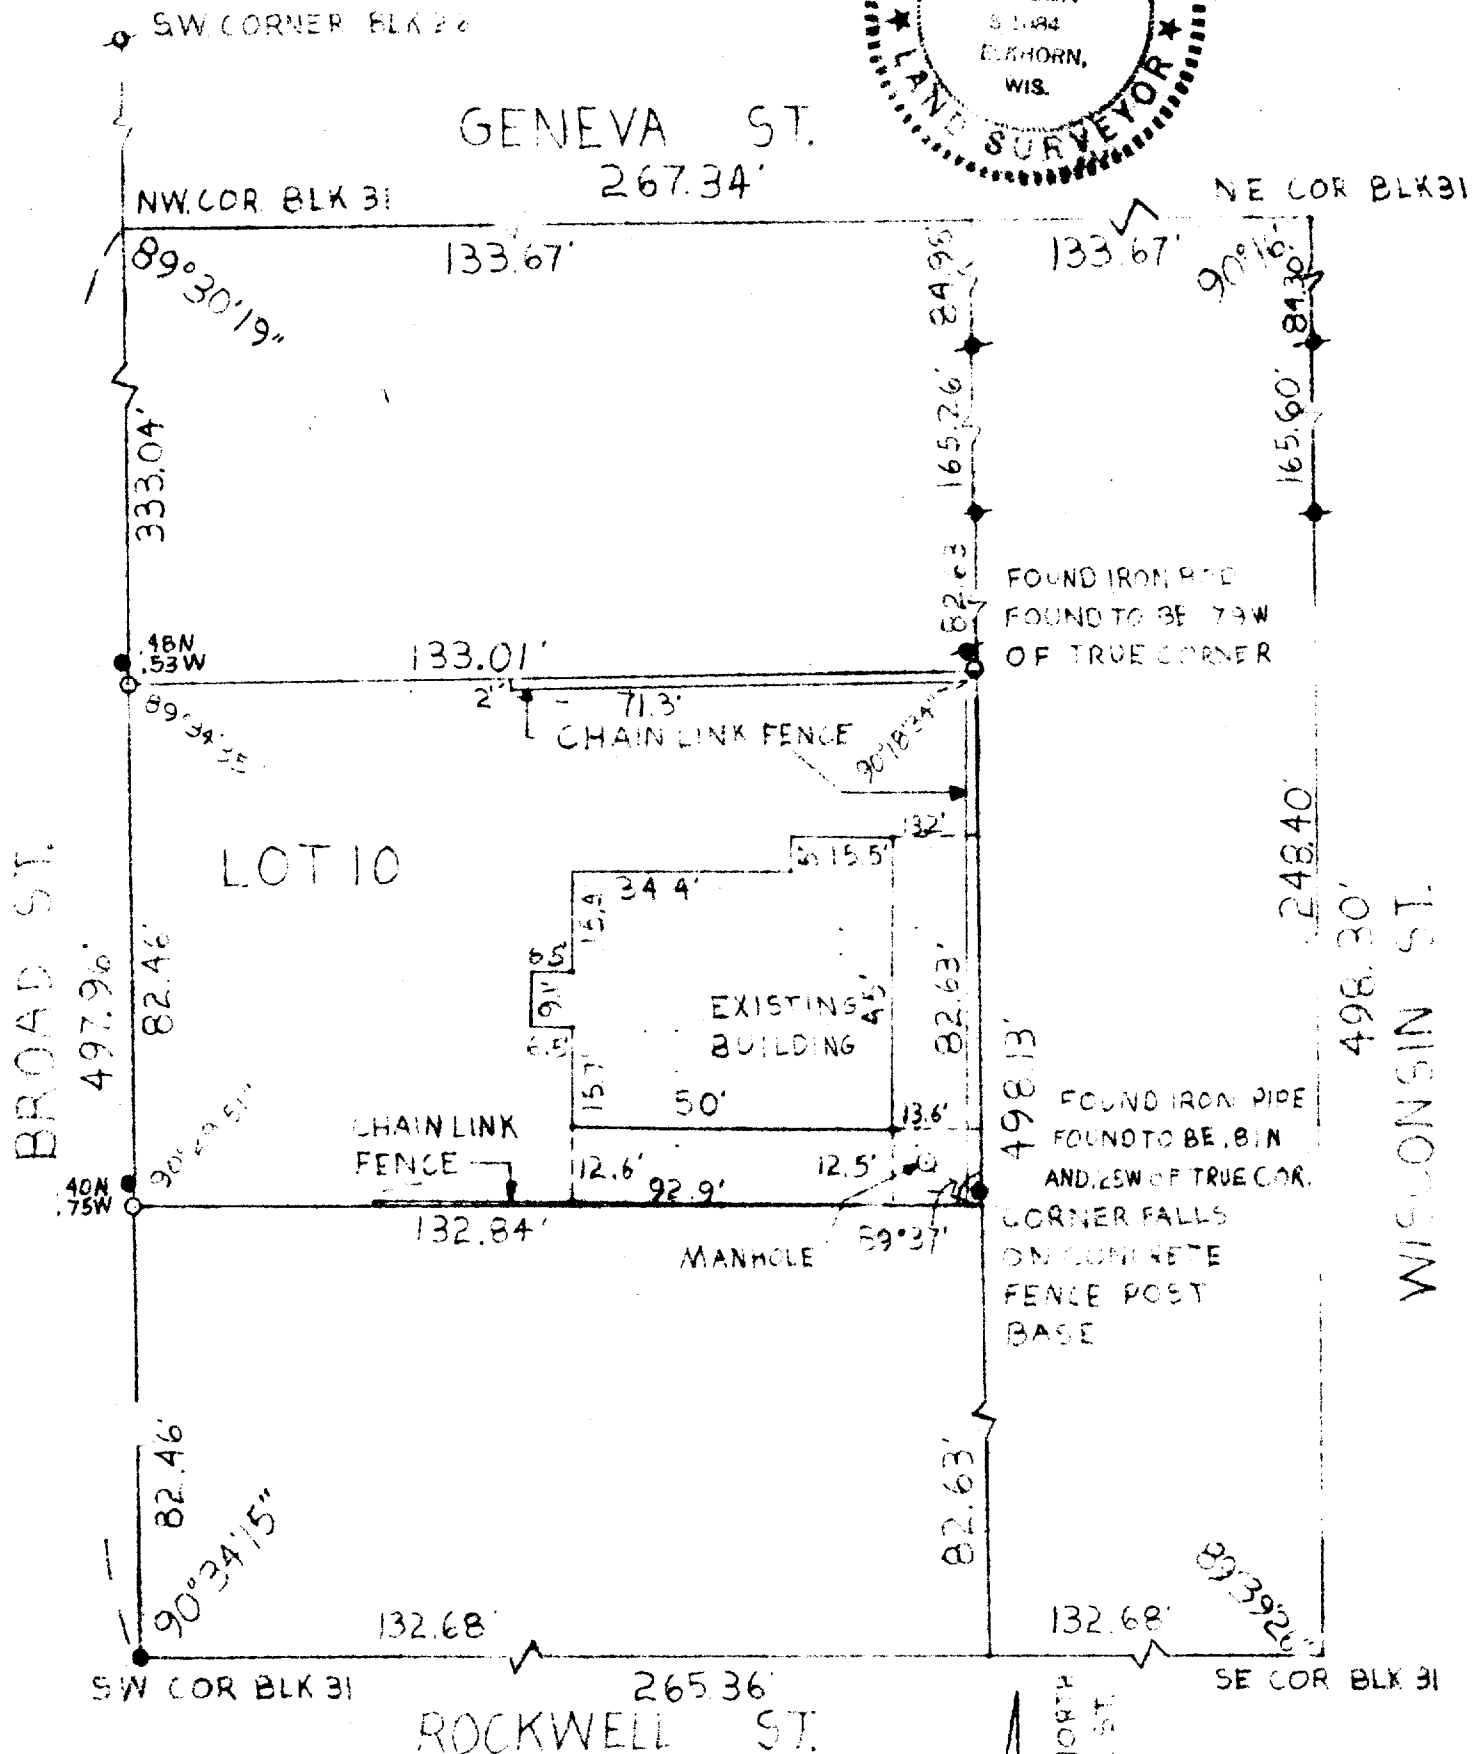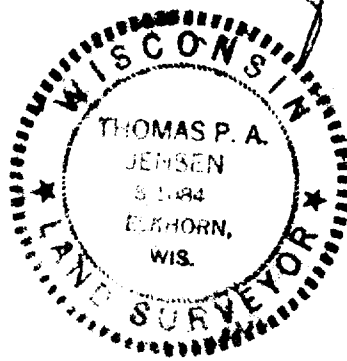

LEGEND

- ~ FOUND 3/4" IRON ROD
- ~ FOUND IRON PIPE
- ~ 24" X 24" IRON PIPE SET
- ~ FOUND IRON PIPE IN CONCRETE

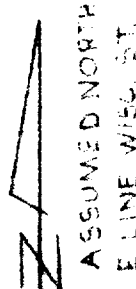

SCALE 1"=30'

1979.038 #4-293