
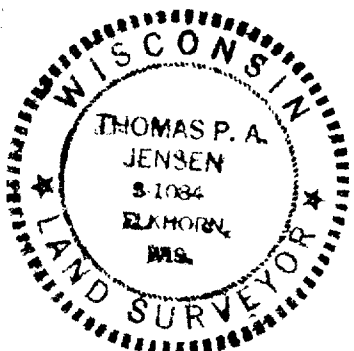


I CERTIFY THAT I HAVE SURVEYED THE ABOVE
DESCRIBED LAND AND LOCATED A PROPOSED
HOUSE THEREON.

APR. 25, 1979

-JENSEN SURVEYING
E
MAPPING
ELKHORN, WIS.

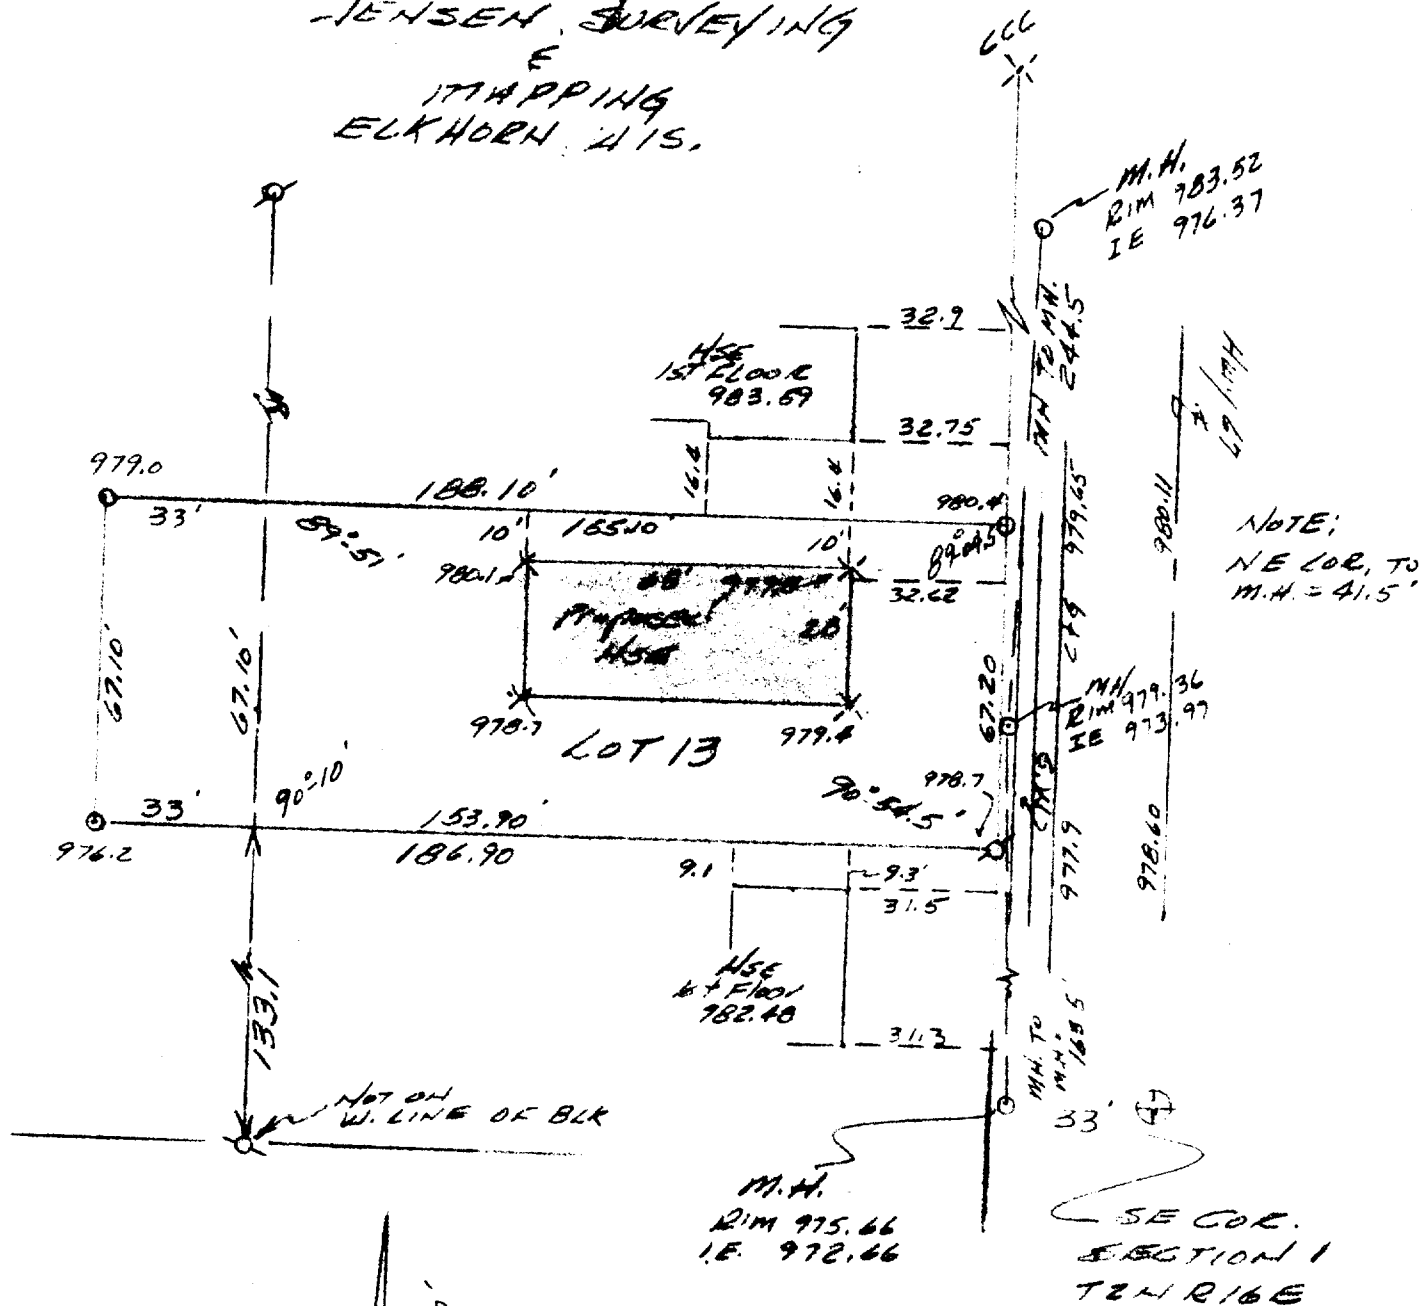

O - IRON PIPE SET
Q - IRON PIPE FD.
X - WOOD STK

NOTE: CONTRACTOR TO GET
APPROVAL FROM CITY
ENG. & BLDG INSPECTOR
FOR USE GRADE.

BM - 458 SEWER MAN HOLE
RIM - ELEV. 979.36